QIDDIYA DEVELOPMENT COMPANY					
DOCUMENT NUMBER:	QDC-ADM-TEM-QMS-00007	REVISION NUMBER:	0D	ISSUED BY:	PMO
DOCUMENT TITLE	MIR FORM	DOCUMENT TYPE:	FORM	DATE ISSUED:	MAY-08-2022

Qiddiya

MATERIAL INSPECTION REQUEST (MIR) FORM

Contractor:	HAIF COMPANY
Project:	QPMO-410-CT-00618- ROAD ACCESS TO RESORT CORE
Contract No.:	QI09043311-VO-0004
Material Inspection Request Number:	QRXM114000-HFC-TEC-MIR-ITS-02-RO5-00022

Haif Company | Freyssinet | HAIF-FREYSSINET JV

Discipline

Architecture	☐	Mechanical	☐	Information Technology	☐	Quality	☐	Project Controls	☐
Civil/Structural	☑	Electrical	☐	Landscape	☐	Safety	☐	Construction Management	☐
Other	☐								

MATERIAL DESCRIPTION

Inspection / Test Location:	INTERIM ROAD MAIN LINE-02		
Material Name:	Traffic Signal Head And Bush Button	Quantity:	432 Pcs.
P.O Number		Delivery Note Number:	TTSDN-HAIF-290726-031
Approved Material Transmittal Number: (Aconex document Approval)	QRXM114000-HFC-TEC-MAT-ITS-02-RO5-00014	Approval Date:	
Inspection Date:	21-Sep-2026	Inspection Start Time:	10:00 AM
ITP:	QRXM114000-HFC-TEC-ITP-ITS-02-RO5-00006	Checklist:	HFC-CKL-9001
Spec's / Dwg. Ref.:	TRAFFIC TECH SECURITY W.L.L	Approved Method Statement Number:	
Attachments:	Test Certificate: ◉ Yes ○ No		
	IFC / Shop Drawings: ○ Yes ◉ No		

DESCRITPTION OF MATERIAL

Vehicular Signal head, Aluminum housing, Standard Type Left arrow Indicator (21 Pcs.) Vehicular Signal head, Aluminum housing, Standard Type Right arrow Indicator (29 Pcs.) Vehicular Signal head, Aluminum housing, Through arrow Indicator (28 Pcs.) Vehicular Signal head, Aluminum housing, Standard (Circular)Type (04 Pcs.) Pedestrain Countdown signal heads, Aluminium Housing, Standrd Type (58 Pcs.) Push Button Unit (58 Pcs.) Arrow mask for signal head 300mm (234 Pcs.) Interim Road Main Line-02

CONTRACTOR - QUALITY INSPECTOR - INITIAL INSPECTION FINDINGS:

Are Complete Details Mentioned in P.O and Delivery Note?	◉ YES ○ NO	REMARKS	
Complies with Approved ITPs/Checklists?	◉ YES ○ NO	REMARKS	
Signs of Physcial Damage?	○ YES ◉ NO	REMARKS	
Conforms to Approved Material Submittal?	○ YES ○ NO	REMARKS	

Accepted:	◉
Accepted with Comments:	○
Rejected (See Remarks):	○

REMARKS:					
Name:	Moataz Elkhateeb	Signature:		Date:	21-09-2026

QIDDIYA / SUPERVISION CONSULTANT QC INSPECTOR - FINAL INSPECTION FINDINGS:

Contractor Has complied with Material requirements?	○ YES ○ NO	Materials Are Stored correctly?	○ YES ○ NO ○ NA

Accepted:	○
Accepted with Comments:	✓
Rejected (See Remarks):	○

REMARKS:	*Submit "CRS" Ref.No. "QRXM114000-HFC-TEC-CRS-ITS-02-RO5-00002_02" Addressing all Comments therein. *Final approval Subject to Successful Completion of TSC.				
Name:	Mahmoud McKky	Signature:		Date	29.9.26

FOR DETAILED MATERIAL INSPECTION STATUS, PLEASE SEE ATTACHED CHECKLIST.
CHECKLISTS THAT ARE NOT ATTACHED AND SIGNED BY SUPERVISION CONSULTANT WILL VOID THIS INSPECTION REQUEST.

This document is the property of Qiddiya Development Company, 2022

Attach the said CRS to the MIR

Approved Code "B"

Client:	Consultant:	Contractor:
Qiddiya	Zuhair Fayez Partnership	Haif Company / Freyssinet — HAIF-FREYSSINET JV

TECHNICAL DOCUMENTS

Project Name: Package 3 - **Interim Road Access to Resort Core**	**Project Code:** QRXM114000
Location: 00	**Date:** 31-March-2026
Document Title:**Material Approval Request FOR ITS SYSTEM SUPPLYING & INSTALLING BY TRAFFIC TECH SECURITY W.L.L** (Traffic Signal Head)	**Ref No:** QRXM114000-HFC-TEC-MAT-ITS-02-RO5-00014
	Rev No: 03

Department: ☐ Architectural ☐ Structural ☐ Electrical ☐ Mechanical ☑ ITS ☐ Civil

Type: ☐ Pre-Qualification ☐ Method Statement ☒ Material Submittal ☐ Sample ☐ Other

Document Description:Material Approval Request FOR ITS SYSTEM SUPPLYING & INSTALLING BY TRAFFIC TECH SECURITY W.L.L (Traffic Signal Head)

Doc. Ref. No.	Title
QRXM114000-HFC-TEC-MAT-ITS-02-RO5-00014	**Material Approval Request FOR ITS SYSTEM SUPPLYING & INSTALLING BY TRAFFIC TECH SECURITY W.L.L (Traffic Signal Head)**

Enclosure:

Submitted By:	**Received By:**
Name: **Eng. Moataz** Signature: Date: 31-Mar -2026	Name: Signature: Date:

Below portion for Consultant Supervision use only

Status: ☐A- Approved ☐B- Approved as noted ☐C- Revise & Resubmit ☐R- For information only

Comments: For comments refer to the CRS

B: Approved with Comments
Mohammed Yasir Khadima Ali
Zuhair Fayez Partnership Consultants
Riyadh , Saudi Arabia

B: Approved with Comments
Zuhair Fayez Partnership Consultants
Riyadh , Saudi Arabia

B: Approved with Comments
Zuhair Fayez Partnership Consultants

Below portion for Client use only

Comments:

Signed by: Signature: Date:

Client:	Consultant:	Contractor:
Qiddiya	Zuhair Fayez Partnership	Haif Company / Freyssinet — HAIF-FREYSSINET JV

TECHNICAL DOCUMENTS

Project Name: Package 3 - Interim Road Access to Resort Core	**Project Code:** QRXM114000
Location: 00	**Date:** 4 -June-2026
Document Title: **Inspection & Test Plan for Inteligent Transportation System Works for TRAFFIC SIGNAL SYSTEM**	**Ref No:** QRXM114000-HFC-TEC-ITP-ITS-00006
	Rev No: 00

Department: ☐ Architectural ☐ Structural ☒ Electrical ☐ Mechanical ☐ Authority ☐ Civil

Type: ☐ Pre-Qualification ☐ Method Statement ☐ Material Submittal ☐ Sample ☒ ITP

Document Description: This is Inspection&Test Plan for Inspection&Test Plan for Inteligent Transportation system Works for TRAFFIC SIGNAL SYSTEM

Doc. Ref. No.	Title
QRXM114000-HFC-TEC-ITP-ITS-00005	**Inspection&Test Plan for Inteligent Transportation system Works for TRAFFIC SIGNAL SYSTEM**

Enclosure:

Submitted By:	**Received By:**
Name: Eng. Moataz Signature: Date: 4 -June-2026	Name: Signature: Date:

Below portion for Consultant Supervision use only

Status: ☐A- Approved ☐B- Approved as noted ☐C- Revise & Resubmit ☐R- For information only

Comments: All the work shall be carried out inaccordance with project specification, relevant standards & codes and manufacturer recommendations.

A: Approved
Zuhair Fayez Partnership Consultants
Riyadh , Saudi Arabia

A: Approved
Saud Nawab
Zuhair Fayez Partnership Consultants
Riyadh , Saudi Arabia

A: Approved
Zuhair Fayez Partnership Consultants
Riyadh , Saudi Arabia

Below portion for Client use only

Comments:

Signed by: Signature: Date:

HAIF-FSA JV Inspection & Test Plan					I &TP		APPROVED DATE	DISCIPLINE ITS
Inteligent Transportation System Works for TRAFFIC SIGNAL SYSTEM					HFC-ITP-090			
PROJECT TITLE:WES Access Road To Resort Core (RA2RC)					CONTRACTOR/SUBCONTRACTOR			
WIR No.					CONSTRUCTION- Intelligent Transportation System Works for TRAFFIC SIGNAL SYSTEM		HAIF	

ITEM NO.	PROJECT PHASE	TASK / ACTIVITY	Quality Requirements /references/ specifications	Quality Record	INSPECTION RESPONSIBILITY ASSIGNMENTS			REMARKS
					Contractor	Third Party	Consultant	
1.0 DOCUMENT REVIEW								
1.1		Material Approval & Shop Drawing - Emergency Vehicle Detection System	QRXP117115-DAH-VORA2R-SPE-INF-R1-Z00000-000001-0B Section 137780 Emergency Vehicle Detection System IFC Drawings QRXP117115-DAH-VORA2R-DWG-ITS-R3-Z00000-2000001 QRXP117115-DAH-VORA2R-DWG-ITS-R3-Z00000-2000002 QRXP117115-DAH-VORA2R-DWG-ITS-R3-Z00000-2000003	QRXM114000-HFC-TEC-MAT-ITS-02-R05-00009 Material Approval Request for EMERGENCY VEHICLE PREEMPTION SYSTEM Approved SHOP DRAWINGS QRXP117115-DAH-VORA2R-DWG-ITS-R3-Z00000-2000001 QRXP117115-DAH-VORA2R-DWG-ITS-R3-Z00000-2000002 QRXP117115-DAH-VORA2R-DWG-ITS-R3-Z00000-2000003	R		H	
1.2		Material Approval & Shop Drawing - Traffic Signal Controller	SHC 306 Section 12.2.3.1 Traffic Signal Controllers IFC Drawings QRXP117115-DAH-VORA2R-DWG-ITS-R3-Z00000-2000001 QRXP117115-DAH-VORA2R-DWG-ITS-R3-Z00000-2000002 QRXP117115-DAH-VORA2R-DWG-ITS-R3-Z00000-2000003	QRXM114000-HFC-TEC-MAT-ITS-02-R05-00007 Material Approval Request for TRAFFIC SIGNAL CONTROLLER Approved SHOP DRAWINGS: QRXP117115-DAH-VORA2R-DWG-ITS-R3-Z00000-2000001 QRXP117115-DAH-VORA2R-DWG-ITS-R3-Z00000-2000002 QRXP117115-DAH-VORA2R-DWG-ITS-R3-Z00000-2000003	R		H	
1.3		Material Approval & Shop Drawing - Transit Signal Priority System	QRXP117115-DAH-VORA2R-SPE-INF-R1-Z00000-000001-0B Section 137750 TRANSIT SIGNAL PRIORITY SYSTEM IFC Drawings QRXP117115-DAH-VORA2R-DWG-ITS-R3-Z00000-2000001 QRXP117115-DAH-VORA2R-DWG-ITS-R3-Z00000-2000002 QRXP117115-DAH-VORA2R-DWG-ITS-R3-Z00000-2000003	QRXM114000-HFC-TEC-MAT-ITS-02-R05-00011 Material Approval Request for TRANSIT SIGNAL PRIORITY SYSTEM Approved SHOP DRAWINGS: QRXP117115-DAH-VORA2R-DWG-ITS-R3-Z00000-2000001 QRXP117115-DAH-VORA2R-DWG-ITS-R3-Z00000-2000002 QRXP117115-DAH-VORA2R-DWG-ITS-R3-Z00000-2000003	R		H	

HAIF-FSA JV Inspection & Test Plan					I &TP		APPROVED DATE	DISCIPLINE ITS
Inteligent Transportation System Works for TRAFFIC SIGNAL SYSTEM					**HFC-ITP-090**			
PROJECT TITLE:WBS Access Road To Resort Core (RA2RC)					CONTRACTOR/SUBCONTRACTOR			
WIR No.					CONSTRUCTION- Intelligent Transportation System Works for TRAFFIC SIGNAL SYSTEM		HAIF	
ITEM NO.	PROJECT PHASE	TASK / ACTIVITY	Quality Requirements /references/ specifications	Quality Record	INSPECTION RESPONSIBILITY ASSIGNMENTS			REMARKS
					Contractor	Third Party	Consultant	
1.0 DOCUMENT REVIEW								
1.4		Material Approval & Shop Drawing - Pedestrian Push Button	SHC 306 Section 12.2.3.3 R Pedestrian Push Button IFC Drawings QRXP117115-DAH-VORA2R-DWG-ITS-R3-Z00000-2000001 QRXP117115-DAH-VORA2R-DWG-ITS-R3-Z00000-2000002 QRXP117115-DAH-VORA2R-DWG-ITS-R3-Z00000-2000003	QRXM114000-HFC-TEC-MAT-ITS-02-R05-00013 Material Approval Request for PEDESTRIAN PUSH BUTTON Approved SHOP DRAWINGS: QRXP117115-DAH-VORA2R-DWG-ITS-R3-Z00000-2000001 QRXP117115-DAH-VORA2R-DWG-ITS-R3-Z00000-2000002 QRXP117115-DAH-VORA2R-DWG-ITS-R3-Z00000-2000003	R		H	
1.5		Material Approval & Shop Drawing - Traffic Signal Head	SHC 306 Section 12.2.1.1 Signalization Equipment IFC Drawings QRXP117115-DAH-VORA2R-DWG-ITS-R3-Z00000-2000001 QRXP117115-DAH-VORA2R-DWG-ITS-R3-Z00000-2000002 QRXP117115-DAH-VORA2R-DWG-ITS-R3-Z00000-2000003	QRXM114000-HFC-TEC-MAT-ITS-02-R05-00014 Material Approval Request for TRAFFIC SIGNAL HEAD Approved SHOP DRAWINGS: QRXP117115-DAH-VORA2R-DWG-ITS-R3-Z00000-2000001 QRXP117115-DAH-VORA2R-DWG-ITS-R3-Z00000-2000002 QRXP117115-DAH-VORA2R-DWG-ITS-R3-Z00000-2000003	R		H	
1.6		Material Approval & Shop Drawing - Traffic Signal Poles and Gantries	SHC 306 Section 12.2.2 Supporting Structure Specifications IFC Drawing QRXP117115-DAH-VORA2R-DWG-GEN-R3-Z00000-5000006	QRXM114000-HFC-TEC-MAT-ITS-02-R05-00015 Material Approval Request for TRAFFIC SIGNAL POLES AND GANTRIES Approved SHOP DRAWINGS: QRXM114000-HFC-DRW-SDW-ITS-02-R05-00019-R02 QRXM114000-HFC-DRW-SDW-ITS-02-R05-00031-R01 QRXM114000-HFC-DRW-SDW-ITS-02-R05-00044-R01	R		H	

HAIF-FSA JV Inspection & Test Plan					I &TP		APPROVED DATE	DISCIPLINE
Inteligent Transportation System Works for TRAFFIC SIGNAL SYSTEM					**HFC-ITP-090**			**ITS**
PROJECT TITLE:WBS Access Road To Resort Core (RA2RC)					CONTRACTOR/SUBCONTRACTOR			
WIR No.					CONSTRUCTION- Inteligent Transportation System Works for TRAFFIC SIGNAL SYSTEM		HAIF	

ITEM NO.	PROJECT PHASE	TASK / ACTIVITY	Quality Requirements /references/ specifications	Quality Record	INSPECTION RESPONSIBILITY ASSIGNMENTS			REMARKS
					Contractor	Third Party	Consultant	
1.0 DOCUMENT REVIEW								
1.7		Material Approval & Shop Drawing - Vehicle Video Detection System	QRXP117115-DAH-VORA2R-SPE-INF-R1-Z00000-000001-0B Section 137714 VEHICLE DETECTION SYSTEM IFC Drawing QRXP117115-DAH-VORA2R-DWG-GEN-R3-Z00000-5000006	QRXM114000-HFC-TEC-MAT-ITS-02-R05-00010 Material Approval Request for VEHICLE VIDEO DETECTION SYSTEM Approved SHOP DRAWINGS: QRXM114000-HFC-DRW-SDW-ITS-02-R05-00019-R02 QRXM114000-HFC-DRW-SDW-ITS-02-R05-00031-R01 QRXM114000-HFC-DRW-SDW-ITS-02-R05-00044-R01	R		H	
2.0 MATERIAL RECEIVING INSPECTION								
2		Material receiving inspection, protection & storage	QD0002-ADM-TEM-QMS00007[0A] MaterialReceiving Inspection in site HFC-CKL-9001	QD0002-ADM-TEM-QMS00007[0A] MaterialReceivingInspection in site HFC-CKL-9001	H		H	MIR to be submitted
3.0 WORK INSTALLATION								
3.1		PRE - INSTALLATION	HFC-CKL-9002	HFC-CKL-9002	H		H	
3.2		INSTALLATION	HFC-CKL-9003	HFC-CKL-9003	H		H	
3.3		TESTING	HFC-CKL-9004	HFC-CKL-9004	H		H	

	GENERAL NOTES
1	Surveillance: QA/QC organization to monitor work in progress without notice from Construction Organization
2	Witness: QA/QC organization shall be notified of the timing of inspection or test in advance. However, the inspection or test shall be performed as scheduled if the QA/QC organization representative is not present
3	Hold: QA/QC organization shall be notified of the timing of inspection or test in advance. Inspection or test shall not be carried out without the QA/QC organization representative in attendance.
4	If the Main Contractor delegates the assigned responsibility to the Subcontractor, then the Main Contractor will have the same degree of responsibility as assigned to Consultant.

LEGEND			
H	Hold Point for QC Inspection/ Test	R	Review of Documents
W	Witness Inspection/T	RH	Review & approval of Documents
S	Surveillance		

Checklist : HFC-CKL-9001	Checklist	APPROVED DATE	DISCIPLINE
Material receiving inspection, protection & storage	HFC-CKL-9001		ITS
PROJECT TITLE: Road Access To Resort Core (RA2RC)			CONTRACTOR/SUBCONTRACTOR
VIR No.	CONSTRUCTION- Intelligent Transportation System Works for INSTALLATION AND OPERATION of TRAFFIC SIGNAL SYSTEM		HAIF

ITEM NO.	Check Points & Acceptance Criteria	Reference	Pass	Fail	Not Applicable	Re-Inspection
1.0	**Material receiving inspection,protection & storage of TRAFFIC SIGNAL SYSTEM**					
A	Deliver, store, and handle products, using means and methods that will prevent damage, deterioration, and loss, including theft and vandalism. Comply with manufacturer's written instructions.	project specification QRXP117115-DAH-VORA2R-SPE-INF-Z00000-000001-0H 1.7 PRODUCT DELIVERY, STORAGE AND HANDLING	✓			
B	Delivery and Handling:		✓			
1.0	Schedule delivery to minimize long-term storage at Project site and to prevent overcrowding of construction spaces.	project specification QRXP117115-DAH-VORA2R-SPE-INF-Z00000-000001-0H 1.7 PRODUCT DELIVERY, STORAGE AND HANDLING	✓			
2.0	Coordinate delivery with installation time to ensure minimum holding time for items that are flammable, hazardous, easily damaged, or sensitive to deterioration, theft, and other losses.	project specification QRXP117115-DAH-VORA2R-SPE-INF-Z00000-000001-0H 1.7 PRODUCT DELIVERY, STORAGE AND HANDLING	✓			
3.0	Deliver products to Project site in an undamaged condition in manufacturer's original sealed container or other packaging system, complete with labels and instructions for handling, storing, unpacking, protecting, and installing.	project specification QRXP117115-DAH-VORA2R-SPE-INF-Z00000-000001-0H 1.7 PRODUCT DELIVERY, STORAGE AND HANDLING	✓			
4.0	Inspect products on delivery to determine compliance with the Contract Documents and that products are undamaged and properly protected.	project specification QRXP117115-DAH-VORA2R-SPE-INF-Z00000-000001-0H 1.7 PRODUCT DELIVERY, STORAGE AND HANDLING	✓			
C	Storage:		✓			
1.0	Provide a secure location and enclosure at Project site for storage of materials and equipment.	project specification QRXP117115-DAH-VORA2R-SPE-INF-Z00000-000001-0H 1.7 PRODUCT DELIVERY, STORAGE AND HANDLING	✓			
2.0	Store products to allow for inspection and measurement of quantity or counting of units.	project specification QRXP117115-DAH-VORA2R-SPE-INF-Z00000-000001-0H 1.7 PRODUCT DELIVERY, STORAGE AND HANDLING	✓			
3.0	Store materials in a manner that will not endanger Project structure.	project specification QRXP117115-DAH-VORA2R-SPE-INF-Z00000-000001-0H 1.7 PRODUCT DELIVERY, STORAGE AND HANDLING	✓			
4.0	Store products that are subject to damage by the elements under cover in a weathertight enclosure above ground, with ventilation adequate to prevent condensation and with adequate protection from wind.	project specification QRXP117115-DAH-VORA2R-SPE-INF-Z00000-000001-0H 1.7 PRODUCT DELIVERY, STORAGE AND HANDLING	✓			
5.0	Protect foam plastic from exposure to sunlight, except to extent necessary for period of installation and concealment.	project specification QRXP117115-DAH-VORA2R-SPE-INF-Z00000-000001-0H 1.7 PRODUCT DELIVERY, STORAGE AND HANDLING	✓			
6.0	Comply with product manufacturer's written instructions for temperature, humidity, ventilation, and weather-protection requirements for storage.	project specification QRXP117115-DAH-VORA2R-SPE-INF-Z00000-000001-0H 1.7 PRODUCT DELIVERY, STORAGE AND HANDLING	✓			
7.0	Protect stored products from damage and liquids from freezing.	project specification QRXP117115-DAH-VORA2R-SPE-INF-Z00000-000001-0H 1.7 PRODUCT DELIVERY, STORAGE AND HANDLING	✓			
8.0	Provide a secure location and enclosure at Project site for storage of materials and equipment by Employer's construction forces. Coordinate location with Employer.	project specification QRXP117115-DAH-VORA2R-SPE-INF-Z00000-000001-0H 1.7 PRODUCT DELIVERY, STORAGE AND HANDLING	✓			

Remarks

PM/Contractor			QDC		
Contractor Construction			Third Party (if applicable)		
The work is ready for inspection			Document Reviewed	Work Inspected	Test Records Verified
Name	Signature	Date	Name	Signature	
IMRAN Muhammad			In advanced meeting	27.09.25	
Contractor QC Inspector			QDC Supervision Consultant		

Form Ref. No. QD0002-ADM-TEM-QTY-00003– Rev.0A

IFSP/ All above listed items are the responsibility of the Contractor following the Project specs & relevant Code

TRAFFIC TECH
www.traffic-tech.com

تقنيات المرور الأمنية ذ.م.م.
TRAFFIC TECH SECURITY W.L.L.

Date: **16-Sep-2026**
Our Ref: **TTSDN-Haif-290726-031**

Delivery Note

To: **HAIF COMPANY** الى:

Ref: **WS045CR-53 (RA2RC – ACCESS ROAD TO RESORT CORE)**

SN	Model No. رقم الموديل	Description الوصـــــف	Unit الوحـدة	Qty الكميـة	Remarks ملاحظـات
MATERIAL SUPPLY (TRAFFIC SIGNALS)					
1		Vehicular signal heads, aluminum housing, standard type Left arrow indicator	PCS	21	
2		Vehicular signal heads, aluminum housing, standard type right arrow indicator	PCS	29	
3		Vehicular signal heads, aluminum housing, Through arrow indicator	PCS	28	
4		Vehicular signal heads, aluminum housing, standard (Circular) type	PCS	4	
5		Pedestrian countdown signal heads, aluminum housing, standard type	PCS	58	
6		Push Button Unit	PCS	58	
7		Arrow mask for signal head 300mm	PCS	234	

Delivered By: EHAB BASLA **Date:** **16-9-2026**

Printed Name & Signature

Received By: **Date:**

Printed Name & Signature

شركة هيف
Haif Contracting
Date
Project. Qiddiya
WS-045CR
Received

Building 8, Floor 6
Olaya Street
P.O. Box 13524
Riyadh, Saudi Arabia

E-mail : ttsa@traffic-tech.com
Web: www.traffic-tech.com
CR No. : 1010882732
VAT No. : 311892040800003

PACKING LIST

No: 467
September 14, 2025

Consignee:	Shipper:
Traffic Tech Security W.L.L Al Olaya Riyadh 12241 Saudi Arabia	Traffic Tech (Gulf) W.L.L 5th Floor, Buzwair Building 53, Zone 25 Rawdat Al Khail Street 330, Al Mansoura P.O. Box 30704, Doha, Qatar

Commodity	:Traffic Signal Head
Mode of Shipment	:Land Freight
Gross Weight	: 2475 kg
No. of Package	: 8 Package
Invoice no	: C 467-2025

Sl	Desc	COO	PACKAGE	SIZE in CM	Weight in KG
1	Traffic Signal Head, push button and spare parts	Austria	1	164x112x142	2475 kg
2	Traffic Signal Head, push button and spare parts	Austria	1	167x112x142	
3	Traffic Signal Head, push button and spare parts	Austria	1	122x80x82	
4	Traffic Signal Head, push button and spare parts	Austria	1	120x120x155	
5	Traffic Signal Head, push button and spare parts	Austria	1	125x120x170	
6	Traffic Signal Head, push button and spare parts	Austria	1	120x120x155	
7	Traffic Signal Head, push button and spare parts	Austria	1	125x125x160	
8	Traffic Signal Head, push button and spare parts	Austria	1	125x125x110	

Best Regards,
Traffic Tech (Gulf) W.L.L

تقنيات المرور (الخليج) ذ.م.م
TRAFFIC TECH
P.O. Box 30704
Doha-Qatar
TRAFFIC TECH (GULF) W.L.L

CERTIFIED
ISO 9001
ISO 14001
ISO 45001

6th Floor, Buzwair Building 53,
Rawdat Al Khail Street 330,
Zone 25 Al Mansoura,
P.O. Box 30704, Doha, Qatar

Tel. : (+974) 44269000
Fax : (+974) 44666832
E-mail : ttg@traffic-tech.com
Web: www.traffic-tech.com

1. Task

Rail Tec Arsenal was commissioned to organise and perform functional tests at high wind speeds on signal heads with mounted backing board acc. NEN standard.

2. General information

The test objects were located in the large climatic wind tunnel of Rail Tec Arsenal on 23.5.2007. Preparatory work and tests were carried out during that day.

A representative of the customer was present during the tests.

The test agenda was co-ordinated with the representative of the customer.

3. Test objects

Signal head ALU STAR 300 mm and ALU STAR 210 mm mounted with backing board acc. NEN-standard with one side fixation of the signal head direct on pole (76 mm)

4. Preparatory work

The test objects were mounted on a pole (produced by the customer) in the climatic wind tunnel (**Figure 1**).

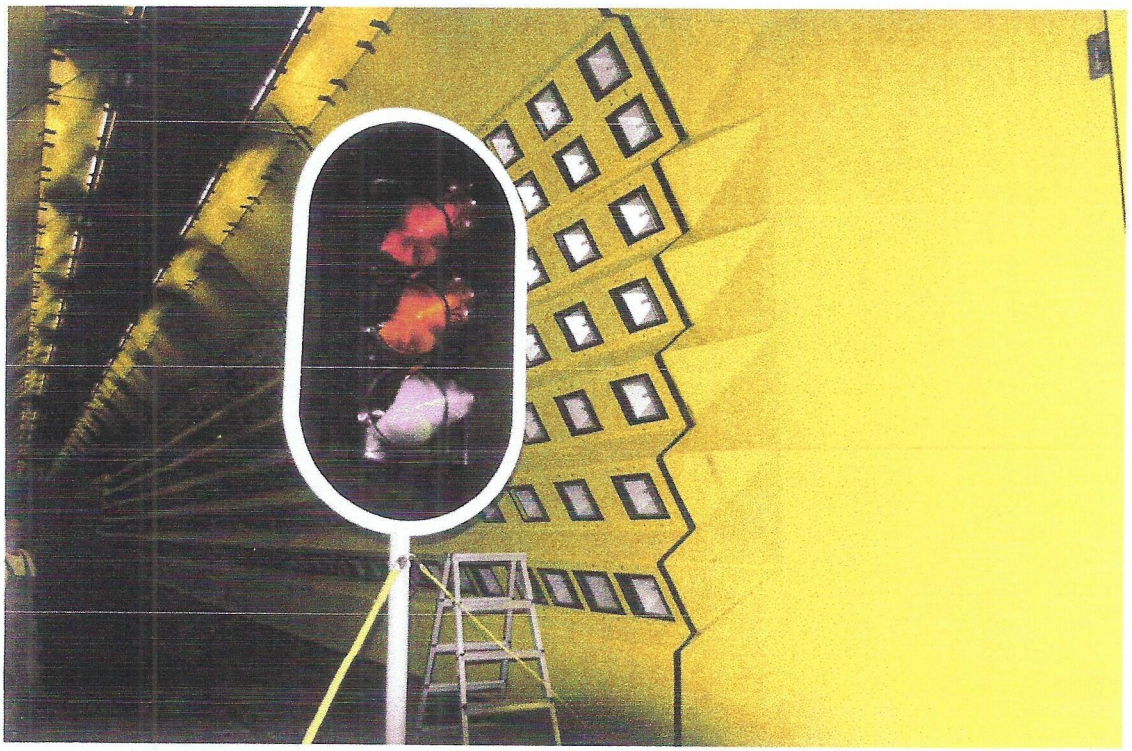

Figure 1: ALU STAR 300 on stand in the climatic wind tunnel

A video camera was used to observe the test objects during the tests.

5. Performance of tests

Two series of tests were carried out for each type:
The first series was with wind speeds up to 160 kph from the front and back side. At the maximum wind speed of 160 kph five minutes of constant wind speed were performed.
The second series was with wind speeds up to 200 kph from the front side. At the maximum wind speed of 200 kph two minutes of constant wind speed were performed.
The average air temperature in the climatic wind tunnel was app. Ta=26°C.

6. Test results

All tests were carried out without any break of the fixing system. After the tests a permanent deformation was detected. Before and after each test the position of the signal transmitter was checked and documented. The following pictures show the documented positions.

ALU STAR 300 wind speed 160 kph from front side (**Figures 2 and 3**)

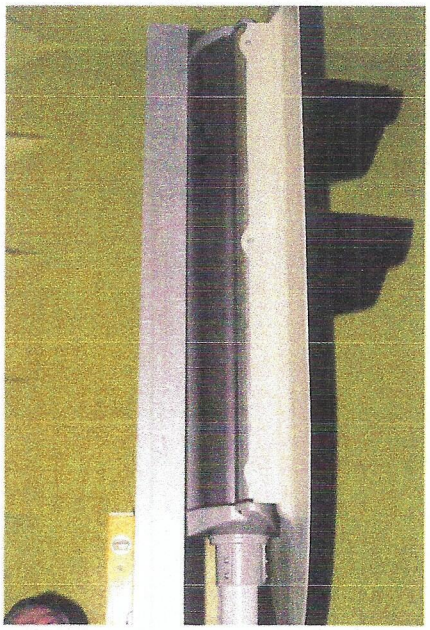

Figure 2: ALU STAR 300 before 160 kph

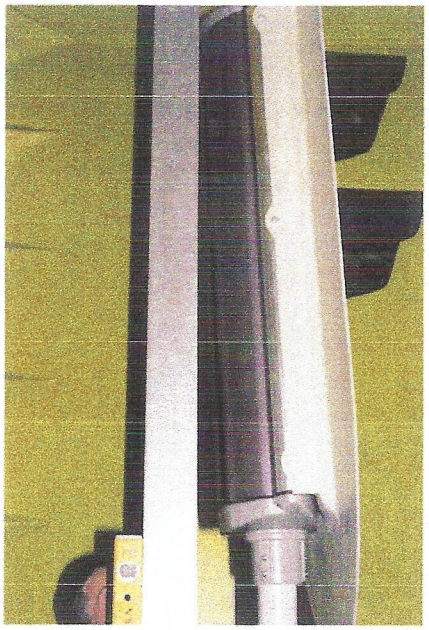

Figure 3: ALU STAR 300 after 160 kph

ALU STAR 300 wind speed 160 kph from back side (**Figures 4 and 5**)

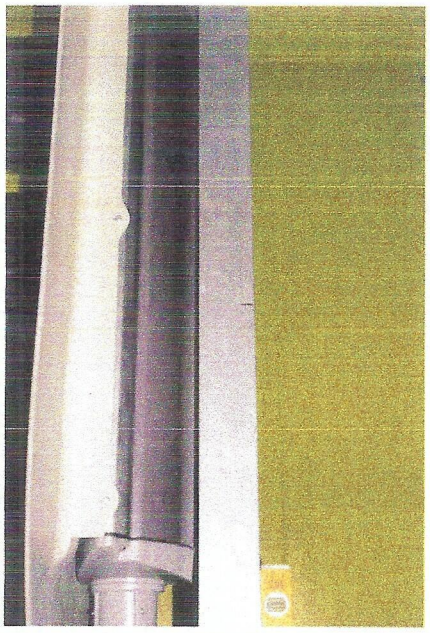

Figure 4: ALU STAR 300 before 160 kph

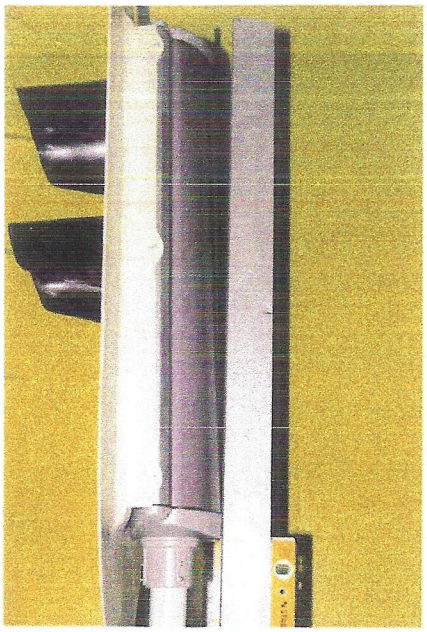

Figure 6: ALU STAR 300 after 160 kph

ALU STAR 300 wind speed 200 kph from front side (**Figures 6 and 7**)

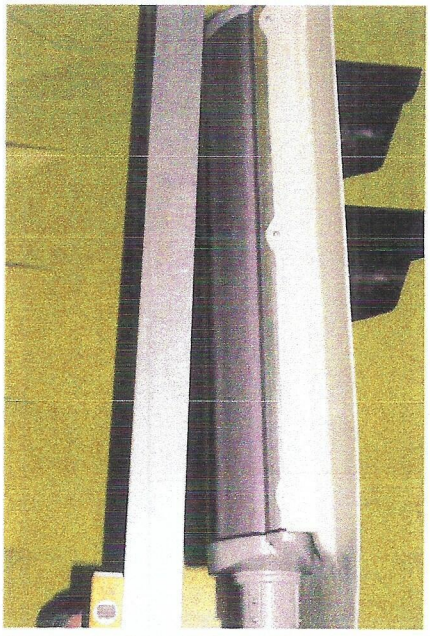

Figure 6: ALU STAR 300 before 200 kph

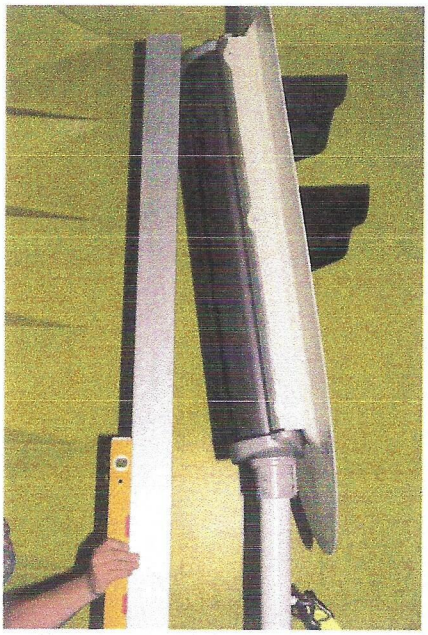

Figure 7: ALU STAR 300 after 200 kph

ALU STAR 210 wind speed 160 kph from front side (**Figures 8 and 9**)

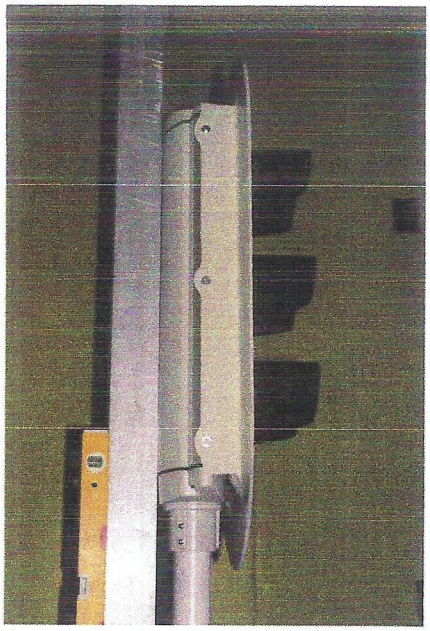

Figure 8: ALU STAR 210 before 160 kph

Figure 9: ALU STAR 210 after 160 kph

ALU STAR 210 wind speed 160 kph from back side (**Figures 10 and 11**)

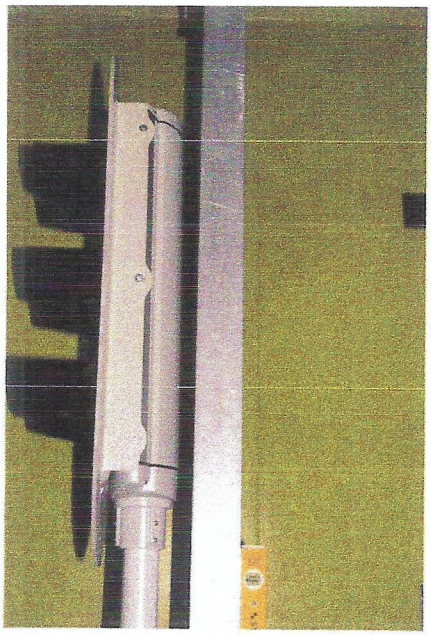

Figure 10: ALU STAR 210 before 160 kph

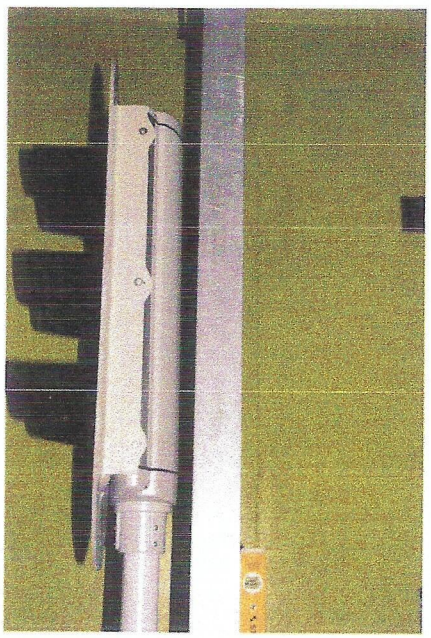

Figure 11: ALU STAR 210 after 160 kph

ALU STAR 210 wind speed 200 kph from front side (**Figures 12 and 13**)

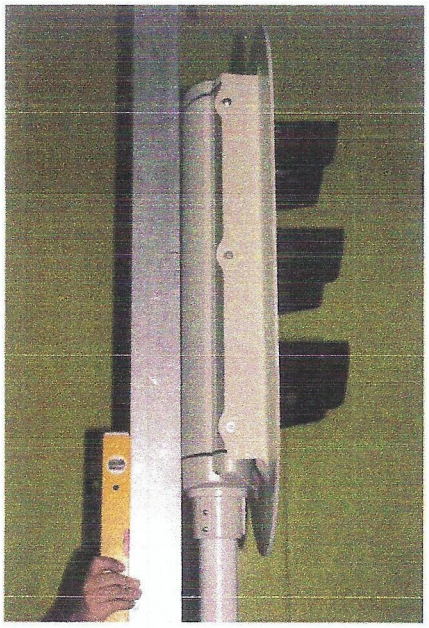

Figure 12: ALU STAR 300 before 200 kph

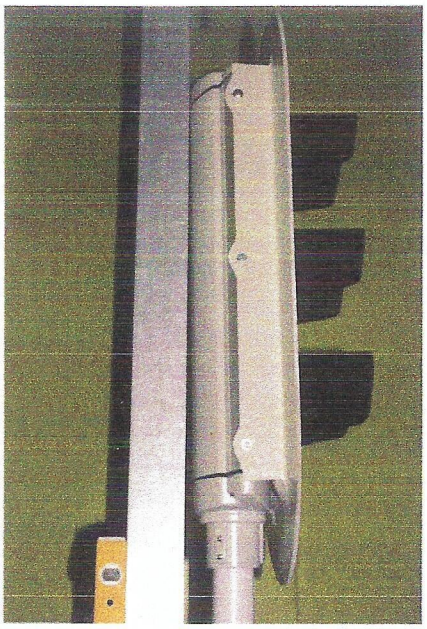

Figure 13: ALU STAR 300 after 200 kph

Dipl.-Ing. G. Haller
Technical Director

Otto Bucek
Project Manager

First in Traffic Solutions

SWARCO FUTURIT
Verkehrssignalsysteme
Ges.m.b.H.

Declaration of "EG" Conformity

The product described below is in conformity with the following European Directives:

Low Voltage Directive 2006/95/EG
EMC Directive 2004/108/EG

Product:	Count Down Signal, CDS V1
Manufacturer:	Swarco Futurit Verkehrssignalsysteme Ges.m.b.H. Mühlgasse 86 A-2380 Perchtoldsdorf AUSTRIA

Applied harmonized standards:

EN 60950-1:2006 + Am 1:2010 + Am 11:2009
EN 55022:2006
EN 55024:1998 + A1:2001 + A2:2003
EN 61000-3-3:2008
EN 61000-3-2:2006 + A1:2009 + A2:2009

This declaration is invalid if the product is used against its regular provision or altered without manufacturer's authorization.

SWARCO FUTURIT
Verkehrssignalsysteme Ges.m.b.H.
A-2380 Perchtoldsdorf, Mühlgasse 86
A-2343 Neutal, Manfred Swarovski-Straße 1
SWARCO I First in Traffic Solutions.

Perchtoldsdorf,
20.01.2011

Michael Schuch
MD Swarco Futurit

Slovenski institut za kakovost in merosloviе
Slovenian Institute of Quality and Metrology

Poročilo o preskusu / Test Report

Št. / No.

T212-0082/08

Datum / Date

2008-03-16

Proizvod / Product

Traffic control equipment - Signal heads
Model: ALU STAR XXX LED YYY
See nomenclature on page 2

Naročnik preskusa / Applicant

Swarco Futurit Verkehrssignalsysteme GmbH
Manfred – Swarovski – Str.1; A-7343; Neutal; Austria

Proizvajalec / Manufacturer

Swarco Futurit Verkehrssignalsysteme GmbH
Manfred – Swarovski – Str.1; A-7343; Neutal; Austria

Blagovna znamka / Trade Mark

FUTURIT

Standardi - predpisi / Standards – regulations

EN 12368:2006, Clause 7

Listov / Pages

5

Vrsta preskusa / Purpose of test

Environmental exposure

Št. merjencev / No. of Items tested

2

Mapa predmeta št. / Subject File No.

C20080256

Kraj preskusa / Place of test

SIQ, Tržaška c. 2,
SI-1000 Ljubljana, Slovenia

Opomba / Remark

/

Zaključek / Conclusion

The equipment under test "Traffic control equipment - Signal heads Model: ALU STAR XXX LED YYY " was exposed to the environmental test in accordance with EN 12368:2006 standard, clause 7. Test conditions are stated in clause 3 of this report. The test findings are stated in clause 4 of this report.
The test results are valid only for samples of product tested! Test was concluded 2008-03-16.

Odgovoren za preskušanje / Responsible for the test
Mirko Čoko

Slovenski institut za kakovost in merosloviе
Slovenian Institute of Quality and Metrology
Tržaška c. 2, 1000 Ljubljana
Slovenija / Slovenia

Direktor področja / Department Manager
Matej Žontar

Izvirnik tega poročila, razen celota, ni dovoljeno / This report shall not be reproduced except in full

1 TEST EQUIPMENT

- Climatic (temperature/humidity) chamber BRABENDER-KSVE 1000/80E controlled by thermo-hydro meter ALMEMO, model 6290-7K (display unit) with FH A646-1 (probe), Ser No. D0205024G (2009-09-19),
- Vibration system DERRITRON-VP 700 /TW36000/DVC1600, ser No. 012 (2008-09-18),
- Piezoelectric accelerometer ENDEVCO, model 213E, ser No. NJ06 (2008-05-08),
- Steel ball of 50mm diameter, weight 0.51kg (2009-08-16),
- Solar chamber SUNTEST XLS+ No. 23-011-IskraEmeco,
- Dust chamber - SIQ (2009-03-24),
- Test device for verification of protection against spraying water - SIQ (2010-02-19)

Note: The date of the recommended recalibration is given for each measuring instrument (in brackets).

2 EQUIPMENT UNDER TEST (EUT)

The Traffic control equipment - Signal headsModel: ALU STAR XXX LED YYY was subjected to the constructional and environmental test methods. The test procedures were conducted in following sequence: Impact, Vibration, IP degrees of protection and Climatic exposures.

2.1 Nomenclature

The test module was ALU STAR XXX LED YYY

"XXX" presents outer diameter of optical units 200 mm and 300 mm.
"YYY" presents rated supply voltage of optical units 230 V~, 42V~ and 40V~.

Subject of testing were the following models:

- three aspect ALU STAR 200 LED 230
- three aspect ALU STAR 300 LED 230

3 TEST CONDITIONS

3.1 Impact test Class IR3 (EN 60598-1:2004; cl.4.13.4)

The test module was cooled to a temperature of -5°C and maintained for three hours and then immediately subjected to three single impacts.The steel ball of 50mm diameter and weight 0,51kg was used for the test and dropped from the height 1.3m.
Conclusion: After the test the no surface cracs were observed on the front lens. On the condenser lens no damage was observed. On the signal head enclosure no damage was observed.

3.2 Random vibrations (EN 60068-2-64:1993)

Vibration parameters:

- Orientation: X, Y, Z-axis,
- Frequency range: 10 ÷200 Hz,
- Frequency 10 ÷ 50Hz; Accel. Spectral. Density: 2 $(m/s^2)^2$/Hz,
- Frequency 50 ÷ 200Hz; ACD 2 $(m/s^2)^2$/Hz with slope –3dB/octave,
- RMS value of acceleration = 12 m/s^2
- Duration of the test: 90 minutes per axis

Fixing of the EUT onto the vibrators machine in Z and Y axis is presented in figures 1.and 2.

Figure 1

Figure 2

3.3 Dust tests-IP5X (IEC 60529, tables 2 and 7, sub-cl. 13.4; 13.5)

-Test chamber (as specified by the standard),
-Dust, used for the test: talcum powder,
-Environmental temperature 24°C,
-No underpressure inside the enclosure,
-Duration of the exposure: 8 hours

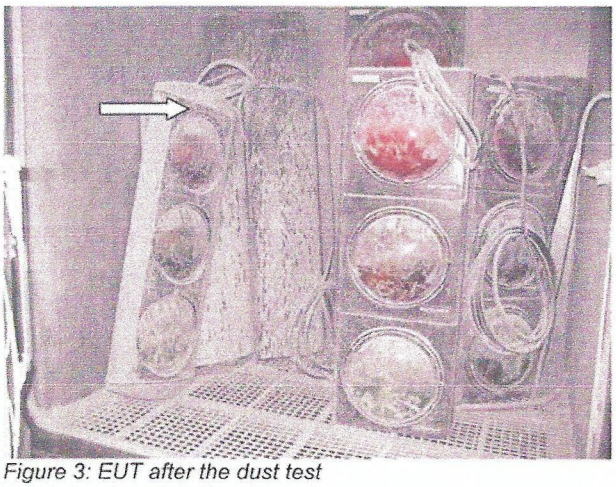

Figure 3: EUT after the dust test

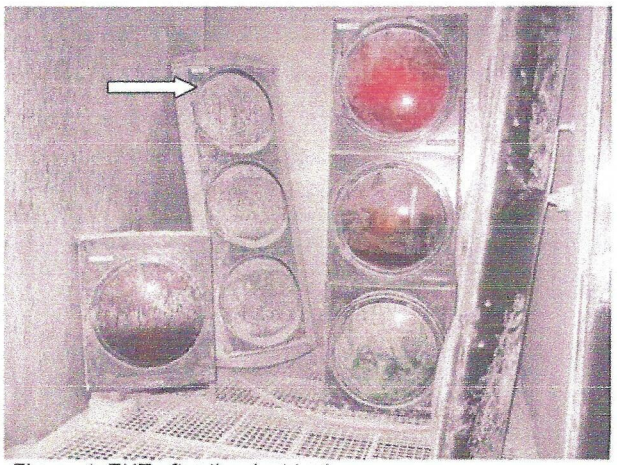

Figure 4: EUT after the dust test

Conclusion: No deterioration or damage of the samples was obtained (visual examination), no cracks were visible.

3.4 Tests for protection against ingress of water-IPX5 (IEC 60529, tables 3 and 8, sub-cl. 14.2.5)

-Test device: spraying nozzle (internal diameter 6.3mm – standard requirement),
-Delivery rate: 12.5 l/min,
- The enclosure was placed on the turntable (one turnover per minute) and sprayed from all practical direction,
-Distance from nozzle to enclosure surface: 3 m,
-Duration of the exposure: 3 minutes

Conclusion: After the exposure was concluded, the visual examination of the sample was performed. Results were obtained as follows:
There were no dust and no water inside the enclosure.

Result: Following the acceptance conditions, the equipment under test sustained the test conditions for IP54 and IP55 degree of protection.

4 RESULTS AND CONCLUSIONS: GENERAL

In no case the operation of the EUT was disturbed by the simulated environmental conditions.

Following the acceptance conditions, the equipment under test sustained the test conditions for IP54 and IP55 degree of protection.

Conclusion: The EUT **sustained** the specified environmental testing according to EN 12368:2006, clause 7.

Testing location:	SIQ Ljubljana, Mašera-Spasićeva ulica 10, SI-1000 Ljubljana, Slovenia.
Remarks:	Date of receipt of test items: 2017-07-10 Number of items tested: 1 Date of performance of tests: 2017-07-11 to 2017-07-14 The test results presented in this report relate only to the items tested. The product complies with the requirements of the testing methods.

Tested by: Mirko Čoko

Approved by: Miha Otrin

The report shall not be reproduced except in full.

SIQ Ljubljana. Tržaška cesta 2, SI-1000 Ljubljana, Slovenia
T +386 1 4778 100, F +386 1 4778 444, info@siq.si, www.siq.si

1 TEST EQUIPMENT

- Dust chamber - SIQ (2017-07-29).
- Spray nozzle IPX5, ID 700 (2018-08-05).
- Test device for verification of protection against spraying water - SIQ (2018-09-23).

Note: The date of the recommended recalibration is given for each measuring instrument (in brackets).

2 EQUIPMENT UNDER TEST (EUT)

Signal head insert, model: Futurled 6 200 mm (Figures 1 to 5) was subjected to test for IP65 degree of protection.

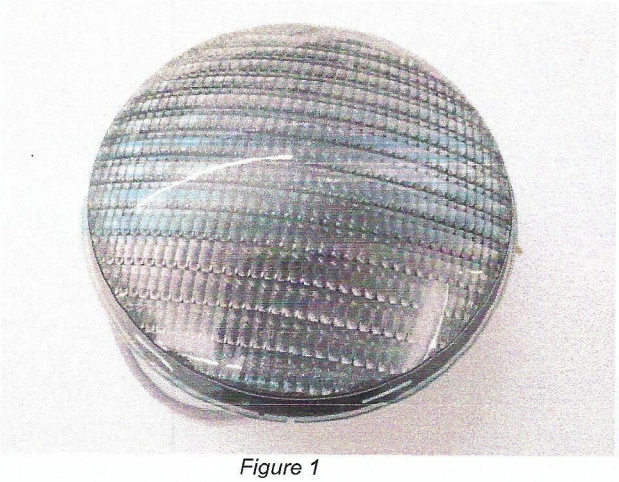

Figure 1

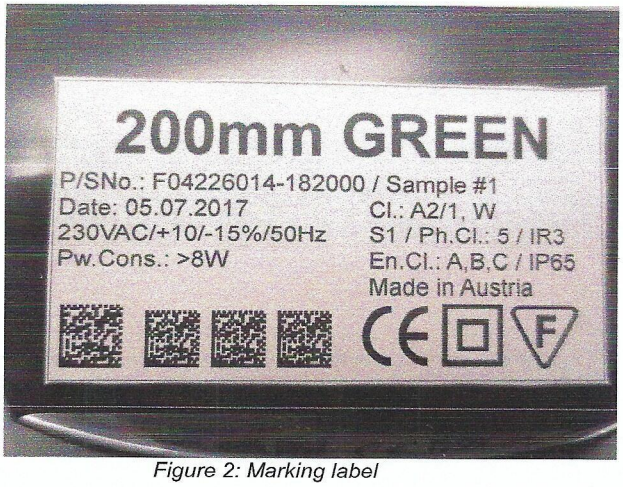

Figure 2: Marking label

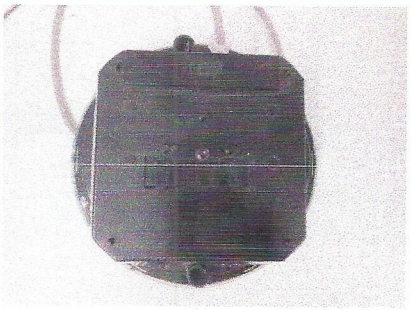

Figure 3

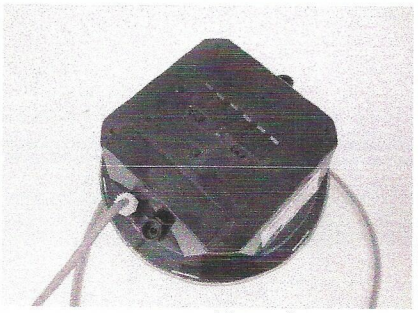

Figure 4

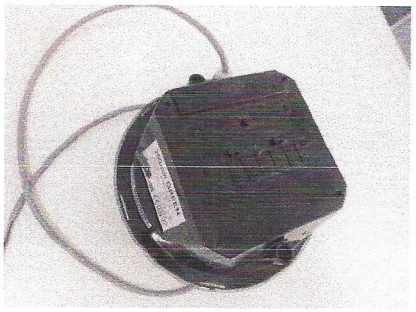

Figure 5

3 TEST CONDITIONS

3.1 Dust test-IP6X (IEC 60529, tables 2 and 7, sub-cl. 13.4; 13.6)

Procedure:

- Dust, used for the test: talcum powder.
- Environmental temperature 23 °C.
- Volume of the sample: 1.6 l.
- Under pressure inside the enclosure: 2 kPa.
- Suction airflow: 0.5 l/h.
- Duration of the exposure: 8 hours.

Figure 6: EUT before the dust test *Figure 7: EUT after the dust test*

Conclusion: There was no dust penetration inside the enclosure of signal insert (Figure 8).

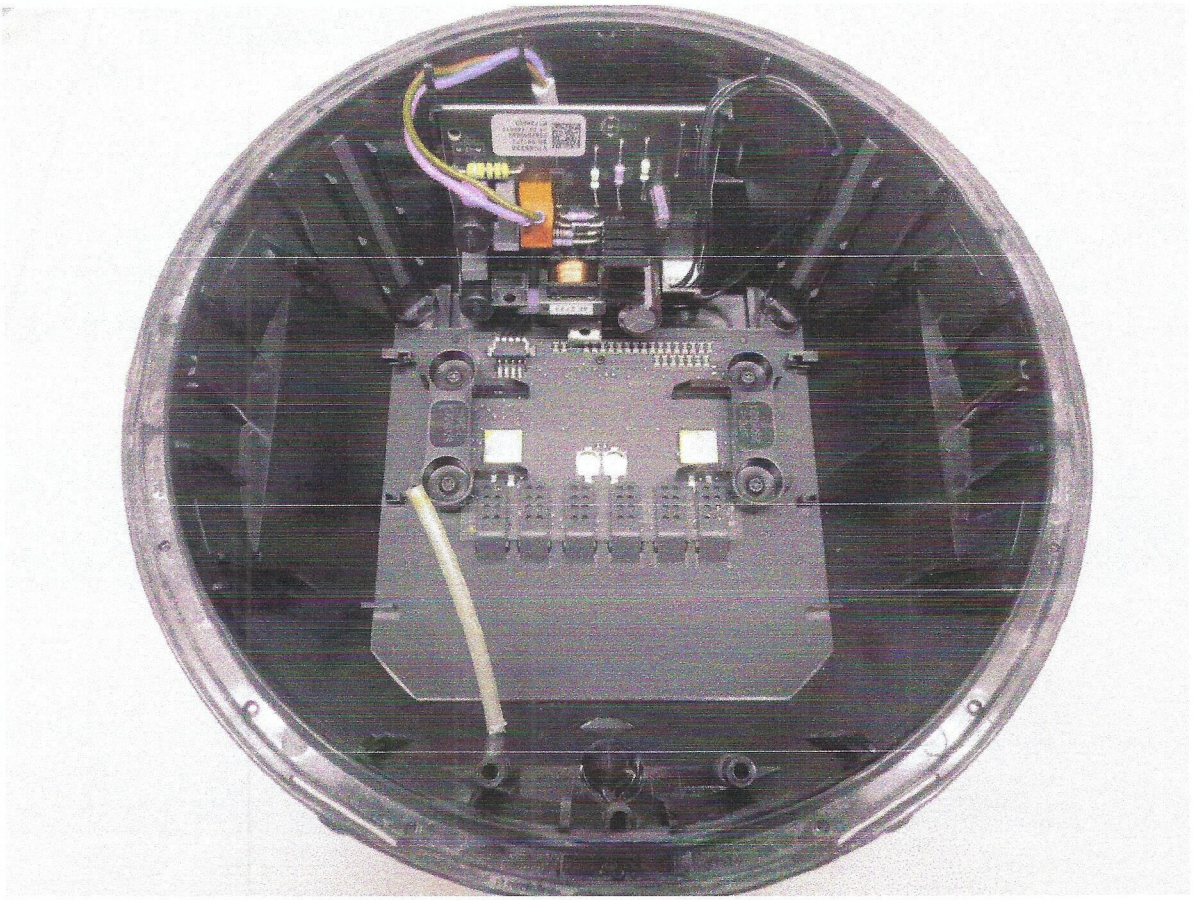

Figure 8

3.2 Test for protection against ingress of water-IPX5 (IEC 60529, tables 3 and 8, sub-cl. 14.2.5)

Procedure:

- Test device: spraying nozzle (internal diameter 6.3 mm – standard requirement).
- Delivery rate: 12.5 ± 0.6 l/min.
- The enclosure was placed on the turntable (one turnover per minute) and sprayed from all practical directions.
- Distance from nozzle to enclosure surface: 3 m.
- Duration of the exposure: 3 minutes.

The Better Way. Every Day.

Compliance of SWARCO FUTURIT Product -family with RoHS Requirements

- Futurled 6
- Futurled E1
- Count Down Signals

RoHS Statement

We confirm, that SWARCO FUTURIT products, from the enclosed product family comply with ,
Directive 2011/65/EU (RoHS 2) and delegated Directive 2015/863 (RoHS 3), restriction of the use of hazardous substances in electrical and electronic equipment"

The Better Way. Every Day.

SWARCO FUTURIT
Verkehrssignalsysteme Ges.m.b.H.
A-2380 Perchtoldsdorf, Mühlgasse 86
A-7343 Neutal, Manfred Swarovski-Straße 1

R. Trummer
Head of Integrated Management Systems
03.07.2023

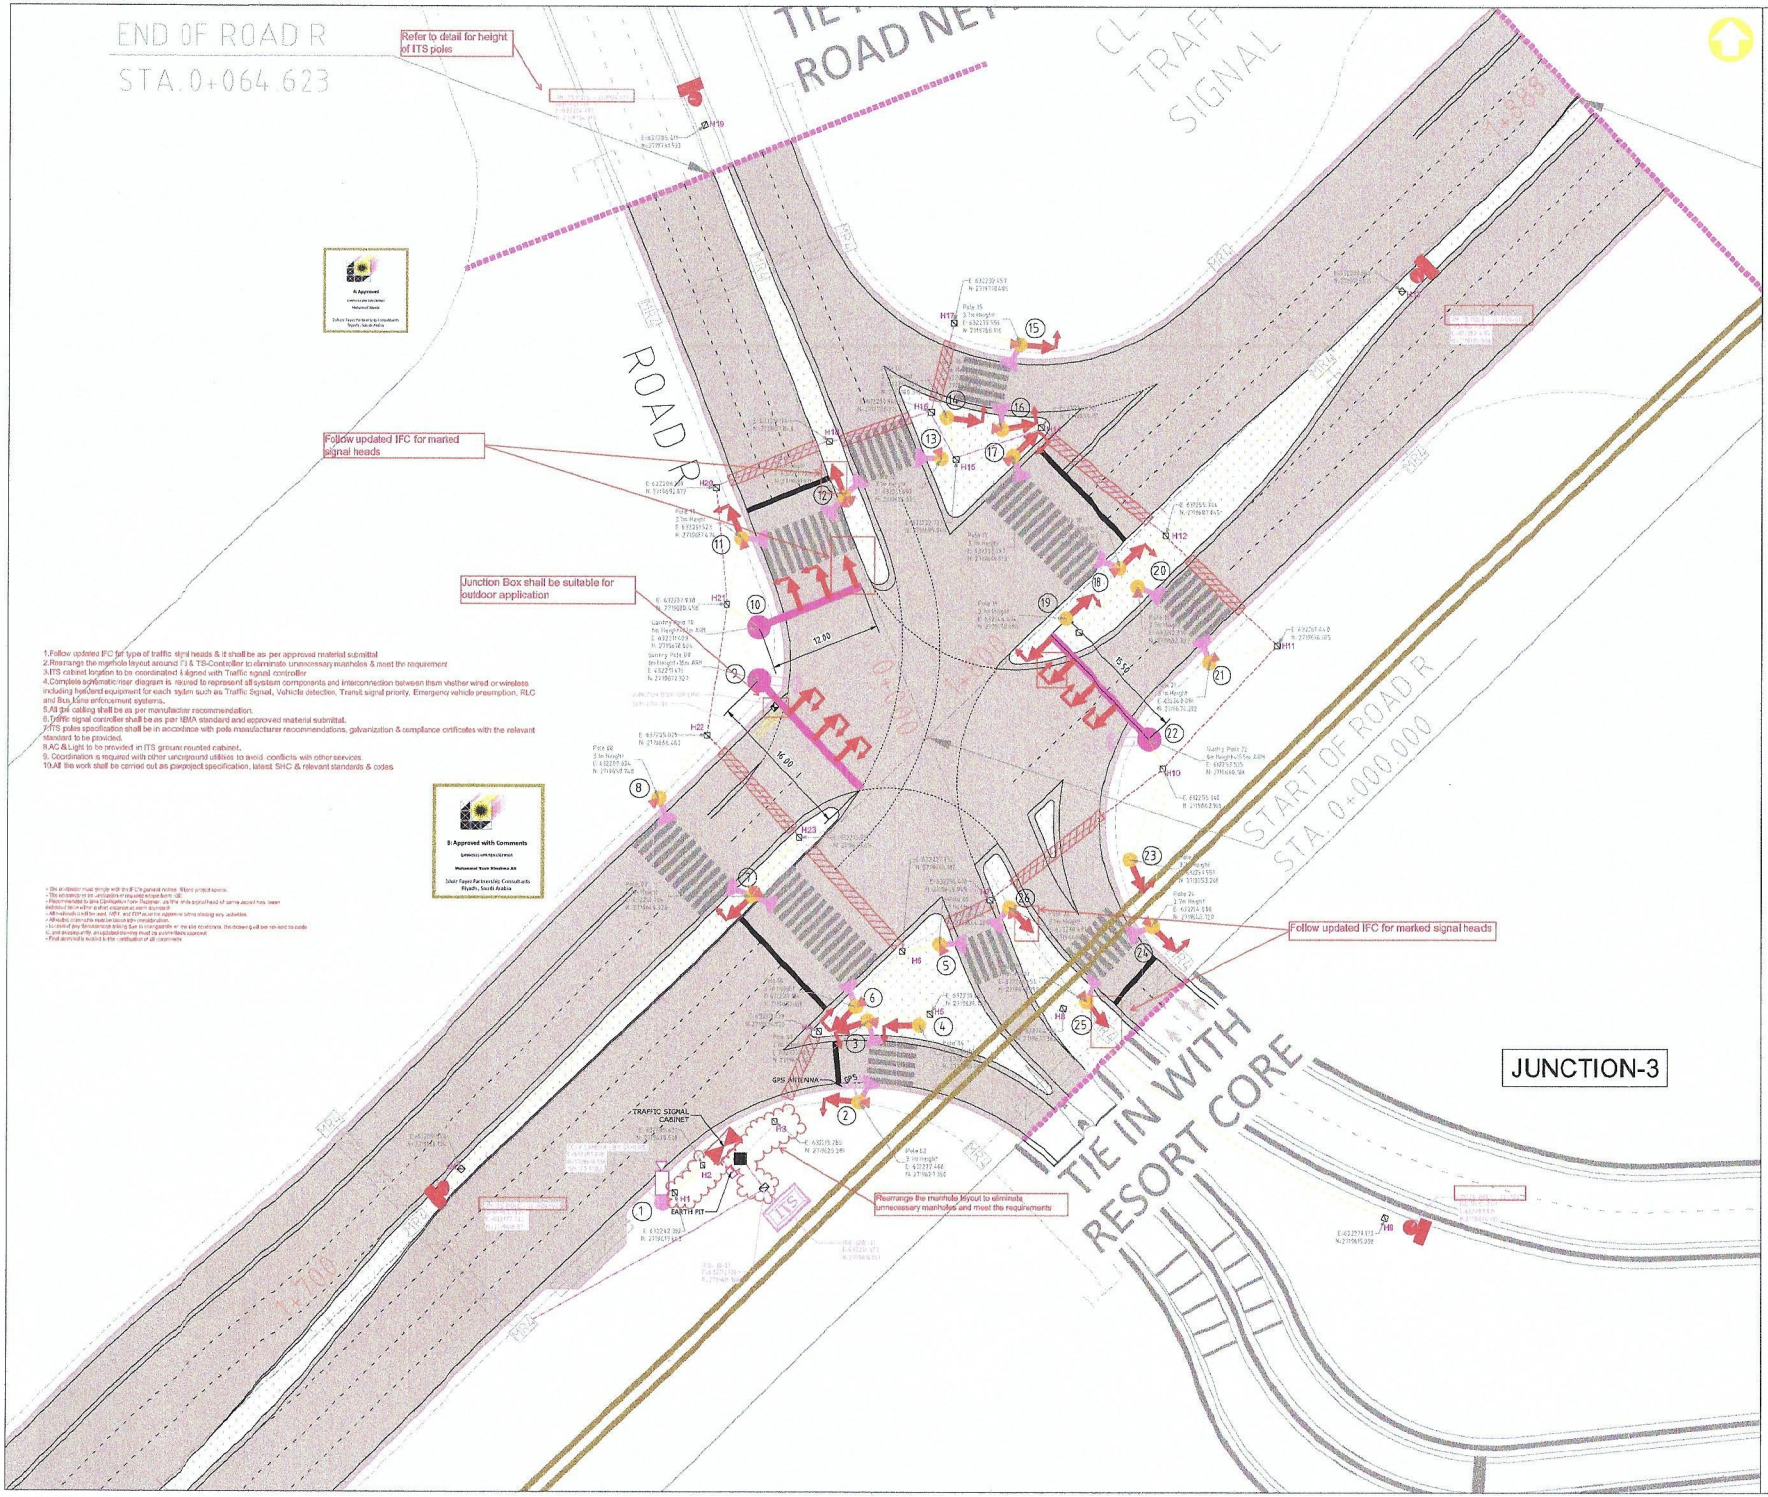

Qiddiya

Consultant's information

HEAD OFFICE - Riyadh
6283 King Abdul Aziz Rd, Ar Rabi
Riyadh 13316 2771, Saudi Arabia
Tel.: +966 11 4048484
Fax : +966 11 4048400
Website : www.zfp.com
Email.: zfpr@zfp.com

Zuhair Fayez Partnership

Notes:
1. ALL DIMENSIONS ARE IN MILLIMETER UNLESS OTHERWISE STATED.
2. ALL LEVELS ARE IN METERS UNLESS NOTED OTHERWISE.
3. THIS DRAWINGS IS TO BE READ IN CONJUNCTION WITH ALL RELEVANT ARCHITECTURAL, STRUCTURAL AND SERVICES DRAWINGS.

REFERENCE I.F.C DESIGN DRAWING NO:
1. QRXP117115-DAH-VORA2R-DWG-ITS-R3-Z00000-2000003
2. QRXP117115-DAH-VORA2R-DWG-ITS-R3-Z00000-5000001
3. QRXP117115-DAH-VORA2R-DWG-ITS-R3-Z00000-5000002
4. QRXP117115-DAH-VORA2R-DWG-ITS-R3-Z00000-5000005
5. QRXP117115-DAH-VORA2R-DWG-ITS-R3-Z00000-5000006
6. QRXP117115-DAH-VORA2R-DWG-ITS-R3-Z00000-6000001
7. QRXP117115-DAH-VORA2R-DWG-ITS-R3-Z00000-6000002
8. QRXP117115-DAH-VORA2R-DWG-ICT-R3-Z00000-2000000

LEGEND:

Rev. No.	Date	Description	Appr.
00	31-8-2025	FOR REVIEW AND APPROVAL	e
01	08-11-2025	FOR REVIEW AND APPROVAL	
--	--	--	--
--	--	--	--
--	--	--	--
--	--	--	--
--	--	--	--

Consultant
Contractor
Hail Company
ITS Contractor
TRAFFIC TECH
Project:
Qiddiya

Job title: Road Access To Resort Core

Drawing title: SHOPDRAWING OF TRAFFIC SIGNAL SYSTEM FOR JUNCTION-3

Sheet number: SHEET 1 / 20

Scale: 1:1000 @ A0

Drawn: M.Sayed	Checked: M.Sayed
Designed:	Approved:

Drawing number: QRXM114000-HFC-DRW-SDW-ITS-02-R05-00033

Revision: 01

Noted :

1. ITS Cabinet location is already fed on site and coordinated with the traffic signal controller as per approved shop drawings.
2. the junction box LPR is suitable for outdoor application



Noted the junction box LPR is suitable for outdoor application

Duct Banks & Manholes need to be in line

Rearrange the manhole layout to eliminate unnecessary manholes and meet the requirements

ITS CABINET LOCATION IS ALREADY FIXED ON SITE AND COORDINATED WITH THE TRAFFIC SIGNAL CONTROLLER AS PER APPROVED SHOP DRAWINGS.

TRAFFIC SIGNAL CABINET

EARTH PIT

GPS ANTENNA

1.Rearrange the manhole layout around ITS & TS-Controller to eliminate unnecessary manholes & meet the requirements
2.ITS cabinet location to be coordinated & aligned with Traffic signal controller
3.Complete schematic/wiring diagram is required to represent all system components and interconnection between them whether wired or wireless including feasible equipment for each system such as Traffic Signal, Vehicle detector, Transit signal priority, Emergency vehicle preemption, RLC and Bus Lane enforcement systems.
4.All the cabling shall be as per manufacturer recommendation.
5. Coordination is required with other underground utilities to avoid conflicts with other services.
6.All the work shall be carried out as per project specification, latest SHC & relevant standards & codes

* All general comments noted on drawing and previous Rev. shall considered

A: Approved

Zuhair Fayez Partnership Consultants
Riyadh , Saudi Arabia

القدية
Qiddiya

Consultant's Information

HEAD OFFICE - Riyadh
6283 King Abdul Aziz Rd, Ar Rabi
Riyadh 13316 2771, Saudi Arabia
Tel.: +966 11 4048484
Fax : +966 11 4048400
Website : www.zfp.com
Email.: zfpr@zfp.com

Zuhair Fayez Partnership

Notes:
1. ALL DIMENSIONS ARE IN MILLIMETER UNLESS OTHERWISE STATED.
2. ALL LEVELS ARE IN METERS UNLESS NOTED OTHERWISE.
3. THIS DRAWINGS IS TO BE READ IN CONJUNCTION WITH ALL RELEVANT ARCHITECTURAL, STRUCTURAL AND SERVICES DRAWINGS.

REFERENCE T.F.C DESIGN DRAWING NO:
1. QRXP117115-DAH-VORA2R-DWG-ITS-R3-Z00000-2000002
2. QRXP117115-DAH-VORA2R-DWG-ITS-R3-Z00000-5000003
3. QRXP117115-DAH-VORA2R-DWG-ITS-R3-Z00000-5000002
4. QRXP117115-DAH-VORA2R-DWG-ITS-R3-Z00000-5000005
5. QRXP117115-DAH-VORA2R-DWG-ITS-R3-Z00000-5000006
6. QRXP117115-DAH-VORA2R-DWG-ITS-R3-Z00000-6000001
7. QRXP117115-DAH-VORA2R-DWG-ITS-R3-Z00000-6000002
8. QRXP117115-DAH-VORA2R-DWG-ICT-R3-Z00000-2000000

LEGEND:

Rev. No	Date	Description	Appr.
00	30-8-2025	FOR REVIEW AND APPROVAL	C
01	04-11-2025	FOR REVIEW AND APPROVAL	B
02	04-02-2026	FINAL REVISION	
--	--	--	--
--	--	--	--
--	--	--	--
--	--	--	--

Consultant

Contractor
شركة هيت
Hait Company

ITS Contractor
TRAFFIC TECH

Project:
القدية
Qiddiya

Job title: Road Access To Resort Core

Drawing title: SHOPDRAWING OF TRAFFIC SIGNAL SYSTEM FOR JUNCTION-2

Sheet number: SHEET 1 / 19

Scale:1:1000 @ A0

Drawn: M.Elsayed	Checked: M.Abuzaid
Designed:	Approved:

Drawing number: QRXM11400D-HFC-DRW-SDW-ITS-02-R05-00024

Revision: 02

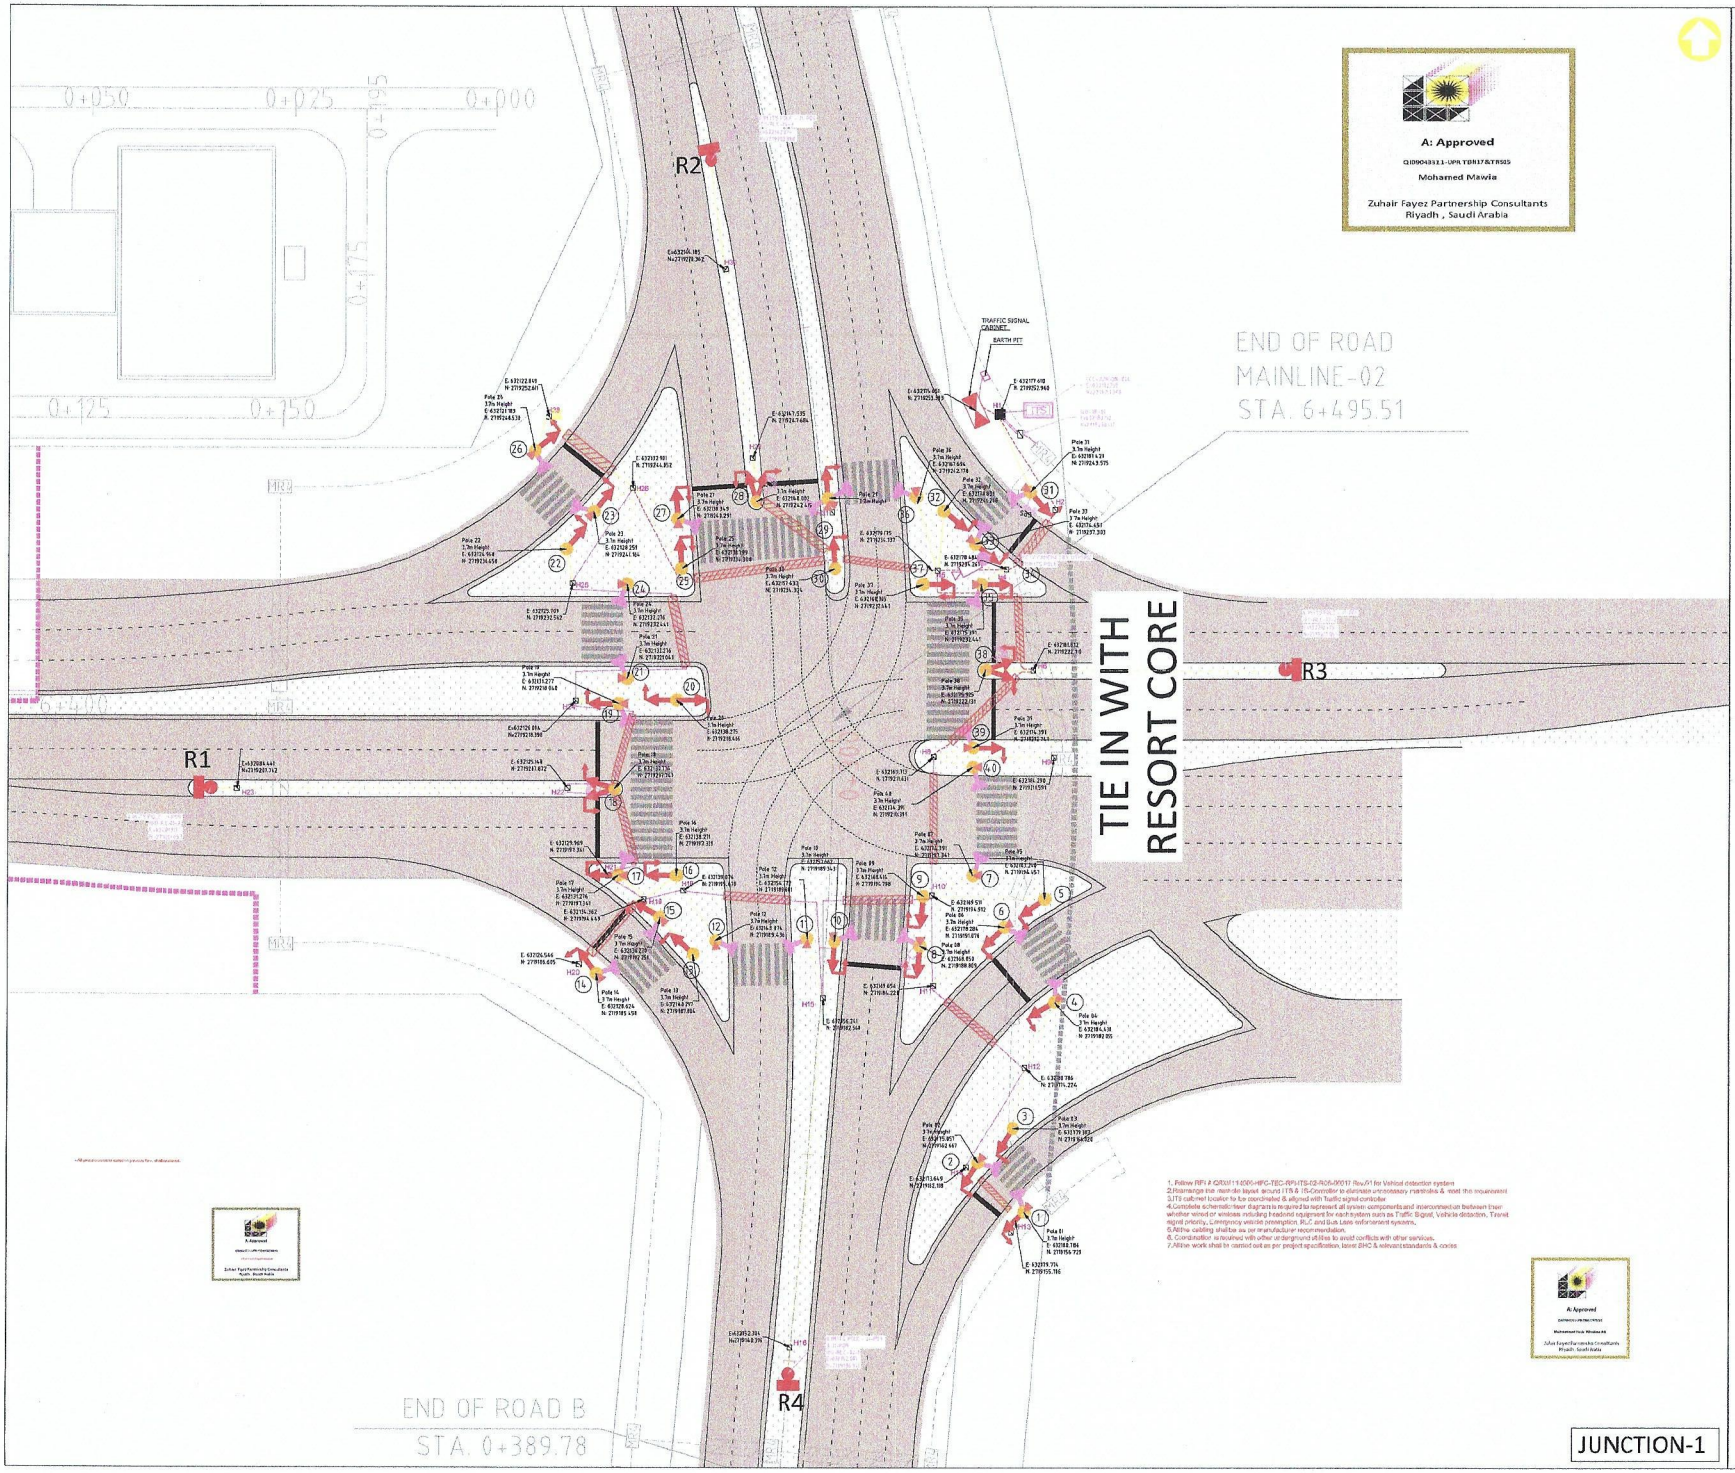

A: Approved

QID9043311-UPN TDH17&TRS05

Mohamed Mawia

Zuhair Fayez Partnership Consultants
Riyadh , Saudi Arabia

القديـــة
Qiddiya

Consultant's information

HEAD OFFICE - Riyadh
6283 King Abdul Aziz Rd, Ar Rabi
Riyadh 13316 2771, Saudi Arabia
Tel.: +966 11 4048484
Fax : +966 11 4048400
Website : www.zfp.com
Email.: zfpr@zfp.com

Zuhair Fayez Partnership

Notes:
1. ALL DIMENSIONS ARE IN MILLIMETER UNLESS OTHERWISE STATED.
2. ALL LEVELS ARE IN METERS UNLESS NOTED OTHERWISE.
3. THIS DRAWINGS IS TO BE READ IN CONJUNCTION WITH ALL RELEVANT ARCHITECTURAL, STRUCTURAL AND SERVICES DRAWINGS.

REFERENCE I.F.C DESIGN DRAWING NO:
1. QRXP117115-DAH-VORA2R-DWG-ITS-R3-Z00000-2000001
2. QRXP117115-DAH-VORA2R-DWG-ITS-R3-Z00000-5000001
3. QRXP117115-DAH-VORA2R-DWG-ITS-R3-Z00000-5000005
4. QRXP117115-DAH-VORA2R-DWG-ITS-R3-Z00000-5000006
5. QRXP117115-DAH-VORA2R-DWG-ITS-R3-Z00000-6000001
6. QRXP117115-DAH-VORA2R-DWG-ICT-R3-Z00000-2000000

LEGEND:

SIGNAL POST AL - 3.7m HEIGHT	CONCRETE ENCASED DUCT BANK
VEHICLE SIGNAL HEAD - CIRCULAR ASPECTS	UNPLASTICIZED POLYVINYL CHLORIDE DUCT, 1 #110mm
VEHICLE SIGNAL HEAD - THAROH ASPECTS	UNPLASTICIZED POLYVINYL CHLORIDE DUCT, 1 #110mm
VEHICLE SIGNAL HEAD - RIGHT TURN ASPECTS	UNPLASTICIZED POLYVINYL CHLORIDE DUCT, 1 #110mm
VEHICLE SIGNAL HEAD - LEFT TURN ASPECTS	UNPLASTICIZED POLYVINYL CHLORIDE DUCT, 1 #110mm
PEDESTRIAN HEAD SIGNAL	CLOSED CIRCUIT TELEVISION POLE - 5m HEIGHT
PEDESTRIAN PUSH BUTTON	CLOSED CIRCUIT TELEVISION CAMERA (BY OTHERS)
SIGNAL POST AL/GANTRY NUMBER	VEHICLE DETECTION SYSTEM
JUNCTION BOX TYPE I : H260xW80xD800	TRAFFIC SIGNAL CABINET
JUNCTION BOX TYPE II : H600xW400xD300	ITS CABINET GROUND MOUNTED ENCLOSURE H240
JUNCTION BOX (JB)	RED LIGHT CAMERA WITH IR ILLUMINATOR (RLC)
GLOBAL POSITIONING SYSTEM ANTENNA	

TS_XXX (BY DOT / SASO/ H.O.D BY OTHERS)
ITS_XXX (BY DOT ROAD DESIGN CONSULTANT/ENCAD BY OTHERS)
RAMSALT TYPE XXX BY OTHERS)

NUMBER OF DEVICES IN THE SAME LOCATION
DEVICE No. IN THE CORRESPONDING SHEET.
DEVICE ABBREVIATION
SHEET No

Rev. No.	Date	Description	Appr.
00	30-8-2025	FOR REVIEW AND APPROVAL	C
01	06-10-2025	FOR REVIEW AND APPROVAL	B
02	04-11-2025	FOR REVIEW AND APPROVAL	B
03	04-02-2026	FINAL REVISION	
--	--	--	--
--	--	--	--
--	--	--	--

Consultant

Contractor — Half Company

ITS Contractor — TRAFFIC TECH

Project: القديـــة Qiddiya

Job title: Road Access To Resort Core

Drawing title: SHOPDRAWING OF TRAFFIC SIGNAL SYSTEM FOR JUNCTION-1

Sheet number: SHEET 1 / 18

Scale:1:1000 @ A0

Drawn: M.Elsayed	Checked: M.Abuzaid
Designed:	Approved:

Drawing number: QRXM114000-HFC-DRW-SDW-ITS-02-ROS-00015

Revision 03