QIDDIYA DEVELOPMENT COMPANY					
DOCUMENT NUMBER:	QDC-ADM-TEM-QMS-00004	REVISION NUMBER:	00	ISSUED BY:	PMO
DOCUMENT TITLE	WIR FORM	DOCUMENT TYPE:	FORM	DATE ISSUED:	MAY-08-2022

WORK INSPECTION REQUEST (WIR) FORM

HAIF-FREYSSINET JV

Contractor:	HAIF-FREYSSINET JV
Project:	RA2RC
Contract No.:	QPMO-410-CT-00618
Work Inspection Request Number:	QRXM114000-HFC-TEC-WIR-ITS-02-RO5-00001

Discipline

Architecture	☐	Mechanical	☐	Information Technology	☐	Quality	☐	Project Controls	☐
Civil / Structural	☐	Electrical	☐	Landscape	☐	Safety	☐	Construction Management	☐
Other	☑								

WORK DESCRIPTION

Inspection / Test Location:	Mainline 02 - Spliting At Station 2+800		
GIS/GPS GeoTag Coordinates (If applicable)			
Inspection Date:	18-May-2026	Inspection Start Time:	8:30 am
ITP:	QRXM114000-HFC-TEC-ITP-ITS-02-RO5-00001	Checklist:	HFC-CKL-7002
Spec's / Dwg. Ref.:	QRXM114000-HFC-DRW-SDW-ITS-02-RO5-00011	Approved Method Statement Number:	QRXM114000-HFC-TEC-MST-ITS-02-RO5-00001
Attachments:	☑ Drawings ☐ Data Sheets ☐ TQs/RFI ☐ OTHER		

DESCRITPTION OF WORK

Inspection request for Installation of Road Weather Information System (RWIS)-1no, Air Quality Monitoring (AQM)-1no and 7mtr ITS Pole-1no. Mainline 02- Spliting At Station.2+800.

CONTRACTOR - QUALITY INSPECTOR - INITIAL INSPECTION FINDINGS:

Complies with Approved ITPs/Checklists?	◉ YES ○ NO ○ NA	REMARKS	
All Strucutral Embedded Items Cleared?	○ YES ○ NO ○ NA	WIR Number	
Embedded Electrical items Cleared by Electrical QC?	○ YES ○ NO ○ NA	WIR Number	
Embedded Mechanical Items Cleared by Mechanical QC?	○ YES ○ NO ○ NA	WIR Number	

Accepted:	◉
Accepted with Comments (See Remarks):	
Rejected (See Remarks):	

REMARKS:					
Name:	Moataz	Signature:		Date:	18/05/26

QIDDIYA / SUPERVISION CONSULTANT QC INSPECTOR - FINAL INSPECTION FINDINGS:

Contractor Has complied with Project spec requirements?	○ YES ○ NO		○ YES ○ NO ○ NA
Accepted:			○
Accepted with Comments (See Remarks):			☑
Rejected (See Remarks):			○

B: Approved with Comments
QD09083311-UPR TRN17&TN505
Saud Nawab
Zuhair Fayez Partnership Consultants
Riyadh , Saudi Arabia

REMARKS:	(1) Provide Liquid Tight flexible conduits for AQM. (2) The final location and mounting height of devices				
Name:	M. YASIR.	Signature:		Date	18/05/2026.

FOR DETAILED MATERIAL INSPECTION STATUS, PLEASE SEE ATTACHED CHECKLIST.
CHECKLISTS THAT ARE NOT ATTACHED AND SIGNED BY SUPERVISION CONSULTANT WILL VOID THIS INSPECTION REQUEST.

This document is the property of Qiddiya Development Company, 2022

of RWIS and AQM shall be finalized during the Testing and commissioning stage to ensure accurate measurements and optimum system performance in accordance with the project requirements.

Client:	Consultant:	Contractor:
Qiddiya	Zuhair Fayez Partnership	شركة هيف Haif Company

TECHNICAL DOCUMENTS

Project Name: Package 3 - Interim Road Access to Resort Core	**Project Code:** QRXM114000
**Location: RA2RC ** Qiddiya INTERM ROAD	**Date:** 14-February-2026
Document Title: Method of Statement for Installation and Commissioning of Intelligent Transportation System Equipment and Devices.	**Ref No: QRXM114000-HFC-TEC-MST-ITS-02-RO5-00001**
	Rev No: 00

Department: ☐ Architectural ☐ Civil/Structural ☐ Electrical ☐ Mechanical ☒ ITS ☐ Others

Type: ☐ Pre-Qualification ☒ Method Statement ☐ Material Submittal ☐ Sample ☐ Other

Document Description: Method of Statement for Installation and Commissioning of Intelligent Transportation System Equipment and Devices.

Doc. Ref. No.	Title
QRXM114000-HFC-TEC-MST-ITS-02-RO5-00001	**Method of Statement for Installation and Commissioning of Intelligent Transportation System Equipment and Devices.**

Enclosure:

Submitted By:	**Received By:**
Name: Eng. Moataz Signature: Date: 14-Feb-2026	Name: Signature: Date:

Below portion for Consultant Supervision use only

Status: ☐A- Approved ☐B- Approved as noted ☐C- Revise & Resubmit ☐R- For information only

Comments:

1.~~Attach approved ITP prepaired in QIC official format.~~
2.Provided MS pertains to installation & commissiong only. Contractor to include ~~complete testing procedure of each ITS system.~~
2.All the work shall be carried out in accordance with project specification & applicable standards & codes

C: Revise and Resubmit
Zuhair Fayez Partnership Consultants
Riyadh , Saudi Arabia

B: Approved with Comments
Syed Walayat
Zuhair Fayez Partnership Consultants
Riyadh , Saudi Arabia

Below portion for Client use only

Comments:

Signed by: Signature: Date:

QIDDIYA DEVELOPMENT COMPANY						
DOCUMENT NUMBER:	QDC-ADM-TEM-QMS-00007	REVISION NUMBER:	00	ISSUED BY:	PMO	Qiddiya
DOCUMENT TITLE:	MIR FORM	DOCUMENT TYPE:	FORM	DATE ISSUED:	MAY-00-2022	

MATERIAL INSPECTION REQUEST (MIR) FORM

Contractor:	HAIF COMPANY
Project:	QPMO-410-CT-00618- ROAD ACCESS TO RESORT CORE
Contract No.:	QI09043311-VO-0004
Material Inspection Request Number:	QRXM114000-HFC-TEC-MIR-ITS-02-RO5-00001

HAIF-FREYSSINET JV

Discipline

Architecture	☐	Mechanical	☐	Information Technology	☐	Quality	☐	Project Controls	☐
Civil/Structural	☑	Electrical	☐	Landscape	☐	Safety	☐	Construction Management	☐
Other	☐								

MATERIAL DESCRIPTION

Inspection / Test Location:	INTERIM ROAD MAIN LINE-02		
Material Name:	AIR QUALITY MONITOR SINSOR	Quantity:	01 Pcs.
P.O Number		Delivery Note Number:	TTS-HAIF-DN-0015
Approved Material Transmittal Number: (Aconex document Approval)		Approval Date:	
Inspection Date:	21-Jan-2026	Inspection Start Time:	10:20 AM
ITP:		Checklist:	
Spec's / Dwg. Ref.:	TRAFFIC TECH SECURITY W.L.L	Approved Method Statement Number:	
Attachments:	Test Certificate: ◉ Yes ○ No		
	IFC / Shop Drawings: ○ Yes ◉ No		

DESCRIPTION OF MATERIAL

AQM (RWIS PART) Air Quality Monitor Sinsor Ultrasonic Anemomenter (Qty.-01) for Interim Road Main Line-02

CONTRACTOR - QUALITY INSPECTOR - INITIAL INSPECTION FINDINGS:

Are Complete Details Mentioned in P.O and Delivery Note?	◉ YES ○ NO	REMARKS	
Complies with Approved ITPs/Checklists?	◉ YES ○ NO	REMARKS	
Signs of Physcial Damage?	○ YES ◉ NO	REMARKS	
Conforms to Approved Material Submittal?	○ YES ○ NO	REMARKS	

Accepted:	◉
Accepted with Comments:	○
Rejected (See Remarks):	○

REMARKS:			
Name:	Moataz Elkhateeb	Signature:	Date: 21-01-2026

QIDDIYA / SUPERVISION CONSULTANT QC INSPECTOR - FINAL INSPECTION FI

Contractor Has complied with Material requirements?	○ YES ○ NO
Accepted:	
Accepted with Comments:	
Rejected (See Remarks):	

B: Approved with Comments
QI09043311-UPR TRI127&TRI128
Saud Nawab
Zuhair Fayez Partnership Consultants
Riyadh , Saudi Arabia

☑ YES ○ NO ○ NA

REMARKS:	(1) Spare parts and tools shall be handed over to QIC operation and maintenance team. (2) Comply with the comments mentioned in attached supporting documents.		
Name:	M. YASIR.	Signature:	Date: 21/01/2026

FOR DETAILED MATERIAL INSPECTION STATUS, PLEASE SEE ATTACHED CHECKLIST.
CHECKLISTS THAT ARE NOT ATTACHED AND SIGNED BY SUPERVISION CONSULTANT WILL VOID THIS INSPECTION REQUEST.

This document is the property of Qiddiya Development Company. 2022

Client:	Consultant:	Contractor:
Qiddiya	Zuhair Fayez Partnership	Hail Company / Freyssinet — HAIF-FREYSSINET JV

TECHNICAL DOCUMENTS

Project Name: Package 3 - **Interim Road Access to Resort Core**	**Project Code:** QRXM114000
Location: 00	**Date:**15-September-2025
Document Title:**Material Approval Request FOR ITS SYSTEM SUPPLYING & INSTALLING BY TRAFFIC TECH SECURITY W.L.L (RWIS and AQM)**	**Ref No:** QRXM114000-HFC-TEC-MAT-ITS-02-RO5-00002
	Rev No: 00

Department: ☐ Architectural ☐ Structural ☐ Electrical ☐ Mechanical ☑ ITS ☐ Civil

Type: ☐ Pre-Qualification ☐ Method Statement ☒ Material Submittal ☐ Sample ☐ Other

Document Description: Material Approval Request FOR ITS SYSTEM SUPPLYING & INSTALLING BY TRAFFIC TECH SECURITY W.L.L (RWIS and AQM)

Doc. Ref. No.	Title
QRXM114000-HFC-TEC-MAT-ITS-02-RO5-00002	**Material Approval Request FOR ITS SYSTEM SUPPLYING & INSTALLING BY TRAFFIC TECH SECURITY W.L.L (RWIS and AQM)**

Enclosure:

Submitted By:	**Received By:**
Name: **Eng. Moataz** Signature: Date:15-September-2025	Name: Signature: Date:

Below portion for Consultant Supervision use only

Status: ☐A- Approved ☐B- Approved as noted ☐C- Revise & Resubmit ☐R- For information only

Comments:

It is a conditional approval, as changes are expected in the design, specifications, and drawings. The Contractor/Supplier must ensure proper coordination and compliance with expected changes & following comments prior to procurement. In case of any contradiction or non-compliance, this approval shall be deemed Code-C, and the Contractor/Supplier shall rectify it without any additional cost or time impact.

1.The final finish color of RWIS & AQM System's Enclosure & expose components shall be as per QIC requirement.

2.The brand name and model/part number of the visibility sensor and atmospheric condition sensors are not mentioned, and the products have not been verified on the DMV website. The contractor shall provide complete information about the proposed material.

3.Test certificates for Visibility Sensor & Atmospheric condition Sensor are not attached





Below portion for Client use only

Comments:



Signed by: Signature: Date:

QIDDIYA DEVELOPMENT COMPANY						
DOCUMENT NUMBER:	QDC-ADM-TEM-QMS-00007	REVISION NUMBER:	0D	ISSUED BY:	PMO	Qiddiya
DOCUMENT TITLE	MIR FORM	DOCUMENT TYPE:	FORM	DATE ISSUED:	MAY-08-2022	

MATERIAL INSPECTION REQUEST (MIR) FORM

Contractor:	HAIF COMPANY
Project:	QPMO-410-CT-00618- ROAD ACCESS TO RESORT CORE
Contract No.:	QI09043311-VO-0004
Material Inspection Request Number:	QRXM114000-HFC-TEC-MIR-ITS-02-RO5-00003

HAIF-FREYSSINET JV

Discipline

Architecture	☐	Mechanical	☐	Information Technology	☐	Quality	☐	Project Controls	☐
Civil/Structural	☑	Electrical	☐	Landscape	☐	Safety	☐	Construction Management	☐
Other	☐								

MATERIAL DESCRIPTION

Inspection / Test Location:	INTERIM ROAD MAIN LINE-02		
Material Name:	ITS SYSTEMS (ROAD WEATHER STATION)	Quantity:	01 Pcs.
P.O Number		Delivery Note Number:	TTSDN-HAIF-201225-010
Approved Material Transmittal Number: (Aconex document Approval)		Approval Date:	
Inspection Date:	22-Jan-2026	Inspection Start Time:	09:30 AM
ITP:		Checklist:	
Spec's / Dwg. Ref.:	TRAFFIC TECH SECURITY W.L.L	Approved Method Statement Number:	
Attachments:	Test Certificate: ◉ Yes ○ No IFC / Shop Drawings: ○ Yes ◉ No		

DESCRITPTION OF MATERIAL

(ITS Systems) Road Weather Station for Monitoring Road Weather Conditions (Qty.-01) for Interim Road Main Line-02

CONTRACTOR - QUALITY INSPECTOR - INITIAL INSPECTION FINDINGS:

Are Complete Details Mentioned in P.O and Delivery Note?	◉ YES ○ NO	REMARKS	
Complies with Approved ITPs/Checklists?	◉ YES ○ NO	REMARKS	
Signs of Physcial Damage?	○ YES ◉ NO	REMARKS	
Conforms to Approved Material Submittal?	○ YES ○ NO	REMARKS	

Accepted:	◉
Accepted with Comments:	○
Rejected (See Remarks):	○

REMARKS:					
Name:	Moataz Elkhateeb	Signature:		Date:	22-01-2026

QIDDIYA / SUPERVISION CONSULTANT QC INSPECTOR - FINAL INSPECTION FINDII

Contractor Has complied with Material requirements?	○ YES ○ NO		○ YES ○ NO ○ NA
Accepted:			
Accepted with Comments:			✓
Rejected (See Remarks):			

B: Approved with Comments
QI09043311-UPR-TEN73 &TN505
Saud Nawab
Zuhair Fayez Partnership Consultants
Riyadh , Saudi Arabia

REMARKS:	① Final approval is subject to the acceptance of successful completion of Testing and commissioning. ② Attach original delivery Note and approved ITP.				
Name:	M-YASIR.	Signature:		Date	22/01/2026

FOR DETAILED MATERIAL INSPECTION STATUS, PLEASE SEE ATTACHED CHECKLIST.
CHECKLISTS THAT ARE NOT ATTACHED AND SIGNED BY SUPERVISION CONSULTANT WILL VOID THIS INSPECTION REQUEST.

This document is the property of Qiddiya Development Company, 2022

③ Comply with the comments mentioned on attached

Client:	Consultant:	Contractor:
Qiddiya	Zuhair Fayez Partnership	Hail Company / Freyssinet — HAIF-FREYSSINET JV

TECHNICAL DOCUMENTS

Project Name: Package 3 - **Interim Road Access to Resort Core**	**Project Code:** QRXM114000
Location: 00	**Date:** 15-September-2025
Document Title: **Material Approval Request FOR ITS SYSTEM SUPPLYING & INSTALLING BY TRAFFIC TECH SECURITY W.L.L (RWIS and AQM)**	**Ref No:** QRXM114000-HFC-TEC-MAT-ITS-02-RO5-00002
	Rev No: 00

Department: ☐ Architectural ☐ Structural ☐ Electrical ☐ Mechanical ☑ ITS ☐ Civil

Type: ☐ Pre-Qualification ☐ Method Statement ☒ Material Submittal ☐ Sample ☐ Other

Document Description: Material Approval Request FOR ITS SYSTEM SUPPLYING & INSTALLING BY TRAFFIC TECH SECURITY W.L.L (RWIS and AQM)

Doc. Ref. No.	Title
QRXM114000-HFC-TEC-MAT-ITS-02-RO5-00002	**Material Approval Request FOR ITS SYSTEM SUPPLYING & INSTALLING BY TRAFFIC TECH SECURITY W.L.L (RWIS and AQM)**

Enclosure:

Submitted By:	**Received By:**
Name: **Eng. Moataz** Signature: Date: 15-September-2025	Name: Signature: Date:

Below portion for Consultant Supervision use only

Status: ☐A- Approved ☐B- Approved as noted ☐C- Revise & Resubmit ☐R- For information only

Comments:

It is a conditional approval, as changes are expected in the design, specifications, and drawings. The Contractor/Supplier must ensure proper coordination and compliance with expected changes & following comments prior to procurement. In case of any contradiction or non-compliance, this approval shall be deemed Code-C, and the Contractor/Supplier shall rectify it without any additional cost or time impact.

1. The final finish color of RWIS & AQM System's Enclosure & expose components shall be as per QIC requirement.
2. The brand name and model/part number of the visibility sensor and atmospheric condition sensors are not mentioned, and the products have not been verified on the DMV website. The contractor shall provide complete information about the proposed material.
3. Test certificates for Visibility Sensor & Atmospheric condition Sensor are not attached

B: Approved with Comments
Zuhair Fayez Partnership Consultants
Riyadh , Saudi Arabia

B: Approved with Comments
Zuhair Fayez Partnership Consultants
Riyadh , Saudi Arabia

Below portion for Client use only

Comments:

B: Approved with Comments
Zuhair Fayez Partnership Consultants
Riyadh , Saudi Arabia

Signed by: Signature: Date:

Client:	Consultant:	Contractor:
Qiddiya	Zuhair Fayez Partnership	Haif Company / Freyssinet — HAIF-FREYSSINET JV

TECHNICAL DOCUMENTS

Project Name: Package 3 - Interim Road Access to Resort Core	**Project Code:** QRXM114000
Location: 00	**Date:** 26-March-2026
Document Title: **Inspection & Test Plan for RWIS and AQM**	**Ref No:** QRXM114000-HFC-TEC-ITP-ITS-02-RO5-00001
	Rev No: 00

Department: ☐ Architectural ☐ Structural ☐ Electrical ☐ Mechanical ☐ Authority ☒ ICT

Type: ☐ Pre-Qualification ☐ Method Statement ☐ Material Submittal ☐ Sample ☒ ITP

Document Description: This is Inspection & Test Plan for for RWIS and AQM

Doc. Ref. No.	Title
QRXM114000-HFC-TEC-ITP-ITS-02-RO5-00001	**Inspection & Test Plan for for RWIS and AQM**

Enclosure:

Submitted By:	**Received By:**
Name: Eng. Moataz Signature: Date: 26-march-2026	Name: Signature:

Below portion for Consultant Supervision use only

Status: ☐A- Approved ☐B- Approved as noted ☐C- Revise & Resubmit ☐R- For information only

Comments:
1.All the work shall be carried out in accordance with project specification.
2.Performance & operational tests shall be conducted for countinous 24hr period as mentioned in project specification.







Below portion for Client use only

Comments:

Signed by: Signature: Date:

HAIF-FSA JV Inspection & Test Plan					I&TP	APPROVED DATE	DISCIPLINE
Intelligent Transportation System Works for RWIS and AQM INSTALLATION AND OPERATION					HFC-ITP-0070		ITS
PROJECT TITLE:WBS Access Road To Resort Core (RA2RC)					CONTRACTOR/SUBCONTRACTOR		
WIR No.					CONSTRUCTION-Intelligent Transportation System Works for INSTALLATION AND OPERATION RWIS and AQM	HAIF	

ITEM NO.	PROJECT PHASE	TASK / ACTIVITY	Quality Requirements /references/ specifications	Quality Record	INSPECTION RESPONSIBILITY ASSIGNMENTS		REMARKS
					Contractor	Consultant	
1.0 DOCUMENT REVIEW							
1		Material Approval & Shop Drawing	QRXM114000-HFC-TEC-MAT-ITS-02-RO5-00002 QRXM114000-HFC-DRW-SDW-ITS-02-RO5-00001-00086	QRXM114000-HFC-TEC-MAT-ITS-02-RO5-00002 QRXM114000-HFC-DRW-SDW-ITS-02-RO5-00001-00086	R	H	
2.0 MATERIAL RECEIVING INSPECTION							
2		Material receiving inspection, protection & storage	QD0002-ADM-TEM-QMS00007[0A] MaterialReceiving Inspection in site HFC-CKL-4001	QD0002-ADM-TEM-QMS00007[0A] MaterialReceivingInspection in siteHFC-CKL-4001	H	H	MIR to be submitted
3.0 WORK INSTALLATION							
3.1		PRE - INSTALLATION	HFC-CKL-7001	HFC-CKL-7001	H	H	
3.2		INSTALLATION	HFC-CKL-7002	HFC-CKL-7002	H	H	
3.3		TESTING	HFC-CKL-7003	HFC-CKL-7003	H	H	

	GENERAL NOTES
1	Surveillance: QA/QC organization to monitor work in progress without notice from Construction Organization
2	Witness: QA/QC organization shall be notified of the timing of Inspection or test in advance. However, the inspection or test shall be performed as scheduled if the QA/QC organization representative is not present.
3	Hold: QA/QC organization shall be notified of the timing of inspection or test in advance. Inspection or test shall not be carried out without the QA/QC organization representative in attendance.
4	If the Main Contractor delegates the assigned responsibility to the Subcontractor, then the Main Contractor will have the same degree of responsibility as assigned to Consultant.

LEGEND			
H	Hold Point for QC Inspection/ Test	R	Review of Documents
W	Witness Inspection/T	RH	Review & approval of Documents
S	Surveillance		

HFC-ITP-030

Checklist : HFC-CKL-4001

Material receiving inspection, protection & storage

PROJECT TITLE: Road Access To Resort Core (RA2RC)

WIR No.

Checklist	APPROVED DATE	DISCIPLINE
HFC-CKL-7001		ITS
WBS	CONTRACTOR/SUBCONTRACTOR	
CONSTRUCTION- Intelligent Transportation System Works for INSTALLATION AND OPERATION of RWIS and AQM	HAIF	

ITEM NO.	Check Points & Acceptance Criteria	Reference	Pass	Fail	Not Applicable	Re-Inspection
1.0	**Material receiving inspection,protection & storage of ITS Devices (RWIS and AQM)**					
1.1	Deliver ITS Device in packaging, protected, complying with applicable Standard.	project specification SECTION 137720 - ROADWAY WEATHER INFORMATION SYSTEM (RWIS and AQM)				
1.2	Store equipment in a dry location. Protect from weather,fumes, water, debris,direct exposure to the sunlight, ultraviolet,etc	project specification SECTION 137720 - ROADWAY WEATHER INFORMATION SYSTEM (RWIS and AQM)				
1.3	Provide necessary protection if required as per manufacturer's recommendations.	project specification SECTION 137720 - ROADWAY WEATHER INFORMATION SYSTEM (RWIS and AQM)				
1.4	Handle equipment and devices with care, to avoid abrasion, puncturing and tearing housing, paint.	project specification SECTION 137720 - ROADWAY WEATHER INFORMATION SYSTEM (RWIS and AQM)				

Remarks

PM/Contractor			QDC		
Contractor Construction			Third Party (if applicable)		
The work is ready for Inspection			Document Reviewed	Work Inspected	Test Records Verified
Name: Farwa	Signature	Date	Name	Signature	
Contractor QC Inspector			QDC Supervision Consultant		

Form Ref. No: QD0002-ADM-TEM-QTY-00003- Rev.0A

Checklist : HFC-CKL-4002			
INSTALLATION OF RWIS AND AQM	Checklist: HFC-CKL-7002	APPROVED DATE	DISCIPLINE: ITS
PROJECT TITLE: Road Access To Resort Core (RA2RC)	WBS	CONTRACTOR/SUBCONTRACTOR	
WIR No.	CONSTRUCTION- Intelligent Transportation System Works for INSTALLATION AND OPERATION of RWIS and AQM	HAIF	

ITEM NO.	Check Points & Acceptance Criteria	Reference	Pass	Fail	Not Applicable	Re-Inspection
1.0	**INSTALLATION OF ITS DEVICES - RWIS and AQM**					
1.1	Install device and cables as indicated, according to manufacturer's written instructions. .	project specification SECTION 137720 - ROADWAY WEATHER INFORMATION SYSTEM (RWIS and AQM)				
1.2	Was the installation of RWIS and AQM as per the approved shop drawings?	project specification SECTION 137720 - ROADWAY WEATHER INFORMATION SYSTEM (RWIS and AQM)				
1.3	Were the RWIS and AQM properly fixed and tightened on poles as per the method statement and shop drawing?	project specification SECTION 137720 - ROADWAY WEATHER INFORMATION SYSTEM (RWIS and AQM)				
1.4	Is the facing and orientation of RWIS and AQM sensor properly done?	project specification SECTION 137720 - ROADWAY WEATHER INFORMATION SYSTEM (RWIS and AQM)				
1.5	Is the holding bracket firm and tightened on the pole?	project specification SECTION 137720 - ROADWAY WEATHER INFORMATION SYSTEM (RWIS and AQM)				
1.6	Verify Mounting height as per specification.	project specification SECTION 137720 - ROADWAY WEATHER INFORMATION SYSTEM (RWIS and AQM)				
1.7	Did Technical Manual received for installed materials?	project specification SECTION 137720 - ROADWAY WEATHER INFORMATION SYSTEM (RWIS and AQM)				

Remarks

PM/Contractor			QDC		
Contractor Construction			**Third Party (if applicable)**		
The work is ready for inspection			**Document Reviewed**	**Work Inspected**	**Test Records Verified**
Name	Signature	Date	Name	Signature	
Contractor QC Inspector			QDC Supervision Consultant		

Form Ref. No. QDC002-ADM-TEM-QTY-00003– Rev.0A

Checklist : HFC-CKL-4004										
POST INSTALLATION AND TESTING OF RWIS and AQM						Checklist	APPROVED DATE		DISCIPLINE	
PROJECT TITLE: Road Access To Resort Core (RA2RC)						HFC-CKL-7003			ITS	
WIR No.						WBS	CONTRACTOR/SUBCONTRACTOR			
						CONSTRUCTION- Intelligent Transportation System Works for INSTALLATION AND OPERATION of RWIS and AQM	HAIF			
ITEM NO.	Check Points & Acceptance Criteria			Reference		Pass	Fail	Not Applicable	Re-Inspection	
1.0	**SITE ACCEPTANCE TESTING OF RWIS and AQM**									
1.1	Read the values under normal conditions. The parameter value should be 7500m. Then cover the sensor cameras and check if the value of parameters is lowering down. The parameter that should change the value is the Visibility parameter, which shows the value in meters.			project specification SECTION 137720 - ROADWAY WEATHER INFORMATION SYSTEM (RWIS and AQM)						
1.2	Check the value of the atmospheric pressure parameter. Is the value of this parameter between 970 and 1020hPa?			project specification SECTION 137720 - ROADWAY WEATHER INFORMATION SYSTEM (RWIS and AQM)						
1.3	Point the heater towards the sensor and check if the temperature parameter is rising. The parameter that should change the value is the active air temperature.			project specification SECTION 137720 - ROADWAY WEATHER INFORMATION SYSTEM (RWIS and AQM)						
1.4	Check the humidity parameter and enter the reading.			project specification SECTION 137720 - ROADWAY WEATHER INFORMATION SYSTEM (RWIS and AQM)						
1.5	Point the fan towards the sensor and check if the wind speed parameter is rising. The parameatre whose value needs to be changed is the active wind speed			project specification SECTION 137720 - ROADWAY WEATHER INFORMATION SYSTEM (RWIS and AQM)						
1.6	Direct the water jet towards the sensor and check if the parameter changes. The parameter that should change the value is the precipitation type. For rain, it should show a value of 60.			project specification SECTION 137720 - ROADWAY WEATHER INFORMATION SYSTEM (RWIS and AQM)						
Test from the Control Center										
1.1	Check wether the device is registered and whether it regularly reports to the sever.			project specification SECTION 137720 - ROADWAY WEATHER INFORMATION SYSTEM (RWIS and AQM)						
1.2	Check reading for the visibility sensor.			project specification SECTION 137720 - ROADWAY WEATHER INFORMATION SYSTEM (RWIS and AQM)						
1.3	Check reading for sensors measuring atmospheric conditions.			project specification SECTION 137720 - ROADWAY WEATHER INFORMATION SYSTEM (RWIS and AQM)						
Remarks										

PM/Contractor				QDC			
Contractor Construction				Third Party (if applicable)			
The work is ready for inspection				Document Reviewed	Work Inspected		Test Records Verified
Name	Signature		Date	Name	Signature		
Fang							
Contractor QC Inspector				QDC Supervision Consultant			

A: Approved

Zahid Fayez Partnership Consultants
Riyadh , Saudi Arabia


B: Approved with Comments


Zahid Fayez Partnership Consultants
Riyadh - Saudi Arabia

For comments refer to the drawing
#QRXM114000-HFC-DRW-SDW-ITS-02-RO5-00007

B: Approved with Comments

Zahid Fayez Partnership Consultants
Riyadh - Saudi Arabia

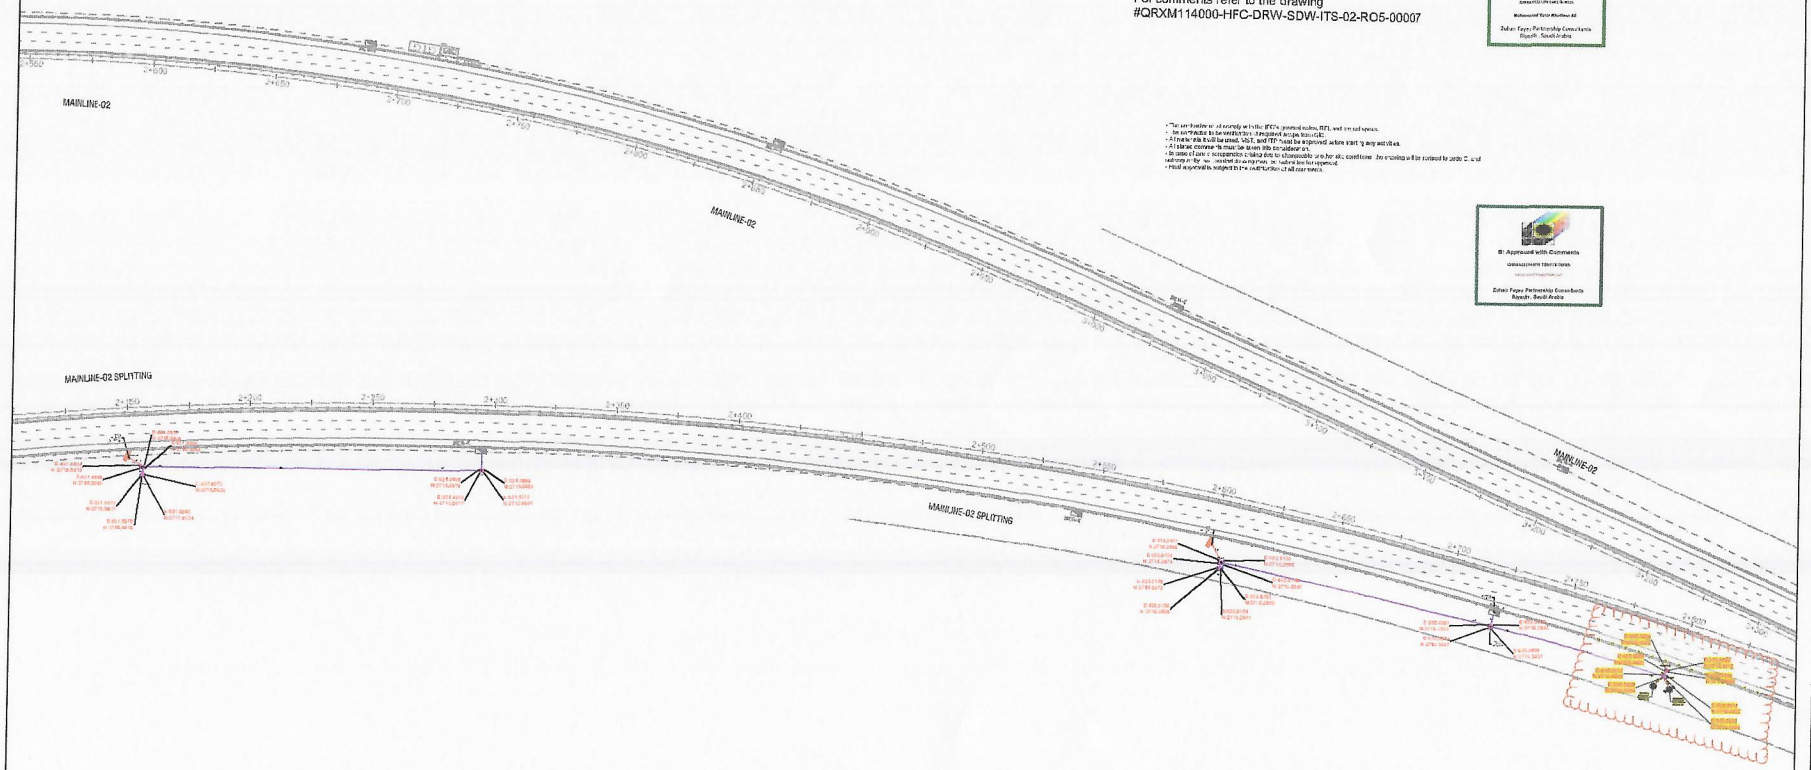

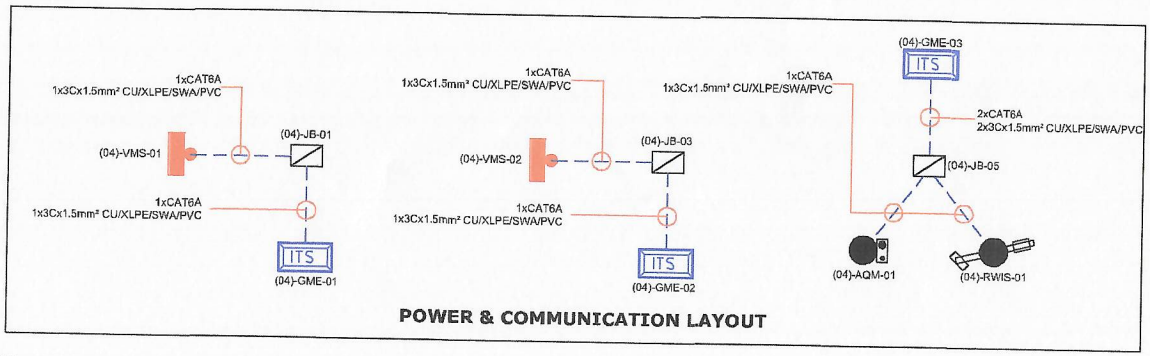


POWER & COMMUNICATION LAYOUT

القدية
Qiddiya

Consultant's information

HEAD OFFICE - Riyadh
6283 King Abdul Aziz Rd, Ar Rabi
Riyadh 13316 2771, Saudi Arabia
Tel.: +966 11 4048484
Fax : +966 11 4048400
Website : www.zfp.com
Email.: zfpr@zfp.com

Zahid Fayez Partnership

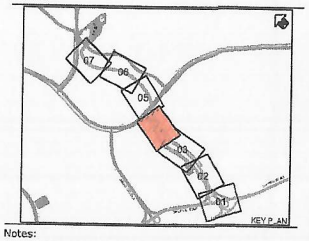

Notes:
1). All DIMENSIONS ARE IN METERS UNLESS OTHERWISE NOTED

REFERENCE I.F.C DRAWING NO:
QRXM114000-DAH-YDRA30-DWG-ITS-R2-200000-2000001 TO 2000007
QRXM114000-DAH-YDRA30-DWG-ITS-R2-200000-5000014
QRXM114000-DAH-YDRA30-DWG-ICT-R2-200000-2000000 TO 2000009
QRXM114000-DAH-YDRA30-DWG-ROD-R2-200000-2000201 TO 2000207
QRXM114000-DAH-YDRA30-DWG-ROD-R2-200000-2000211 TO 2000217

LEGEND:

- JUNCTION BOX TYPE 3 (JB3)
- UPVC DUCT, 4 x 40mm POWER & COMMUNICATION
- UPVC DUCT, 2 x 40mm POWER & COMMUNICATION
- ITS POWER & COMMUNICATION CABLE
- VARIABLE MESSAGE SIGN (VMS)
- ITS CABINET GROUND MOUNTED ENCLOSURE (GME)
- ROADWAY WEATHER INFORMATION SYSTEM (RWIS) WITH AQM
- 65-WAY 110mm HDPE DUCT BANK (LAID EXCAVATED BY OTHERS)
- 6C-WAY 110mm HDPE DUCT BANK ROAD CROSSING (BY OTHERS) CONCRETE ENCASED BY OTHERS)
- HANDHOLE TYPE 2C (H-E BY OTHERS)
- (E) - DWG- 01 — DEVICE No. IN THE CORRESPONDING SHEET. DEVICE ABBREVIATION. SHEET No.

Rev. No.	Date	Description	Appr.
00	28-08-2025	FOR REVIEW AND APPROVAL	C
01	20-10-2025	FOR REVIEW AND APPROVAL	C
02	9-11-2025	FOR REVIEW AND APPROVAL	B
03	6-12-2025	FOR REVIEW AND APPROVAL	
--	--	--	--
--	--	--	--
--	--	--	--

Consultant

Contractor: شركة هيت Hail Company

ITS Contractor: TRAFFIC

Project: القدية Qiddiya

Job title: ACCESS ROAD TO RESORT CORE

Drawing title: ITS SHOP DRAWINGS
ITS LAYOUT PLAN

Sheet number: SHEET 3 OF 4

Scale: 1:1000 @ A0

Drawn: M.SAYED | Checked: M.SAYED

Designed: | Approved:


Drawing number: QRXM114000-HFC-DRW-SDW-ITS-02-RO5-00011

Revision: 03

NOTES:

1. REFER TO SPECIFICATIONS FOR ADDITIONAL DETAILS RELATED TO INTELLIGENT TRANSPORTATION SYSTEM (ITS) REQUIREMENTS AND SCOPE.
2. ALL DIMENSIONS ARE IN METERS UN LESS OTHERWISE SHOWN.
3. PROVIDE STANDARD HAND HOLE AND WEATHERPROOF SERVICE ENTRANCES FOR THE SENSORS/OTHER EQUIPMENT AT LOCATIONS RECOMMENDED BY THE RWIS MANUFACTURER.
4. MINIMUM CLEARANCE BET WEEN THE RWIS/VMS POLE AND TRAVEL LANES SHALL BE AS PER MANUFACTURERS'S RECOMMENDATION.
5. RWIS/VMS STRUCTURE TO BE A POLE. POLE SHALL MEET DEFLECTION CRITERIA FOR ALL SENSORS PER MANUFACTURE'S RECOMMENDATIONS.
6. RWIS/VMS STRUCTURE TO BE PROVIDED AND DESIGN IN ACCORDANCE WITH MANUFACTURE'S RECOMMENDATIONS AND PER CLIENT STANDARDS.
7. THIS DRAWING IS TO BE READ IN CONJUNCTION WITH THE SPECIFICATIONS AND ALL RELEVANT OVERSEEING ORGANIZATIONS.
8. ALL DIMENSIONS ARE TO BE CONFIRMED ON SITE BY THE CONTRACTOR PRIOR TO FABRICATION.
9. SIGN SIZE, OVERHANGS AND FIXING DETAILS ARE TO BE CONFIRMED BY THE SIGN SUPPLIER PRIOR TO FABRICATIONS OF THE POLE.
10. THE STRUCTURAL ENGINEER IS RESPONSIBLE FOR ENSURING THAT THE MINIMUM CLEARANCE DISTANCE FROM THE CARRIAGEWAY TO THE PROPOSED STRUCTURES AND CABINETS IS ADHERED TO AND DUE CONSIDERATION SHOULD BE GIVEN TO INSTALLING A SAFETY BARRIERS SYSTEM FOR THE PROTECTION OF PROPOSED ITS STRUCTURES AND CABINETS AS PER LOCAL GUIDELINES AND AUTHORITY REQUIREMENTS.
11. ANY MAINTENANCE REQUIREMENTS PER LOCAL GUIDELINES AND AUTHORITY REQUIREMENTS TO BE CONSIDERED IN THE STRUCTURAL DESIGN.

1.Mounting heights of devices shall be as per site conditions and manufacturer recommendation to achieve optimal performance
2.All the work shall be carried out in compliance to project specification and applicable standard & codes

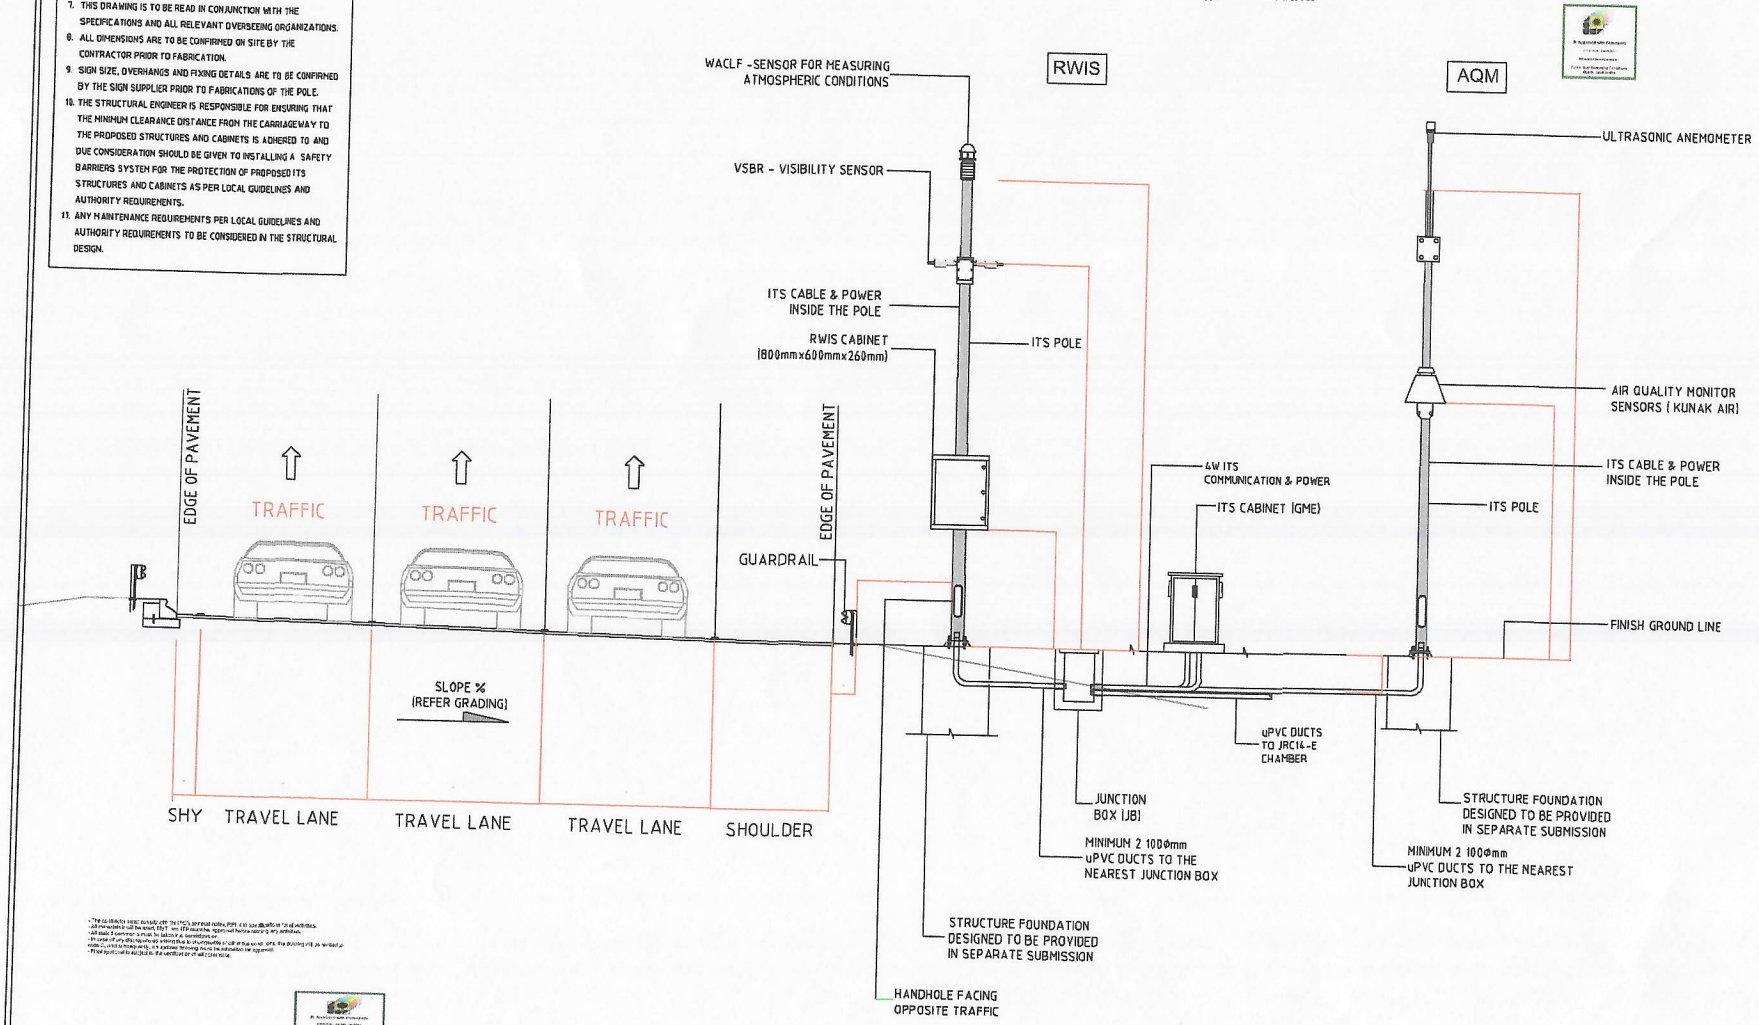

ROAD WEATHER AND INFORMATION SYSTEM (RWIS) AND AIR QUALITY MONITORING (AQM) ON 7m ITS POLE TYPICAL DETAILS


NOTE:
FOUNDATION DESIGN TO BE PROVIDED IN SEPARATE SUBMISSION

القديـــة
Qiddiya

Consultant's information

HEAD OFFICE - Riyadh
6283 King Abdul Aziz Rd, Ar Rabi
Riyadh 13316 2771, Saudi Arabia
Tel.: +966 11 4048484
Fax : +966 11 4048400
Website : www.zfp.com
Email.: zfpr@zfp.com

Zuhair Fayez Partnership

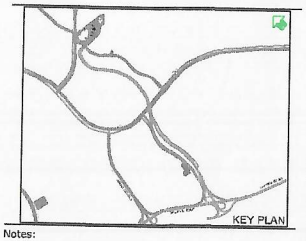

Notes:
1). All DIMENSIONS ARE IN METERS UNLESS OTHERWISE NOTED

REFERENCE I.F.C DRAWING NO:
QRXP-ITITS-DAH-VORAR-DWG-ITS-R2-Z00004-Z000000 TO Z0000007
QRXP-ITITS-DAH-VORAR-DWG-ITS-R2-Z00004-Z0000004
QRXP-ITITS-DAH-VORAR-DWG-ITS-R2-Z00004-Z0000005
QRXP-ITITS-DAH-VORAR-DWG-ACT-R2-Z00004-Z0000000 TO Z0000009
QRXP-ITITS-DAH-VORAR-DWG-ROD-R2-Z00004-Z0000001
QRXH1114000-HFC-DRW-SDW-TPC-02-ROS-00001 TO 00014

LEGEND:

Rev. No.	Date	Description	Appr.
0C	20-10-2025	FOR REVIEW AND APPROVAL	
--	--	--	--
--	--	--	--
--	--	--	--
--	--	--	--
--	--	--	--
--	--	--	--

Consultant
Contractor
Hail Company
ITS Contractor
TRAFFIC TECH
Project:
القديـــة Qiddiya

Job title: ACCESS ROAD TO RESORT CORE

Drawing title:
ITS SHOP DRAWINGS
ITS 7M POLE FOR RWIS & AQM DETAILS

Sheet number: SHEET 12 OF 12

Scale: NTS

Drawn: Mohamed.S	Checked: M.Sayed
Designed:	Approved:

Drawing number: QRXM114000-HFC-DRW-SDW-ITS-02-ROS-00001

Revision: 00