QIDDIYA DEVELOPMENT COMPANY						
DOCUMENT NUMBER:	QDC-ADM-TEM-QMS-00004	REVISION NUMBER:	0D	ISSUED BY:	PMO	Qiddiya
DOCUMENT TITLE	WIR FORM	DOCUMENT TYPE:	FORM	DATE ISSUED:	MAY-08-2022	

WORK INSPECTION REQUEST (WIR) FORM

Contractor:	HAIF-FREYSSINET JV
Project:	RA2RC
Contract No.:	QPMO-410-CT-00618
Work Inspection Request Number:	QRXM114000-HFC-TEC-WIR-ITS-02-RO5-00002

Haif Company Freyssinet
HAIF-FREYSSINET JV

Discipline

Architecture	☐	Mechanical	☐	Information Technology	☐	Quality	☐	Project Controls	☐
Civil / Structural	☐	Electrical	☐	Landscape	☐	Safety	☐	Construction Management	☐
Other	☑								

WORK DESCRIPTION

Inspection / Test Location:	INTERIM ROAD Sta. (1+250,2+150,2+600,4+100,4+300) Main Line -02 and Splitting		
GIS/GPS GeoTag Coordinates (If applicable)			
Inspection Date:	19-May-2026	**Inspection Start Time:**	8:30 am
ITP:	QRXM114000-HFC-TEC-ITP-ITS-02-RO5-00002	**Checklist:**	HFC-CKL-4002
Spec's / Dwg. Ref.:	QRXM114000-HFC-DRW-SDW-ITS-02-RO5-00009	**Approved Method Statement Number:**	QRXM114000-HFC-TEC-MST-ITS-02-RO5-00001
Attachments:	☑ **Drawings** ☐ **Data Sheets**	☐ **TQs/RFI**	☐ **OTHER**

DESCRITPTION OF WORK

Inspection request for Installation of Variable Message Sign (VMS)-5nos and 7mtr ITS Pole-5nos VMS-01,VMS-02 ,VMS-03 ,VMS-04 ,VMS-05 .Main Line-02 and Spiliting.

CONTRACTOR - QUALITY INSPECTOR - INITIAL INSPECTION FINDINGS:

Complies with Approved ITPs/Checklists?	● YES	○ NO	○ NA	**REMARKS**	
All Strucutral Embedded Items Cleared?	○ YES	○ NO	○ NA	**WIR Number**	
Embedded Electrical items Cleared by Electrical QC?	○ YES	○ NO	○ NA	**WIR Number**	
Embedded Mechanical Items Cleared by Mechanical QC?	○ YES	○ NO	○ NA	**WIR Number**	

Accepted:	●
Accepted with Comments (See Remarks):	○
Rejected (See Remarks):	○

REMARKS:					
Name:	Moataz Elkhateeb	**Signature:**		**Date:**	20-05-2026

QIDDIYA / SUPERVISION CONSULTANT QC INSPECTOR - FINAL INSPECTION FINDING

B: Approved with Comments
QI09043311-UPR TBN17&TNS05
Saud Nawab
Zuhair Fayez Partnership Consultants
Riyadh , Saudi Arabia

Contractor Has complied with Project spec requirements?	○ YES	○ NO	xt	○ YES	○ NO ○ NA

Accepted:	○
Accepted with Comments (See Remarks):	○ ✓
Rejected (See Remarks):	○

REMARKS:	① Comply with the comments mentioned on attached supporting documents.				
Name:	M. YASIR.	**Signature:**		**Date**	19/05/2026.

FOR DETAILED MATERIAL INSPECTION STATUS, PLEASE SEE ATTACHED CHECKLIST.
CHECKLISTS THAT ARE NOT ATTACHED AND SIGNED BY SUPERVISION CONSULTANT WILL VOID THIS INSPECTION REQUEST.

This document is the property of Qiddiya Development Company, 2022

② Final approval is subject to the acceptence of successful completion of Testing & Commissioning.

③ Provide earthing cables for VMS, Pole and ITS Cabinet.

Client:	Consultant:	Contractor:
Qiddiya	Zuhair Fayez Partnership	شركة هيف Haif Company

TECHNICAL DOCUMENTS

Project Name: Package 3 - Interim Road Access to Resort Core	**Project Code:** QRXM114000
**Location: RA2RC ** Qiddiya INTERM ROAD	**Date:** 14-February-2026
Document Title: Method of Statement for Installation and Commissioning of Intelligent Transportation System Equipment and Devices.	**Ref No: QRXM114000-HFC-TEC-MST-ITS-02-RO5-00001** **Rev No:** 00

Department: ☐ Architectural ☐ Civil/Structural ☐ Electrical ☐ Mechanical ☒ ITS ☐ Others

Type: ☐ Pre-Qualification ☒ Method Statement ☐Material Submittal ☐ Sample ☐ Other

Document Description: Method of Statement for Installation and Commissioning of Intelligent Transportation System Equipment and Devices.

Doc. Ref. No.	Title
QRXM114000-HFC-TEC-MST-ITS-02-RO5-00001	**Method of Statement for Installation and Commissioning of Intelligent Transportation System Equipment and Devices.**

Enclosure:

Submitted By:	**Received By:**
Name: Eng. Moataz	Name:
Signature:	Signature:
Date: 14-Feb-2026	Date:

Below portion for Consultant Supervision use only

Status: ☐A- Approved ☐B- Approved as noted ☐C- Revise & Resubmit ☐R- For information only

Comments:

~~1.Attach approved ITP prepaired in QIC official format.~~

2.Provided MS pertains to installation & commissiong only. Contractor to include complete testing procedure of each ITS system.

2.All the work shall be carried out in accordance with project specification & applicable standards & codes

C: Revise and Resubmit
[illegible]
[illegible]
Zuhair Fayez Partnership Consultants
Riyadh , Saudi Arabia

C: Revise and Resubmit
[illegible]
Saud Nawab
Zuhair Fayez Partnership Consultants
Riyadh , Saudi Arabia

C: Revise and Resubmit
QI09043311-UPR TBN17&TN505
[illegible]
Zuhair Fayez Partnership Consultants
Riyadh , Saudi Arabia

B: Approved with Comments
QI09043311-UPR TBN17&TNS05
Syed Walayat
Zuhair Fayez Partnership Consultants
Riyadh , Saudi Arabia

Below portion for Client use only

Comments:

Signed by: Signature: Date:

QIDDIYA DEVELOPMENT COMPANY						Qiddiya
DOCUMENT NUMBER:	QDC-ADM-TEM-QMS-00007	REVISION NUMBER:	00	ISSUED BY:	PMO	
DOCUMENT TITLE	MIR FORM	DOCUMENT TYPE:	FORM	DATE ISSUED:	MAY-08-2022	

MATERIAL INSPECTION REQUEST (MIR) FORM

Contractor:	HAIF COMPANY	شركة هيف Haif Company Freyssinet HAIF-FREYSSINET JV
Project:	QPMO-410-CT-00618- ROAD ACCESS TO RESORT CORE	
Contract No.:	QI09043311-VO-0004	
Material Inspection Request Number:	QRXM114000-HFC-TEC-MIR-ITS-02-RO5-00002	

Discipline

Architecture	☐	Mechanical	☐	Information Technology	☐	Quality	☐	Project Controls	☐		
Civil/Structural	☑	Electrical	☐	Landscape	☐	Safety	☐	Construction Management	☐		
Other	☐										

MATERIAL DESCRIPTION

Inspection / Test Location:	INTERIM ROAD MAIN LINE-02		
Material Name:	ITS -VMS, DMV	**Quantity:**	05 Pcs.
P.O Number		**Delivery Note Number:**	TTSDN-HAIF-181225-008
Approved Material Transmittal Number: (Aconex document Approval)		**Approval Date:**	
Inspection Date:	22-Jan-2026	**Inspection Start Time:**	09:00 AM
ITP:		**Checklist:**	
Spec's / Dwg. Ref.:	TRAFFIC TECH SECURITY W.L.L	**Approved Method Statement Number:**	
Attachments:	Test Certificate: ● Yes ○ No IFC / Shop Drawings: ○ Yes ● No		

DESCRITPTION OF MATERIAL

(Traffic Signals) VMS DMV With Accessories (Qty.-05) for Interim Road Main Line-02

CONTRACTOR - QUALITY INSPECTOR - INITIAL INSPECTION FINDINGS:

Are Complete Details Mentioned in P.O and Delivery Note?	● YES	○ NO	**REMARKS**	
Complies with Approved ITPs/Checklists?	● YES	○ NO	**REMARKS**	
Signs of Physcial Damage?	○ YES	● NO	**REMARKS**	
Conforms to Approved Material Submittal?	○ YES	○ NO	**REMARKS**	

Accepted:	●
Accepted with Comments:	○
Rejected (See Remarks):	○

REMARKS:					
Name:	Moataz Elkhateeb	**Signature:**		**Date:**	22-01-2026

QIDDIYA / SUPERVISION CONSULTANT QC INSPECTOR - FINAL INSPECTION FINDINGS:

Contractor Has complied with Material requirements?	○ YES	○ NO	**Materials Are Stored correctly?**	○ YES	○ NO	○ NA

Accepted:	○
Accepted with Comments:	○
Rejected (See Remarks):	○

REMARKS:					
Name:		**Signature:**		**Date**	

Attach approved MIR of VMS.

FOR DETAILED MATERIAL INSPECTION STATUS, PLEASE SEE ATTACHED CHECKLIST.
CHECKLISTS THAT ARE NOT ATTACHED AND SIGNED BY SUPERVISION CONSULTANT WILL VOID THIS INSPECTION REQUEST.

This document is the property of Qiddiya Development Company, 2022

Client:	**Consultant:**	**Contractor:**
Qiddiya	Zuhair Fayez Partnership	Haif Company Freyssinet HAIF-FREYSSINET JV

TECHNICAL DOCUMENTS

Project Name: Package 3 - **Interim Road Access to Resort Core**	**Project Code:** QRXM114000
Location: 00	**Date:** 08-November-2025
Document Title: **Material Approval Request FOR ITS SYSTEM SUPPLYING & INSTALLING BY TRAFFIC TECH SECURITY W.L.L (**Dynamic **Message** System **(DMS))**	**Ref No:** QRXM114000-HFC-TEC-MAT-ITS-02-RO5-00001 **Rev No:** 01

Department: ☐ Architectural ☐ Structural ☐ Electrical ☐ Mechanical ☑ ITS ☐ Civil

Type: ☐ Pre-Qualification ☐ Method Statement ☒ Material Submittal ☐ Sample ☐ Other

Document Description: Material Approval Request FOR ITS SYSTEM SUPPLYING & INSTALLING BY TRAFFIC TECH SECURITY W.L.L (Dynamic Message System (DMS))

Doc. Ref. No.	Title
QRXM114000-HFC-TEC-MAT-ITS-02-RO5-00001	**Material Approval Request FOR ITS SYSTEM SUPPLYING & INSTALLING BY TRAFFIC TECH SECURITY W.L.L** (Dynamic **Message** System **(DMS))**

Enclosure:

Submitted By:	**Received By:**
Name: **Eng. Moataz**	Name:
Signature:	Signature:
Date: 08-Nov-2025	Date:

Below portion for Consultant Supervision use only

Status: ☐A- Approved ☐B- Approved as noted ☐C- Revise & Resubmit ☐R- For information only

Comments:

Contractor to comply with the following comments prior to procurement.

1.The proposed DMS does not comply with the required depth size. The specification and BOQ indicate dimensions of 2.3 × 2.0 × 0.25m, whereas the proposed unit is 2.3 × 2.0 × 0.159m.Provide supporting documents to justify the proposed size.

2.Visibility range is not indicated in the data sheet. Contractor to provide actual range in compliance with project specifications.

3.~~IP rating is not mentioned in the DMS data sheet. Contractor to submit a type test report verifying compliance with outdoor installation requirem~~ents.

4.The final finish color of the DMS and all exposed units shall be as per project specifications and QIC recommendations.

5.The contractor shall ensure full compliance with the project specifications for DMS software and data storage

6.SASO/SABER certificate to be provided for subject items.

7.Warranty certificate shall be provided in accordance with the project specification.

8.Server and workstation are not included in the subject submittal. A dedicated DMS server is required as indicated in IFC riser diagram and a separate submittal shall be provided submitted.

B: Approved with Comments
Zuhair Fayez Partnership Consultants
Riyadh , Saudi Arabia

B: Approved with Comments
Zuhair Fayez Partnership Consultants
Riyadh , Saudi Arabia

Below portion for Client use only

Comments:

- Final approval subject to adherence all comments stated on document.

B: Approved with Comments
Zuhair Fayez Partnership Consultants
Riyadh , Saudi Arabia

Signed by: Signature: Date:

Client: Qiddiya	**Consultant:** Zuhair Fayez Partnership	**Contractor:** شركة هيف Haif Company Freyssinet HAIF-FREYSSINET JV

TECHNICAL DOCUMENTS

Project Name: **Package 3 - Interim Road Access to Resort Core**

Project Code: QRXM114000

Location: 00

Date: 26-March-2026

Document Title: **Inspection & Test Plan for DMS/VMS**

Ref No: QRXM114000-HFC-TEC-ITP-ITS-02-RO5-00002

Rev No: 00

Department: ☐ Architectural ☐ Structural ☐ Electrical ☐ Mechanical ☐ Authority ☒ ITS

Type: ☐ Pre-Qualification ☐ Method Statement ☐ Material Submittal ☐ Sample ☒ ITP

Document Description: This is Inspection & Test Plan for for DMS/VMS

Doc. Ref. No.	Title
QRXM114000-HFC-TEC-ITP-ITS-02-RO5-00002	**Inspection & Test Plan for for DMS/VMS**

Enclosure:

Submitted By:
Name: Eng. Moataz
Signature:
Date: 26-march-2026

Received By:
Name:
Signature:

Below portion for Consultant Supervision use only

Status: ☐A- Approved ☐B- Approved as noted ☐C- Revise & Resubmit ☐R- For information only

Comments: All the work shall be carried out in accordance with project specification

A: Approved
Q|09043811-UPR TBN17&TN505
Saud Nawab
Zuhair Fayez Partnership Consultants
Riyadh , Saudi Arabia

A: Approved
Q|09043311-UPR TBN17&TN505
Muhammad Yasir Khudima Ali
Zuhair Fayez Partnership Consultants
Riyadh , Saudi Arabia

A: Approved
[illegible]
[illegible]
Zuhair Fayez Partnership Consultants
Riyadh , Saudi Arabia

Below portion for Client use only

Comments:

Signed by:

Signature:

Date:

HAIF-FSA JV Inspection & Test Plan **Intelligent Transportation System Works for DMS INSTALLATION AND OPERATION**	I &TP **HFC-ITP-0080**	APPROVED DATE	DISCIPLINE ITS
PROJECT TITLE:WBS Access Road To Resort Core (RA2RC)	CONTRACTOR/SUBCONTRACTOR		
WIR No.	CONSTRUCTION- Intelligent Transportation System Works for INSTALLATION AND OPERATION of DMS	HAIF	

ITEM NO.	PROJECT PHASE	TASK / ACTIVITY	Quality Requirements /references/ specifications	Quality Record	INSPECTION RESPONSIBILITY ASSIGNMENTS		REMARKS
					Contractor	Consultant	
1.0 DOCUMENT REVIEW							
1		Material Approval & Shop Drawing	QRXM114000-HFC-TEC-MAT-ITS-02-RO5-00001 QRXM114000-HFC-DRW-SDW-ITS-02-RO5-00001-00086	QRXM114000-HFC-TEC-MAT-ITS-02-RO5-00001 QRXM114000-HFC-DRW-SDW-ITS-02-RO5-00001-00086	R	H	
2.0 MATERIAL RECEIVING INSPECTION							
2		Material receiving inspection, protection & storage	QD0002-ADM-TEM-QMS00007[0A] MaterialReceiving Inspection in site HFC-CKL-4001	QD0002-ADM-TEM-QMS00007[0A] MaterialReceivingInspection in siteHFC-CKL-4001	H	H	MIR to be submitted
3.0 WORK INSTALLATION							
3.1		PRE - INSTALLATION	HFC-CKL-4001	HFC-CKL-4001	H	H	
3.2		INSTALLATION	HFC-CKL-4002	HFC-CKL-4002	H	H	
3.3		TESTING	HFC-CKL-4003	HFC-CKL-4003	H	H	

GENERAL NOTES

1 Surveillance: QA/QC organization to monitor work in progress without notice from Construction Organization

2 Witness: QA/QC organization shall be notified of the timing of Inspection or test in advance. However, the inspection or test shall be performed as scheduled if the QA/QC organization representative is not present.

3 Hold: QA/QC organization shall be notified of the timing of inspection or test in advance. Inspection or test shall not be carried out without the QA/QC organization representative in attendance.

4 If the Main Contractor delegates the assigned responsibility to the Subcontractor, then the Main Contractor will have the same degree of responsibility as assigned to Consultant.

LEGEND

H	Hold Point for QC Inspection/ Test	R	Review of Documents
W	Witness Inspection/T	RH	Review & approval of Documents
S	Surveillance		

Checklist : HFC-CKL-4001	Checklist	APPROVED DATE	DISCIPLINE ITS
Material receiving inspection, protection & storage	HFC-CKL-4001		
PROJECT TITLE: Road Access To Resort Core (RA2RC)		CONTRACTOR/SUBCONTRACTOR	
WIR No.	CONSTRUCTION- ITS System Works for INSTALLATION AND OPERATION of DMS	HAIF	

ITEM NO.	Check Points & Acceptance Criteria	Reference	Pass	Fail	Not Applicable	Re-Inspection
1.0	**Material receiving inspection,protection &**					
1.1	Deliver ITS Device in packaging, protected, complying with applicable Standard.	project specification SECTION 137730 -DYNAMIC MESSAGE SGN (DMS) SYSTEM				
1.2	Store equipment in a dry location. Protect from weather,fumes, water, debris,direct exposure to the sunlight, ultraviolet,etc	project specification SECTION 137730 -DYNAMIC MESSAGE SGN (DMS) SYSTEM				
1.3	Provide necessary protection if required as per manufacturer's recommendations.	project specification SECTION 137730 -DYNAMIC MESSAGE SGN (DMS) SYSTEM				
1.4	Handle equipment and devices with care, to avoid abrasion, puncturing and tearing housing, paint.	project specification SECTION 137730 -DYNAMIC MESSAGE SGN (DMS) SYSTEM				

Remarks

PM/Contractor			QDC		
Contractor Construction			Third Party (if applicable)		
The work is ready for inspection			Document Reviewed	Work Inspected	Test Records Verified
Name	Signature	Date	Name	Signature	
Faraj					
Contractor QC Inspector			QDC Supervision Consultant		

Form Ref. No. QD0002-ADM-TEM-QTY-00003– Rev.0A

Checklist : HFC-CKL-4002	Checklist	APPROVED DATE	DISCIPLINE
INSTALLATION OF DMS	**HFC-CKL-4002**		ITS
PROJECT TITLE: Road Access To Resort Core (RA2RC)	WBS	CONTRACTOR/SUBCONTRACTOR	
WIR No.	CONSTRUCTION- ITS System Works for INSTALLATION AND OPERATION of DMS	HAIF	

ITEM NO.	Check Points & Acceptance Criteria	Reference	Pass	Fail	Not Applicable	Re-Inspection
1.0	**INSTALLATION OF ITS DEVICES - DMS**					
1.1	Are all Shop Drawings, Method Statement and Material Submittals approved?	project specification SECTION 137730 -DYNAMIC MESSAGE SGN (DMS) SYSTEM				
1.2	Verify Manufacturer and Supplier as per approved material submittal?	project specification SECTION 137730 -DYNAMIC MESSAGE SGN (DMS) SYSTEM				
1.3	Does DMS properly fits into designated area (location)?	project specification SECTION 137730 -DYNAMIC MESSAGE SGN (DMS) SYSTEM				
1.4	Are the all brackets on place and not damaged.	project specification SECTION 137730 -DYNAMIC MESSAGE SGN (DMS) SYSTEM				
1.5	Are the all mounting lugs of DMS fixed to Pole supporters	project specification SECTION 137730 -DYNAMIC MESSAGE SGN (DMS) SYSTEM				
1.6	Are the all lugs properly tightened?	project specification SECTION 137730 -DYNAMIC MESSAGE SGN (DMS) SYSTEM				
1.7	Was the installation of DMS as per the approved shop drawings?	project specification SECTION 137730 -DYNAMIC MESSAGE SGN (DMS) SYSTEM				
1.8.	Did Technical Manual received for installed materials?	project specification SECTION 137730 -DYNAMIC MESSAGE SGN (DMS) SYSTEM				

Remarks

<table>
<tr><th colspan="3">PM/Contractor</th><th colspan="3">QDC</th></tr>
<tr><td colspan="3">Contractor Construction</td><td colspan="3">Third Party (if applicable)</td></tr>
<tr><td colspan="3">The work is ready for inspection</td><td>Document Reviewed</td><td>Work Inspected</td><td>Test Records Verified</td></tr>
<tr><td>Name</td><td>Signature</td><td>Date</td><td colspan="2">Name</td><td>Signature</td></tr>
<tr><td></td><td></td><td></td><td colspan="2"></td><td></td></tr>
<tr><td colspan="3">Contractor QC Inspector</td><td colspan="3">QDC Supervision Consultant</td></tr>
</table>

Form Ref. No. QD0002-ADM-TEM-QTY-00003– Rev.0A

Checklist : HFC-CKL-4003	Checklist	APPROVED DATE	DISCIPLINE
POST INSTALLATION AND TESTING OF DMS	**HFC-CKL-4003**		ITS
PROJECT TITLE: Road Access To Resort Core (RA2RC)	WBS	CONTRACTOR/SUBCONTRACTOR	
WIR No.	CONSTRUCTION- ITS System Works for INSTALLATION AND OPERATION of DMS	HAIF	

ITEM NO.	Check Points & Acceptance Criteria	Reference	Pass	Fail	Not Applicable	Re-Inspection
1.0	**SITE ACCEPTANCE TESTING OF DMS**					
1.1	Using a light, shine a light over the Light Sensor and see if the display reads accordingly (the dispay should start increasing the brightness level).	project specification SECTION 137730 -DYNAMIC MESSAGE SGN (DMS) SYSTEM				
1.2	Set the DMS display to full white and check if all the LED's are working properly.	project specification SECTION 137730 -DYNAMIC MESSAGE SGN (DMS) SYSTEM				
1.3	Remove one LED board from DMS and wait 10 minutes for the detection scan. Check if the DMS reporting a LED board error in PC app.	project specification SECTION 137730 -DYNAMIC MESSAGE SGN (DMS) SYSTEM				
1.4	Set the fan temperature threshold to be lower than the ambient temperature, wait 10 minutes for the temperature scan. Check whether the fans have been activated.	project specification SECTION 137730 -DYNAMIC MESSAGE SGN (DMS) SYSTEM				
Test from the Control Center						
1.5	Check whether the device is registered and whether it regularly reports to the server.	project specification SECTION 137730 -DYNAMIC MESSAGE SGN (DMS) SYSTEM				
1.6.	Verification of virtual parameters and device type.	project specification SECTION 137730 -DYNAMIC MESSAGE SGN (DMS) SYSTEM				
1.7.	RTC techinque check	project specification SECTION 137730 -DYNAMIC MESSAGE SGN (DMS) SYSTEM				
1.8.	Media Browser technique check	project specification SECTION 137730 -DYNAMIC MESSAGE SGN (DMS) SYSTEM				
1.9.	Display technique check.	project specification SECTION 137730 -DYNAMIC MESSAGE SGN (DMS) SYSTEM				
1.10.	Scenarios technique check.	project specification SECTION 137730 -DYNAMIC MESSAGE SGN (DMS) SYSTEM				
1.11.	Measurements technique check.	project specification SECTION 137730 -DYNAMIC MESSAGE SGN (DMS) SYSTEM				
1.12.	LED board error check.	project specification SECTION 137730 -DYNAMIC MESSAGE SGN (DMS) SYSTEM				

Remarks

PM/Contractor Contractor Construction The work is ready for inspection			QDC Third Party (if applicable)		
			Document Reviewed	Work Inspected	Test Records Verified
Name	Signature	Date	Name	Signature	
Faraj					
Contractor QC Inspector			QDC Supervision Consultant		

Form Ref. No. QD0002-ADM-TEM-QTY-00003– Rev.0A

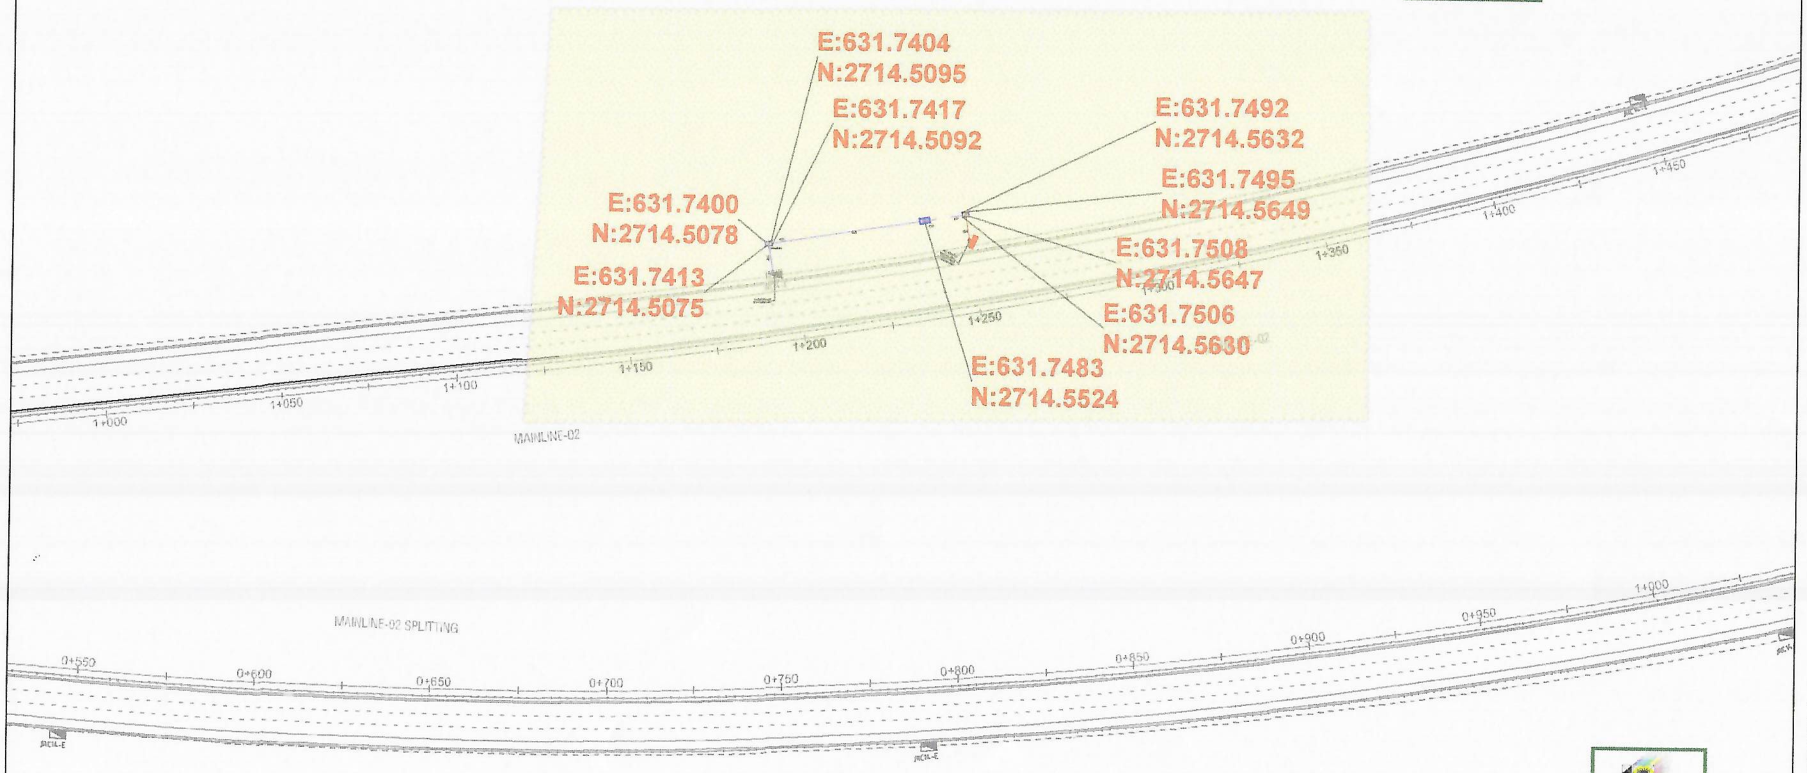
E:631.7404
N:2714.5095
E:631.7417
N:2714.5092
E:631.7400
N:2714.5078
E:631.7413
N:2714.5075
E:631.7492
N:2714.5632
E:631.7495
N:2714.5649
E:631.7508
N:2714.5647
E:631.7506
N:2714.5630
E:631.7483
N:2714.5524
1+000
1+050
1+100
1+150
1+200
1+250
1+300
1+350
1+400
1+450
MAINLINE-02
MAINLINE-02 SPLITTING
0+550
0+600
0+650
0+700
0+750
0+800
0+850
0+900
0+950
1+000
JBC1L-E

A: Approved
[illegible]
Mohamed Mesnis
Zuhair Fayez Partnership Consultants
Riyadh , Saudi Arabia

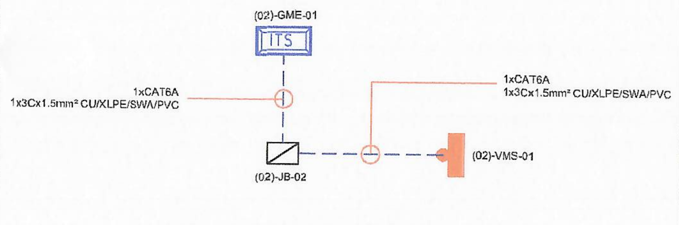
(02)-GME-01
ITS
1xCAT6A
1x3Cx1.5mm² CU/XLPE/SWA/PVC
1xCAT6A
1x3Cx1.5mm² CU/XLPE/SWA/PVC
(02)-JB-02
(02)-VMS-01

POWER & COMMUNICATION LAYOUT

For comments refer to the drawing
#QRXM114000-HFC-DRW-SDW-ITS-02-RO5-00007

[illegible]

B: Approved with Comments
[illegible]
Mohammed Yasir Khazima Ali
Zuhair Fayez Partnership Consultants
Riyadh , Saudi Arabia

B: Approved with Comments
[illegible]
Zuhair Fayez Partnership Consultants
Riyadh , Saudi Arabia

Qiddiya

Consultant's information

HEAD OFFICE - Riyadh
6283 King Abdul Aziz Rd, Ar Rabi
Riyadh 13316 2771, Saudi Arabia
Tel.: +966 11 4048484
Fax : +966 11 4048400
Website : www.zfp.com
Email.: zfpr@zfp.com

Zuhair Fayez Partnership

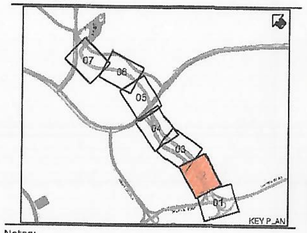
07
06
05
04
03
02
01
KEY PLAN

Notes:

1). All DIMENSIONS ARE IN METERS UNLESS OTHERWISE NOTED

REFERENCE I.F.C DRAWING NO:

QRXP1T1115-DAH-VORA2R-DWG-ITS-R2-Z00000-2001008 TO 2000007
QRXP1T1115-DAH-VORA2R-DWG-ITS-R2-Z00000-5001004
QRXP1T1115-DAH-VORA2R-DWG-ICT-R2-Z00000-2000000 TO 2000009
QRXP1T1115-DAH-VORA2R-DWG-ROD-R2-Z00000-2000301 TO 2000307
QRXP1T1115-DAH-VORA2R-DWG-ROD-R2-Z00000-2000201 TO 2000207

LEGEND:

☒	JUNCTION BOX TYPE 2 (JB)
4W	uPVC DUCT, 4 Φ100MM (POWER & COMMUNICATION)
2W	uPVC DUCT, 2 Φ100MM (POWER & COMMUNICATION)
------	ITS POWER & COMMUNICATION CABLE
🟥	VARIABLE MESSAGE SIGN (VMS)
ITS	ITS CABINET GROUND MOUNTED ENCLOSURE (GME)
	ROADWAY WEATHER INFORMATION SYSTEM (RWIS) WITH AOH
— —	6S-WAY 110mm HDPE DUCT BANK SAND ENCASED (BY OTHERS)
— —	6C-WAY 110mm HDPE DUCT BANK ROAD CROSSING (BY OTHERS) CONCRETE ENCASED (BY OTHERS)
JBC1L-E	MANHOLE TYPE JBC1L-E (BY OTHERS)

(01) - VMS - 01
DEVICE No. IN THE CORRESPONDING SHEET.
DEVICE ABBREVIATION.
SHEET No.

Rev. No.	Date	Description	Appr.
00	28-08-2025	FOR REVIEW AND APPROVAL	C
01	20-10-2025	FOR REVIEW AND APPROVAL	C
02	9-11-2025	FOR REVIEW AND APPROVAL	B
03	6-12-2025	FOR REVIEW AND APPROVAL	
--	--	--	--
--	--	--	--
--	--	--	--

Consultant
Contractor
شركة هيف
Haif Company
ITS Contractor
TRAFFIC TECH
www.traffic-tech.com
Project:
القدية
Qiddiya

Job title: ACCESS ROAD TO RESORT CORE

Drawing title: ITS SHOP DRAWINGS
ITS LAYOUT PLAN

Sheet number: SHEET 2 OF 4

Scale: 1:1000 @ A0

Drawn: M.SAYED	Checked: M.SAYED
Designed:	Approved:

Drawing number: QRXM114000-HFC-DRW-SDW-ITS-02-RO5-00009
Revision: 03

A: Approved

Mohamed Mawla

Zuhair Fayez Partnership Consultants
Riyadh , Saudi Arabia

For comments refer to the drawing
#QRXM114000-HFC-DRW-SDW-ITS-02-RO5-00007

B: Approved with Comments

Zuhair Fayez Partnership Consultants
Riyadh , Saudi Arabia

B: Approved with Comments

Zuhair Fayez Partnership Consultants
Riyadh , Saudi Arabia

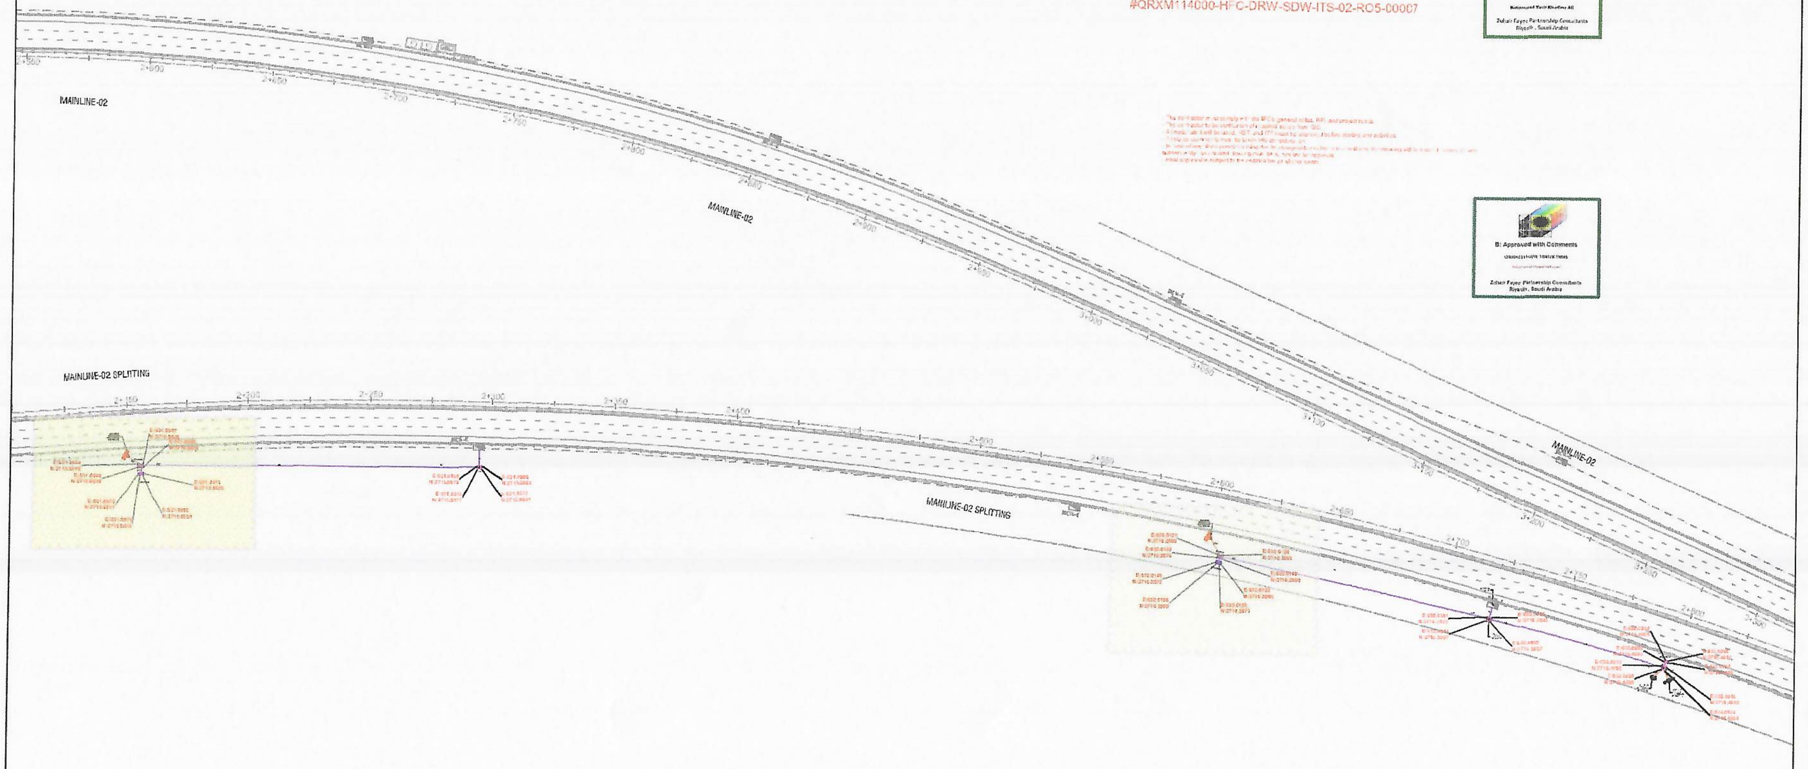
MAINLINE-02
MAINLINE-02
MAINLINE-02
MAINLINE-02 SPLITTING
MAINLINE-02 SPLITTING

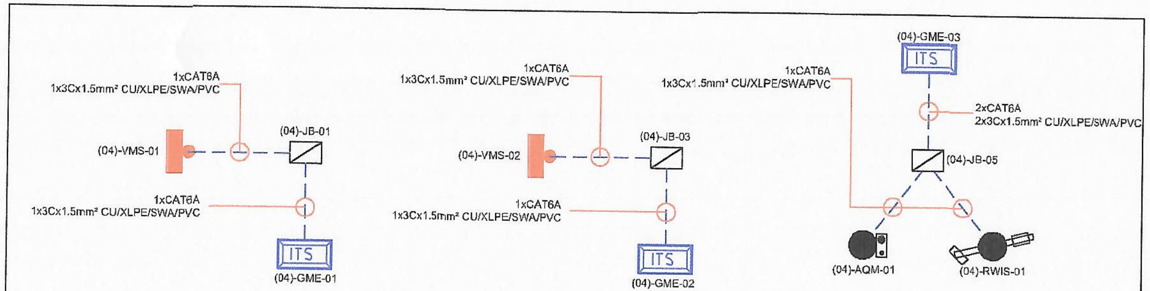
1xCAT6A
1x3Cx1.5mm² CU/XLPE/SWA/PVC
(04)-VMS-01
(04)-JB-01
1xCAT6A
1x3Cx1.5mm² CU/XLPE/SWA/PVC
ITS
(04)-GME-01
1xCAT6A
1x3Cx1.5mm² CU/XLPE/SWA/PVC
(04)-VMS-02
(04)-JB-03
1xCAT6A
1x3Cx1.5mm² CU/XLPE/SWA/PVC
ITS
(04)-GME-02
1xCAT6A
1x3Cx1.5mm² CU/XLPE/SWA/PVC
(04)-GME-03
ITS
2xCAT6A
2x3Cx1.5mm² CU/XLPE/SWA/PVC
(04)-JB-05
(04)-AQM-01
(04)-RWIS-01

POWER & COMMUNICATION LAYOUT

Qiddiya

Consultant's information
HEAD OFFICE - Riyadh
6283 King Abdul Aziz Rd, Ar Rabi
Riyadh 13316 2771, Saudi Arabia
Tel.: +966 11 4048484
Fax : +966 11 4048400
Website : www.zfp.com
Email.: zfpr@zfp.com

Zuhair Fayez Partnership

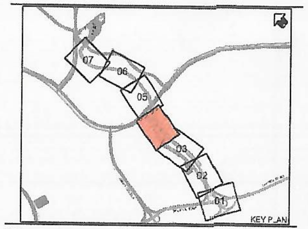
07
06
05
03
02
01
KEY PLAN

Notes:
1). All DIMENSIONS ARE IN METERS UNLESS OTHERWISE NOTED

REFERENCE I.F.C DRAWING NO:
QRXP1IT115-DAH-YQRA1R-DWG-ITS-R2-Z00000-2000001 TO 2000007
QRXP1IT115-DAH-YQRA1R-DWG-ITS-R2-Z00000-5000014
QRXP1IT115-DAH-YQRA1R-DWG-ICT-R2-Z00000-2000000 TO 2000007
QRXP1IT115-DAH-YQRA1R-DWG-ROD-R2-Z00000-2000301 TO 2000307
QRXP1IT115-DAH-YQRA1R-DWG-ROD-R2-Z00000-2000201 TO 2000207

LEGEND:
- JUNCTION BOX TYPE 2 (JB)
- uPVC DUCT, 1-Φ100MM (POWER & COMMUNICATION)
- uPVC DUCT, 2-Φ100MM (POWER & COMMUNICATION)
- ITS POWER & COMMUNICATION CABLE
- VARIABLE MESSAGE SIGN (VMS)
- ITS CABINET GROUND MOUNTED ENCLOSURE (GME)
- ROADWAY WEATHER INFORMATION SYSTEM (RWIS) WITH AQM
- 6S-WAY 110mm HDPE DUCT BANK, SAND ENCASED (BY OTHERS)
- 6C-WAY 110mm HDPE DUCT BANK ROAD CROSSING (BY OTHERS) CONCRETE ENCASED (BY OTHERS)
- MANHOLE TYPE JRC14-E (BY OTHERS)
- (01) - VMS - 01: DEVICE No. IN THE CORRESPONDING SHEET. / DEVICE ABBREVIATION. / SHEET No.

Rev. No.	Date	Description	Appr.
0C	28-08-2025	FOR REVIEW AND APPROVAL	C
01	20-10-2025	FOR REVIEW AND APPROVAL	C
02	9-11-2025	FOR REVIEW AND APPROVAL	B
03	6-12-2025	FOR REVIEW AND APPROVAL	
--	--	--	--
--	--	--	--
--	--	--	--

Consultant
Contractor
شركة هيف
Haif Company
ITS Contractor
TRAFFIC TECH
www.traffic-tech.com
Project:
القدية
Qiddiya

Job title: ACCESS ROAD TO RESORT CORE

Drawing title:
ITS SHOP DRAWINGS
ITS LAYOUT PLAN

Sheet number:
SHEET 3 OF 4

Scale: 1:1000 @ A0

Drawn: M.SAYED
Checked: M.SAYED
Designed:
Approved:

Drawing number: QRXM114000-HFC-DRW-SDW-ITS-02-RO5-00011
Revision: 03

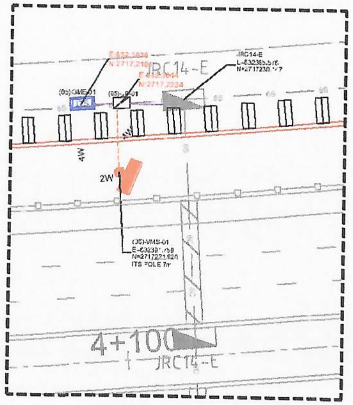
E 632,3838
N 2717,219
E 632,3844
N 2717,2234
JRC14-E
L-632365.5(6
N=2717230.1/7
(05)-GME-01
ITS
(05)-JB-01
4W
2W
(05)-VMS-01
E-632381.759
N=2717221.620
ITS POLE 7m
4+100
JRC14-E

DETAIL - A

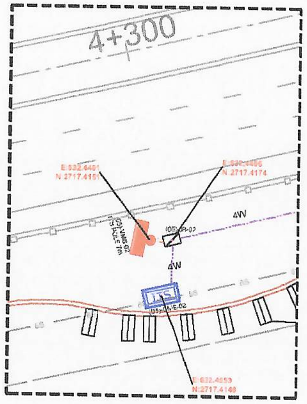
4+300
E 632,4401
N 2717,4151
E 632,4406
N 2717,4174
(05)-VMS-02
(05)-JB-02
4W
ITS
(05)-GME-02
E 632,4659
N 2717,4140

DETAIL - B

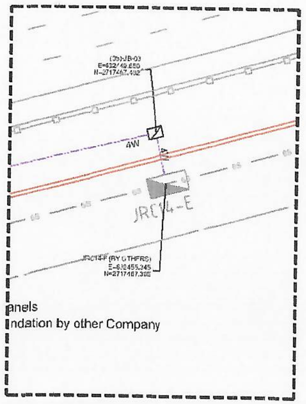
(05)-JB-03
E=632419.650
N=2717467.402
4W
JRC14-E
JRC14-E (BY OTHERS)
E=632455.245
N=2717467.302
anels
ndation by other Company

DETAIL - C

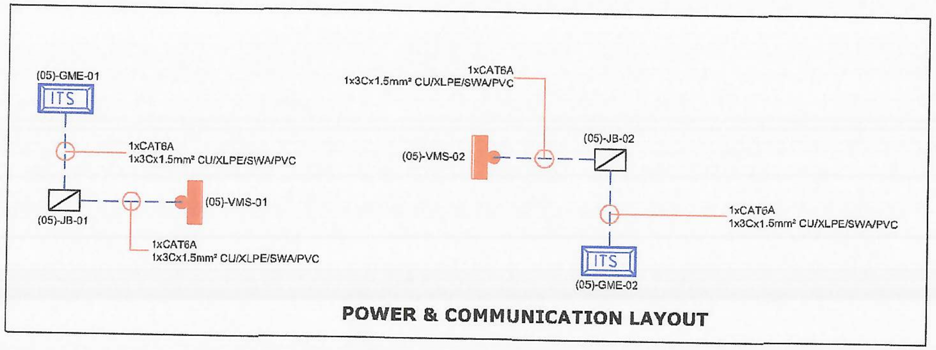
(05)-GME-01
ITS
1xCAT6A
1x3Cx1.5mm² CU/XLPE/SWA/PVC
(05)-JB-01
(05)-VMS-01
1xCAT6A
1x3Cx1.5mm² CU/XLPE/SWA/PVC
1xCAT6A
1x3Cx1.5mm² CU/XLPE/SWA/PVC
(05)-VMS-02
(05)-JB-02
1xCAT6A
1x3Cx1.5mm² CU/XLPE/SWA/PVC
ITS
(05)-GME-02

POWER & COMMUNICATION LAYOUT

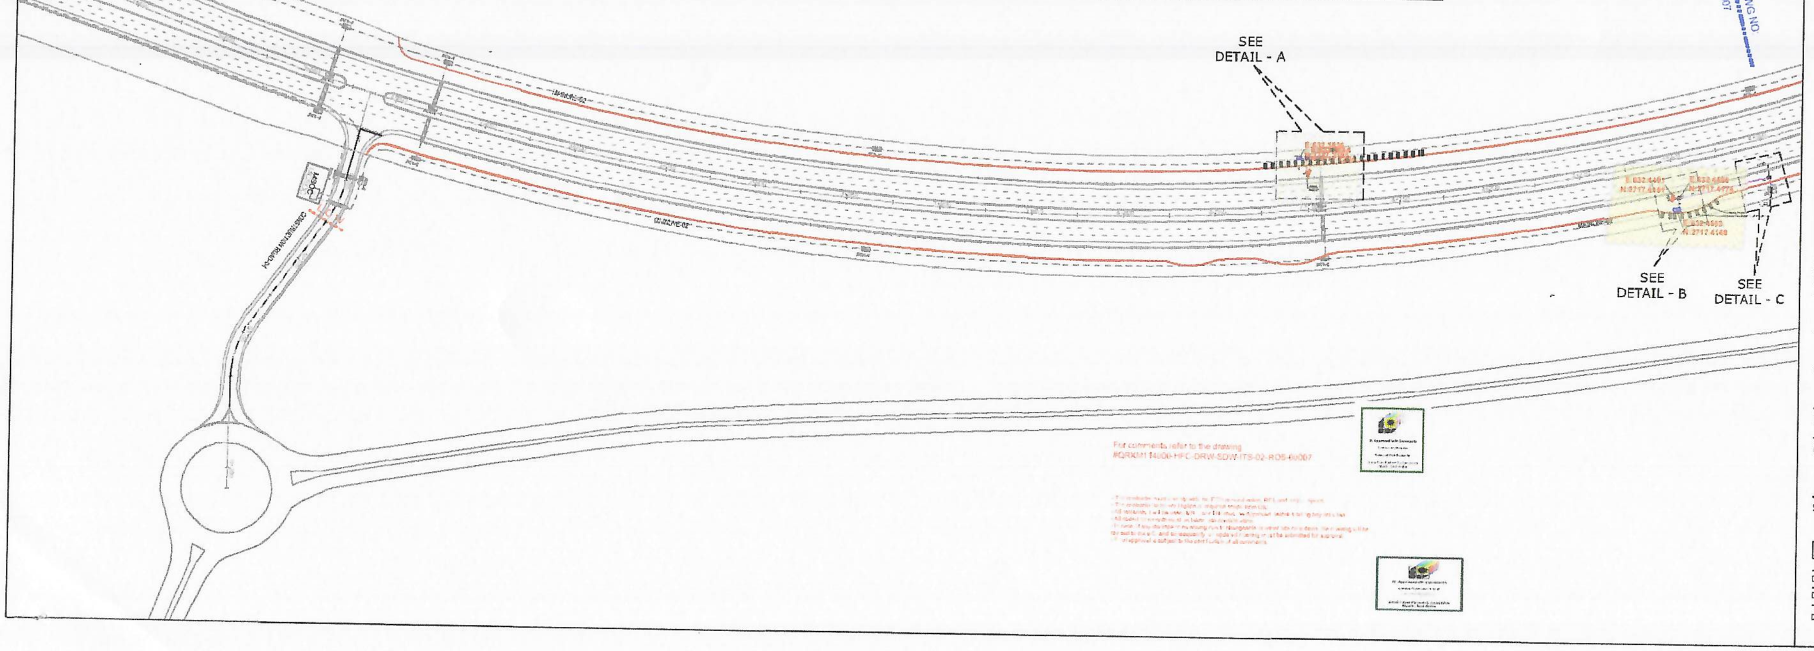
MATCHLINE FOR CONTINUATION REFER TO DWG NO.
QRXM114000-HFC-DRW-SDW-TFC-02-RO5-00005
MATCHLINE FOR CONTINUATION REFER TO DWG NO
QRXM114000-HFC-DRW-SDW-TFC-02-RO5-00007
SEE
DETAIL - A
SEE
DETAIL - B
SEE
DETAIL - C

For comments refer to the drawing
#QRXM114000-HFC-DRW-SDW-ITS-02-RO5-00007

Qiddiya

Consultant's information
HEAD OFFICE - Riyadh
6283 King Abdul Aziz Rd, Ar Rabi
Riyadh 13316 2771, Saudi Arabia
Tel.: +966 11 4048484
Fax : +966 11 4048400
Website : www.zfp.com
Email.: zfpr@zfp.com

Zuhair Fayez Partnership

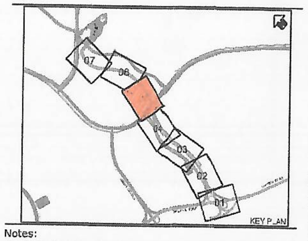
07
06
05
04
03
02
01

KEY PLAN

Notes:
1). All DIMENSIONS ARE IN METERS UNLESS OTHERWISE NOTED

REFERENCE I.F.C DRAWING NO :
QRXP1T115-DAH-YORA2R-DWG-ITS-R2-200080-2100001 TO 2000007
QRXP1T115-DAH-YORA2R-DWG-ITS-R2-200080-5100014
QRXP1T115-DAH-YORA2R-DWG-ICT-R2-200080-2000000 TO 2000009
QRXP1T115-DAH-YORA2R-DWG-ROD-R2-200080-2100301 TO 2000307
QRXP1T115-DAH-YORA2R-DWG-ROD-R2-200080-2100201 TO 2000207

LEGEND:
- JUNCTION BOX TYPE 2 (JB)
- uPVC DUCT, 4 Φ100MM (POWER & COMMUNICATION)
- uPVC DUCT, 2 Φ100MM (POWER & COMMUNICATION)
- ITS POWER & COMMUNICATION CABLE
- VARIABLE MESSAGE SIGN (VMS)
- ITS CABINET GROUND MOUNTED ENCLOSURE (GME)
- ROADWAY WEATHER INFORMATION SYSTEM (RWIS) WITH AOH
- 6S-WAY 110mm HDPE DUCT BANK; SAND ENCASED (BY OTHERS)
- 6C-WAY 110mm HDPE DUCT BANK ROAD CROSSING (BY OTHERS) CONCRETE ENCASED (BY OTHERS)
- MANHOLE TYPE JRC14-E (BY OTHERS)

(05) - VMS - 01
- DEVICE No. IN THE CORRESPONDING SHEET.
- DEVICE ABBREVIATION.
- SHEET No.

Rev. No.	Date	Description	Appr.
0C	28-08-2025	FOR REVIEW AND APPROVAL	C
01	20-10-2025	FOR REVIEW AND APPROVAL	C
02	9-11-2025	FOR REVIEW AND APPROVAL	B
03	6-12-2025	FOR REVIEW AND APPROVAL	
--	--	--	--
--	--	--	--
--	--	--	--

Consultant

Contractor
شركة هيف
Haif Company

ITS Contractor
TRAFFIC TECH
www.traffic-tech.com

Project:
القدية
Qiddiya

Job title: ACCESS ROAD TO RESORT CORE

Drawing title:
ITS SHOP DRAWINGS
ITS LAYOUT PLAN

Sheet number: SHEET 4 OF 4

Scale: 1:1000 @ A0

Drawn: M.SAYED
Checked: M.SAYED
Designed:
Approved:

Drawing number: QRXM114000-HFC-DRW-SDW-ITS-02-RO5-00012
Revision: 03

NOTES:

1. REFER TO SPECIFICATIONS FOR ADDITIONAL DETAILS RELATED TO INTELLIGENT TRANSPORTATION SYSTEM (ITS) REQUIREMENTS AND SCOPE.
2. ALL DIMENSIONS ARE IN METERS UNLESS OTHERWISE SHOWN.
3. PROVIDE STANDARD HAND HOLE AND WEATHERPROOF SERVICE ENTRANCES FOR THE SENSORS/OTHER EQUIPMENT AT LOCATIONS RECOMMENDED BY THE RWIS MANUFACTURER.
4. MINIMUM CLEARANCE BETWEEN THE RWIS/VMS POLE AND TRAVEL LANES SHALL BE AS PER MANUFACTURERS'S RECOMMENDATION.
5. RWIS/VMS STRUCTURE TO BE A POLE. POLE SHALL MEET DEFLECTION CRITERIA FOR ALL SENSORS PER MANUFACTURE'S RECOMMENDATIONS
6. RWIS/VMS STRUCTURE TO BE PROVIDED AND DESIGN IN ACCORDANCE WITH MANUFACTURE'S RECOMMENDATIONS AND PER CLIENT STANDARDS.
7. THIS DRAWING IS TO BE READ IN CONJUNCTION WITH THE SPECIFICATIONS AND ALL RELEVANT OVERSEEING ORGANIZATIONS.
8. ALL DIMENSIONS ARE TO BE CONFIRMED ON SITE BY THE CONTRACTOR PRIOR TO FABRICATION.
9. SIGN SIZE, OVERHANGS AND FIXING DETAILS ARE TO BE CONFIRMED BY THE SIGN SUPPLIER PRIOR TO FABRICATIONS OF THE POLE.
10. THE STRUCTURAL ENGINEER IS RESPONSIBLE FOR ENSURING THAT THE MINIMUM CLEARANCE DISTANCE FROM THE CARRIAGEWAY TO THE PROPOSED STRUCTURES AND CABINETS IS ADHERED TO AND DUE CONSIDERATION SHOULD BE GIVEN TO INSTALLING A SAFETY BARRIERS SYSTEM FOR THE PROTECTION OF PROPOSED ITS STRUCTURES AND CABINETS AS PER LOCAL GUIDELINES AND AUTHORITY REQUIREMENTS.
11. ANY MAINTENANCE REQUIREMENTS PER LOCAL GUIDELINES AND AUTHORITY REQUIREMENTS TO BE CONSIDERED IN THE STRUCTURAL DESIGN.

1.Size of VMS shall be as per approved material submittal.
2.The mounting height shall be as per site condition and QIC recommendation

B: Approved with Comments

Zuhair Fayez Partnership Consultants
Riyadh , Saudi Arabia

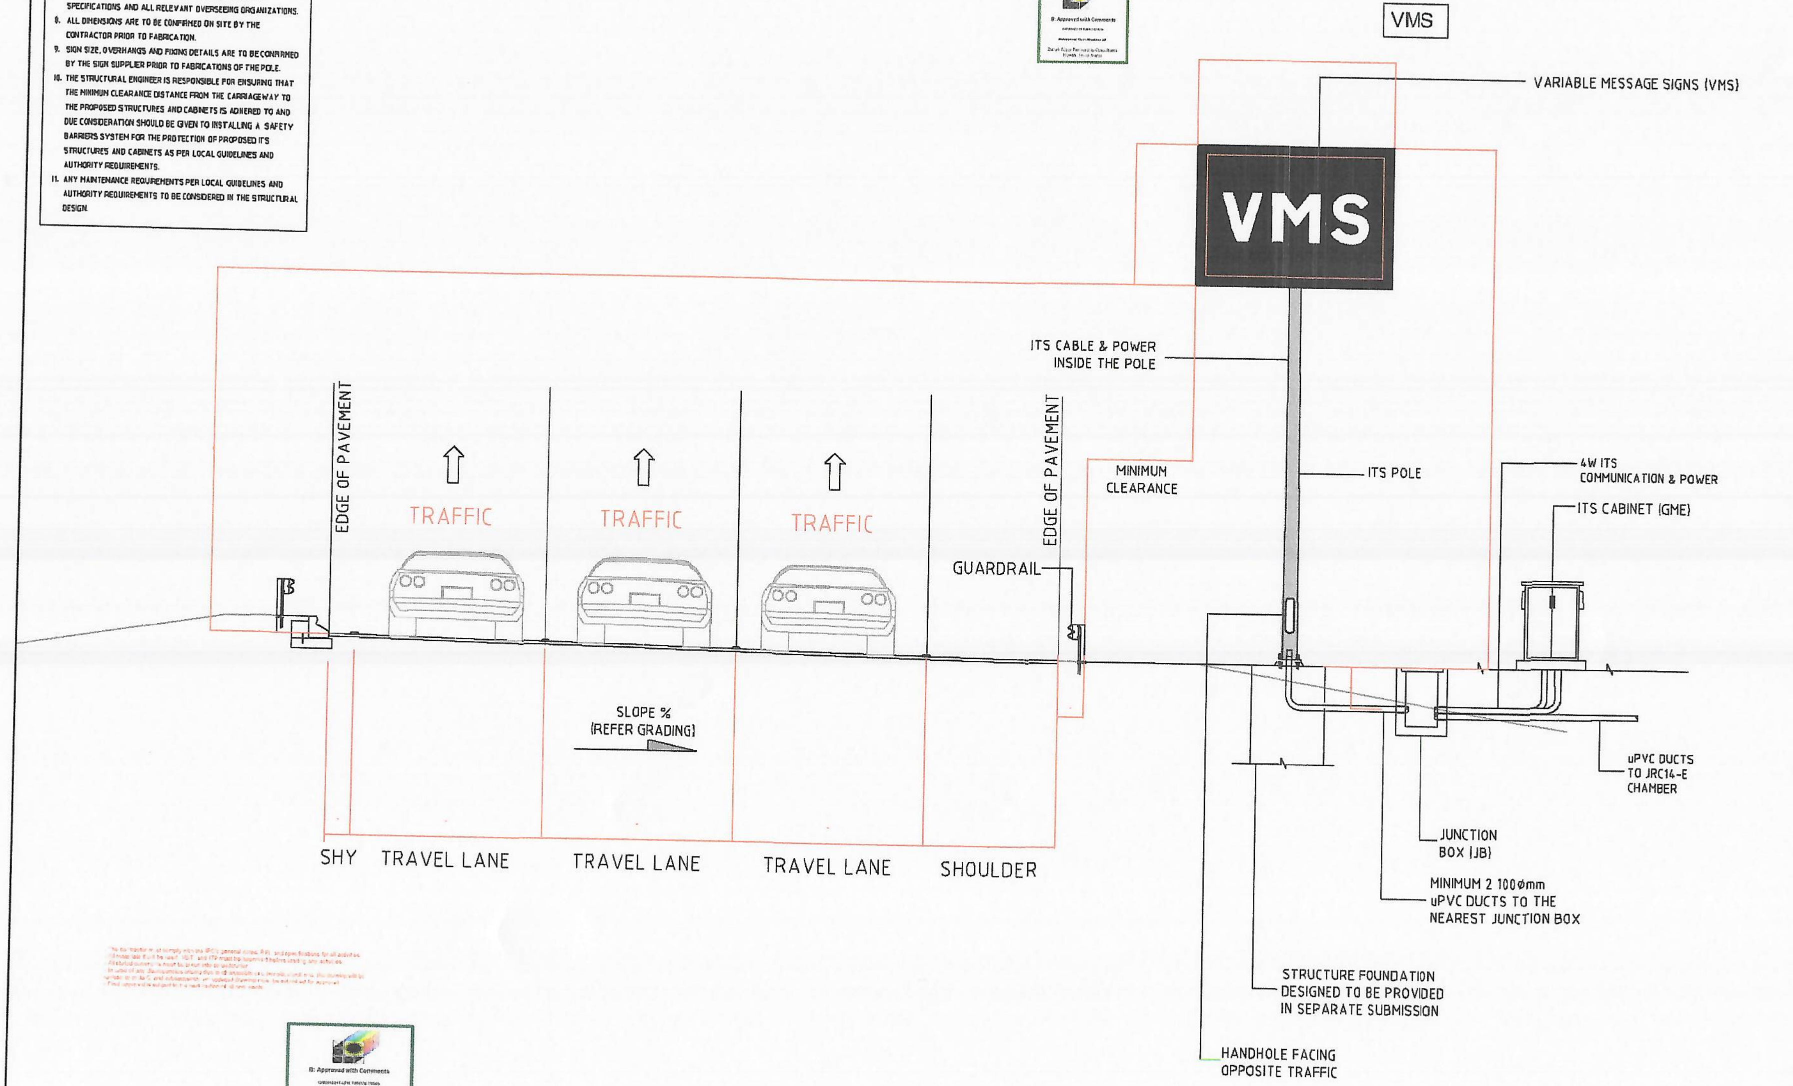
VMS
VMS
VARIABLE MESSAGE SIGNS (VMS)
ITS CABLE & POWER INSIDE THE POLE
MINIMUM CLEARANCE
ITS POLE
4W ITS COMMUNICATION & POWER
ITS CABINET (GME)
EDGE OF PAVEMENT
TRAFFIC
TRAFFIC
TRAFFIC
EDGE OF PAVEMENT
GUARDRAIL
SLOPE %
(REFER GRADING)
uPVC DUCTS TO JRC14-E CHAMBER
SHY
TRAVEL LANE
TRAVEL LANE
TRAVEL LANE
SHOULDER
JUNCTION BOX (JB)
MINIMUM 2 100ømm uPVC DUCTS TO THE NEAREST JUNCTION BOX
STRUCTURE FOUNDATION DESIGNED TO BE PROVIDED IN SEPARATE SUBMISSION
HANDHOLE FACING OPPOSITE TRAFFIC

[illegible]

B: Approved with Comments

Zuhair Fayez Partnership Consultants
Riyadh , Saudi Arabia

VARIABLE MESSAGE SIGN (VMS) ON 7m ITS POLE TYPICAL DETAILS

NOTE:
FOUNDATION DESIGN TO BE PROVIDED IN SEPARATE SUBMISSION

القدية
Qiddiya

Consultant's information

HEAD OFFICE - Riyadh
6283 King Abdul Aziz Rd, Ar Rabi
Riyadh 13316 2771, Saudi Arabia
Tel.: +966 11 4048484
Fax : +966 11 4048400
Website : www.zfp.com
Email.: zfpr@zfp.com

زهير فايز ومشاركوه
Zuhair Fayez Partnership

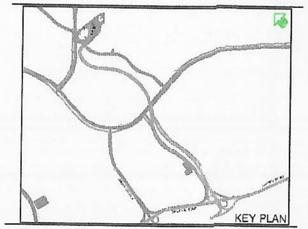

Notes:
1). All DIMENSIONS ARE IN METERS UNLESS OTHERWISE NOTED

REFERENCE I.F.C DRAWING NO:
QRXP117115-DAH-VORA2R-DWG-ITS-R2-200000-200000 TO 2000007
QRXP117115-DAH-VORA2R-DWG-ITS-R2-200000-5000004
QRXP117115-DAH-VORA2R-DWG-ITS-R2-200000-5000005
QRXP117115-DAH-VORA2R-DWG-ICT-R2-200000-2000000 TO 2000009
QRXP117115-DAH-VORA2R-DWG-ROD-R2-200000-3000001
QRXM114000-HFC-DRW-SDW-TFC-02-RO5-00001 TO 00014

LEGEND:

Rev. No.	Date	Description	Appr.
00	20-10-2025	FOR REVIEW AND APPROVAL	
--	--	--	--
--	--	--	--
--	--	--	--
--	--	--	--
--	--	--	--
--	--	--	--

Consultant

Project:

Contractor
شركة هيف
Haif Company

ITS Contractor
TRAFFIC TECH

القدية
Qiddiya

Job title: ACCESS ROAD TO RESORT CORE

Drawing title:
ITS SHOP DRAWINGS
ITS 7M POLE FOR VARIABLE MESSAGE SIGN DETAILS

Sheet number: SHEET 11 OF 12

Scale NTS

Drawn: Mohamed.S
Checked. M.Sayec
Designed:
Approved:

Drawing number: QRXM114000-HFC-DRW-SDW-ITS-02-RO5-00080
Revision 00

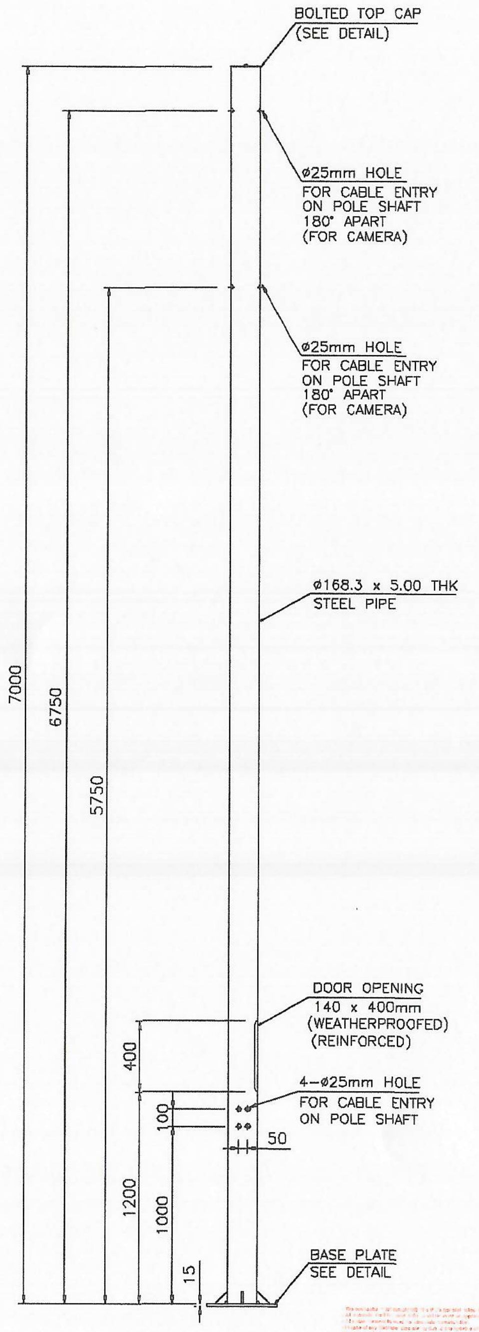
BOLTED TOP CAP
(SEE DETAIL)
ø25mm HOLE
FOR CABLE ENTRY
ON POLE SHAFT
180° APART
(FOR CAMERA)
ø25mm HOLE
FOR CABLE ENTRY
ON POLE SHAFT
180° APART
(FOR CAMERA)
ø168.3 x 5.00 THK
STEEL PIPE
DOOR OPENING
140 x 400mm
(WEATHERPROOFED)
(REINFORCED)
4-ø25mm HOLE
FOR CABLE ENTRY
ON POLE SHAFT
50
BASE PLATE
SEE DETAIL
7000
6750
5750
400
100
1200
1000
15

ITS POLE - 7M

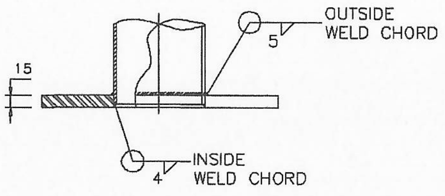
OUTSIDE
WELD CHORD
5
15
INSIDE
WELD CHORD
4

BASE PLATE/ SHAFT WELDING DETAIL

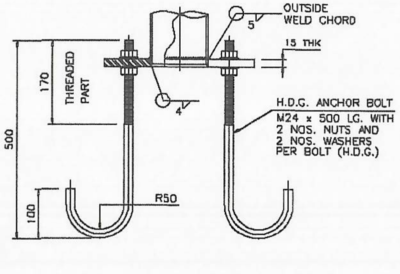
OUTSIDE
WELD CHORD
5
15 THK
170
THREADED PART
4
H.D.G. ANCHOR BOLT
M24 x 500 LG. WITH
2 NOS. NUTS AND
2 NOS. WASHERS
PER BOLT (H.D.G.)
500
100
R50

ANCHOR BOLT DETAIL

B: Approved with Comments

Pole specification shall be as per pole manufacturer recommendation

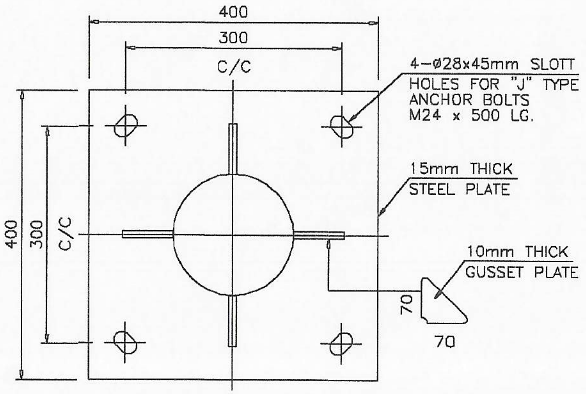
400
300
C/C
4-ø28x45mm SLOTT
HOLES FOR "J" TYPE
ANCHOR BOLTS
M24 x 500 LG.
15mm THICK
STEEL PLATE
10mm THICK
GUSSET PLATE
400
300
C/C
70
70

BASE PLATE DETAIL

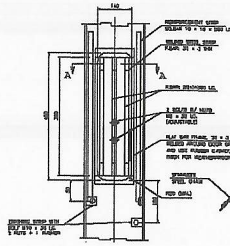
140
REINFORCEMENT STRIP
SQ.BAR 10 x 10 x 500 LG.
WELDED STEEL STRIP
F.BAR: 30 x 3 THK
A
A
F.BAR: 20x3x380 LG.
2 BOLTS W/ NUTS
M8 x 30 LG.
(ADJUSTABLE)
FLAT BAR FRAME, 30 x 3 THICK
WELDED AROUND DOOR OPENING
AND USE RUBBER GASKET, 4MM
THICK FOR WEATHERPROOFING
R20 (MIN.)
EARTHING STRIP WITH
BOLT M10 x 30 LG.
2 NUTS + 1 WASHER

DOOR OPENING DETAIL

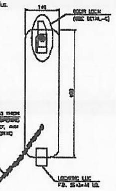
140
DOOR LOCK
(SEE DETAIL-C)
STAINLESS
STEEL CHAIN
LOCATING LUG
F.B. 25x3x40 LG.

DOOR COVER DETAIL

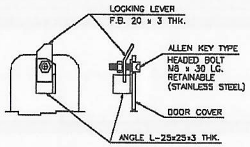
LOCKING LEVER
F.B. 20 x 3 THK.
ALLEN KEY TYPE
HEADED BOLT
M8 x 30 LG.
RETAINABLE
(STAINLESS STEEL)
DOOR COVER
ANGLE L-25x25x3 THK.

DETAIL - C (DOOR LOCK)

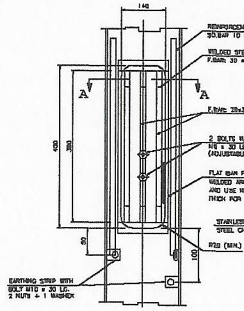
140
REINFORCEMENT STRIP
SQ.BAR 10 x 10 x 500 LG.
WELDED STEEL STRIP
F.BAR: 30 x 3 THK
A
A
F.BAR: 20x3x380 LG.
2 BOLTS W/ NUTS
M8 x 30 LG.
(ADJUSTABLE)
FLAT BAR FRAME, 30 x 3 THICK
WELDED AROUND DOOR OPENING
AND USE RUBBER GASKET, 4MM
THICK FOR WEATHERPROOFING
STAINLESS
STEEL CHAIN
R20 (MIN.)
400
380
50
100
EARTHING STRIP WITH
BOLT M10 x 30 LG.
2 NUTS + 1 WASHER

DOOR OPENING DETAIL

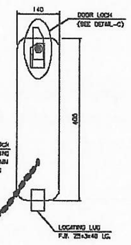
140
DOOR LOCK
(SEE DETAIL-C)
400
LOCATING LUG
F.B. 25x3x40 LG.

DOOR COVER DETAIL

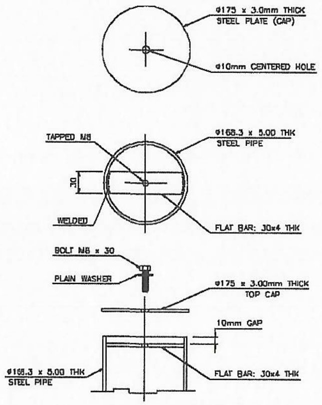
ø175 x 3.0mm THICK
STEEL PLATE (CAP)
ø10mm CENTERED HOLE
TAPPED M8
ø168.3 x 5.00 THK
STEEL PIPE
30
WELDED
FLAT BAR: 30x4 THK
BOLT M8 x 30
PLAIN WASHER
ø175 x 3.00mm THICK
TOP CAP
10mm GAP
ø168.3 x 5.00 THK
STEEL PIPE
FLAT BAR: 30x4 THK

TOP CAP DETAIL

Qiddiya

Consultant's information
HEAD OFFICE - Riyadh
6283 King Abdul Aziz Rd, Ar Rabi
Riyadh 13316 2771, Saudi Arabia
Tel.: +966 11 4048484
Fax : +966 11 4048400
Website : www.zfp.com
Email.: zfpr@zfp.com

Zuhair Fayez Partnership

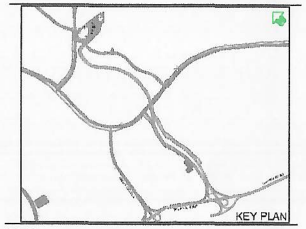

Notes:
1). All DIMENSIONS ARE IN METERS UNLESS OTHERWISE NOTED

REFERENCE I.F.C DRAWING NO:
QRXPII7115-DAH-VORA2R-DWG-ITS-R2-Z00000-2010000 TO 2000007
QRXPII7115-DAH-VORA2R-DWG-ITS-R2-Z00000-5010006
QRXPII7115-DAH-VORA2R-DWG-ITS-R2-Z00000-5010005
QRXPII7115-DAH-VORA2R-DWG-ICT-R2-Z00000-2000000 TO 2000009
QRXPII7115-DAH-VORA2R-DWG-ROD-R2-Z00000-3010001
QRXH114000-HFC-DRW-SDW-TFC-02-R05-00001 TO00014

LEGEND:

Rev. No.	Date	Description	Appr.
0C	20-10-2025	FOR REVIEW AND APPROVAL	
--	--	--	--
--	--	--	--
--	--	--	--
--	--	--	--
--	--	--	--
--	--	--	--

Consultant

Project:
Qiddiya

Contractor
Haif Company

ITS Contractor
TRAFFIC TECH
www.traffic-tech.com

Job title: ACCESS ROAD TO RESORT CORE

Drawing title:
ITS SHOP DRAWINGS
7M ITS POLE DETAILS

Sheet number: SHEET 10 OF 12

Scale: NTS

Drawn: Mohamed.S
Checked: M.Sayed
Designed:
Approved:

Drawing number: QRXM114000-HFC-DRW-SDW-ITS-02-R05-00079
Revision: 00