QIDDIYA DEVELOPMENT COMPANY					
DOCUMENT NUMBER:	QDC-ADM-TEM-QMS-00004	REVISION NUMBER:	OD	ISSUED BY:	PMO
DOCUMENT TITLE	WIR FORM	DOCUMENT TYPE:	FORM	DATE ISSUED:	MAY-08-2022

Qiddiya

WORK INSPECTION REQUEST (WIR) FORM

Contractor:	HAIF-FREYSSINET JV
Project:	RA2RC
Contract No.:	QPMO-410-CT-00618
Work Inspection Request Number:	QRXM114000-HFC-TEC-WIR-ITS-02-RO5-00046

HAIF-FREYSSINET JV

Discipline

Architecture	☐	Mechanical	☐	Information Technology	☐	Quality	☐	Project Controls	☐
Civil / Structural	☑	Electrical	☐	Landscape	☐	Safety	☐	Construction Management	☐
Other	☐								

WORK DESCRIPTION

Inspection / Test Location:	INTERIM ROAD Sta. (JUNCTION -1,2,3)		
GIS/GPS GeoTag Coordinates (If applicable)			
Inspection Date:	15-Jun-2026	Inspection Start Time:	9:30 am
ITP:	QRXM114000-HFC-TEC-ITP-ITS-02-RO5-00006	Checklist:	HFC-CKL-9003
Spec's / Dwg. Ref.:	QRXM114000-HFC-DRW-SDW-ITS-02-RO5-00015 ,24,33	Approved Method Statement Number:	QRXM114000-HFC-TEC-MST-ITS-02-RO5-00001
Attachments:	☑ Drawings ☑ Data Sheets ☐ TQs/RFI ☐ OTHER QRXM114000-HFC-DRW-SDW-CIV-02-RO5-00001		

DESCRITPTION OF WORK

Inspection request for Installing ITS Traffic Signals Controller With Accessories (3 Nos.) Junction-1,2,3 at Access to Resort core interim Road. ,Main Line-02 , As per attached drawing.

CONTRACTOR - QUALITY INSPECTOR - INITIAL INSPECTION FINDINGS:

Complies with Approved ITPs/Checklists?	◉ YES ○ NO ○ NA	REMARKS	
All Strucutral Embedded Items Cleared?	○ YES ○ NO ○ NA	WIR Number	
Embedded Electrical items Cleared by Electrical QC?	○ YES ○ NO ○ NA	WIR Number	
Embedded Mechanical Items Cleared by Mechanical QC?	○ YES ○ NO ○ NA	WIR Number	

Accepted:	◉
Accepted with Comments (See Remarks):	○
Rejected (See Remarks):	○

REMARKS:					
Name:	Moataz Elkhateeb	Signature:		Date:	15-06-2026

QIDDIYA / SUPERVISION CONSULTANT QC INSPECTOR - FINAL INSPECTION FINDINGS:

Contractor Has complied with Project spec requirements?	○ YES ○ NO	Okay to Proceed with next activity?	○ YES ○ NO ○ NA

Accepted:	○
Accepted with Comments (See Remarks):	✓
Rejected (See Remarks):	○

REMARKS:	① Traffic signal controller at Junction-3 need to be aligned with the road. ② Final approval is subject the acceptance and successful completion of Testing and commissioning.				
Name:	M-YASIR.	Signature:		Date	15/06/2026.

FOR DETAILED MATERIAL INSPECTION STATUS, PLEASE SEE ATTACHED CHECKLIST.
CHECKLISTS THAT ARE NOT ATTACHED AND SIGNED BY SUPERVISION CONSULTANT WILL VOID THIS INSPECTION REQUEST.

This document is the property of Qiddiya Development Company, 2022

Client:	Consultant:	Contractor:
Qiddiya	Zuhair Fayez Partnership	Haif Company / Freyssinet — HAIF-FREYSSINET JV

TECHNICAL DOCUMENTS

Project Name: Package 3 - Interim Road Access to Resort Core	**Project Code:** QRXM114000
Location: 00	**Date:** 4 -June-2026
Document Title: **Inspection & Test Plan for Inteligent Transportation System Works for TRAFFIC SIGNAL SYSTEM**	**Ref No:** QRXM114000-HFC-TEC-ITP-ITS-00006
	Rev No: 00

Department: ☐ Architectural ☐ Structural ☒ Electrical ☐ Mechanical ☐ Authority ☐ Civil

Type: ☐ Pre-Qualification ☐ Method Statement ☐ Material Submittal ☐ Sample ☒ ITP

Document Description: This is Inspection&Test Plan for Inspection&Test Plan for Inteligent Transportation system Works for TRAFFIC SIGNAL SYSTEM

Doc. Ref. No.	Title
QRXM114000-HFC-TEC-ITP-ITS-00005	**Inspection&Test Plan for Inteligent Transportation system Works for TRAFFIC SIGNAL SYSTEM**

Enclosure:

Submitted By:	**Received By:**
Name: Eng. Moataz Signature: Date: 4 -June-2026	Name: Signature: Date:

Below portion for Consultant Supervision use only

Status: ☐A- Approved ☐B- Approved as noted ☐C- Revise & Resubmit ☐R- For information only

Comments: All the work shall be carried out inaccordance with project specification, relevant standards & codes and manufacturer recommendations.

A: Approved — Zuhair Fayez Partnership Consultants, Riyadh , Saudi Arabia

A: Approved — Saud Nawab — Zuhair Fayez Partnership Consultants, Riyadh , Saudi Arabia

A: Approved — Zuhair Fayez Partnership Consultants, Riyadh , Saudi Arabia

Below portion for Client use only

Comments:

Signed by: Signature: Date:

HAIF-FSA JV Inspection & Test Plan								
Inteligent Transportation System Works for TRAFFIC SIGNAL SYSTEM					I &TP	APPROVED DATE	**DISCIPLINE ITS**	
PROJECT TITLE:WBS Access Road To Resort Core (RA2RC)					**HFC-ITP-090**			
WIR No.					CONTRACTOR/SUBCONTRACTOR			
					CONSTRUCTION- Intelligent Transportation System Works for TRAFFIC SIGNAL SYSTEM		HAIF	

ITEM NO.	PROJECT PHASE	TASK / ACTIVITY	Quality Requirements /references/ specifications	Quality Record	INSPECTION RESPONSIBILITY ASSIGNMENTS			REMARKS
					Contractor	Third Party	Consultant	
1.0 DOCUMENT REVIEW								
1.1		Material Approval & Shop Drawing - Emergency Vehicle Detection System	QRXP117115-DAH-VORA2R-SPE-INF-R1-Z00000-000001-0B Section 137780 Emergency Vehicle Detection System IFC Drawings QRXP117115-DAH-VORA2R-DWG-ITS-R3-Z00000-2000001 QRXP117115-DAH-VORA2R-DWG-ITS-R3-Z00000-2000002 QRXP117115-DAH-VORA2R-DWG-ITS-R3-Z00000-2000003	QRXM114000-HFC-TEC-MAT-ITS-02-R05-00009 Material Approval Request for EMERGENCY VEHICLE PREEMPTION SYSTEM Approved SHOP DRAWINGS QRXP117115-DAH-VORA2R-DWG-ITS-R3-Z00000-2000001 QRXP117115-DAH-VORA2R-DWG-ITS-R3-Z00000-2000002 QRXP117115-DAH-VORA2R-DWG-ITS-R3-Z00000-2000003	R		H	
1.2		Material Approval & Shop Drawing - Traffic Signal Controller	SHC 306 Section 12.2.3.1 Traffic Signal Controllers IFC Drawings QRXP117115-DAH-VORA2R-DWG-ITS-R3-Z00000-2000001 QRXP117115-DAH-VORA2R-DWG-ITS-R3-Z00000-2000002 QRXP117115-DAH-VORA2R-DWG-ITS-R3-Z00000-2000003	QRXM114000-HFC-TEC-MAT-ITS-02-R05-00007 Material Approval Request for TRAFFIC SIGNAL CONTROLLER Approved SHOP DRAWINGS: QRXP117115-DAH-VORA2R-DWG-ITS-R3-Z00000-2000001 QRXP117115-DAH-VORA2R-DWG-ITS-R3-Z00000-2000002 QRXP117115-DAH-VORA2R-DWG-ITS-R3-Z00000-2000003	R		H	
1.3		Material Approval & Shop Drawing - Transit Signal Priority System	QRXP117115-DAH-VORA2R-SPE-INF-R1-Z00000-000001-0B Section 137750 TRANSIT SIGNAL PRIORITY SYSTEM IFC Drawings QRXP117115-DAH-VORA2R-DWG-ITS-R3-Z00000-2000001 QRXP117115-DAH-VORA2R-DWG-ITS-R3-Z00000-2000002 QRXP117115-DAH-VORA2R-DWG-ITS-R3-Z00000-2000003	QRXM114000-HFC-TEC-MAT-ITS-02-R05-00011 Material Approval Request for TRANSIT SIGNAL PRIORITY SYSTEM Approved SHOP DRAWINGS: QRXP117115-DAH-VORA2R-DWG-ITS-R3-Z00000-2000001 QRXP117115-DAH-VORA2R-DWG-ITS-R3-Z00000-2000002 QRXP117115-DAH-VORA2R-DWG-ITS-R3-Z00000-2000003	R		H	

HAIF-FSA JV Inspection & Test Plan					I &TP		APPROVED DATE	DISCIPLINE
Intelligent Transportation System Works for TRAFFIC SIGNAL SYSTEM					**HFC-ITP-090**			**ITS**
PROJECT TITLE:WBS Access Road To Resort Core (RA2RC)					CONTRACTOR/SUBCONTRACTOR			
WIR No.					CONSTRUCTION- Intelligent Transportation System Works for TRAFFIC SIGNAL SYSTEM		HAIF	

ITEM NO.	PROJECT PHASE	TASK / ACTIVITY	Quality Requirements /references/ specifications	Quality Record	INSPECTION RESPONSIBILITY ASSIGNMENTS			REMARKS
					Contractor	Third Party	Consultant	
1.0 DOCUMENT REVIEW								
1.4		Material Approval & Shop Drawing - Pedestrian Push Button	SHC 306 Section 12.2.3.3 R Pedestrian Push Button IFC Drawings QRXP117115-DAH-VORA2R-DWG-ITS-R3-Z00000-2000001 QRXP117115-DAH-VORA2R-DWG-ITS-R3-Z00000-2000002 QRXP117115-DAH-VORA2R-DWG-ITS-R3-Z00000-2000003	QRXM114000-HFC-TEC-MAT-ITS-02-R05-00013 Material Approval Request for PEDESTRIAN PUSH BUTTON Approved SHOP DRAWINGS: QRXP117115-DAH-VORA2R-DWG-ITS-R3-Z00000-2000001 QRXP117115-DAH-VORA2R-DWG-ITS-R3-Z00000-2000002 QRXP117115-DAH-VORA2R-DWG-ITS-R3-Z00000-2000003	R		H	
1.5		Material Approval & Shop Drawing - Traffic Signal Head	SHC 306 Section 12.2.1.1 Signalization Equipment IFC Drawings QRXP117115-DAH-VORA2R-DWG-ITS-R3-Z00000-2000001 QRXP117115-DAH-VORA2R-DWG-ITS-R3-Z00000-2000002 QRXP117115-DAH-VORA2R-DWG-ITS-R3-Z00000-2000003	QRXM114000-HFC-TEC-MAT-ITS-02-R05-00014 Material Approval Request for TRAFFIC SIGNAL HEAD Approved SHOP DRAWINGS: QRXP117115-DAH-VORA2R-DWG-ITS-R3-Z00000-2000001 QRXP117115-DAH-VORA2R-DWG-ITS-R3-Z00000-2000002 QRXP117115-DAH-VORA2R-DWG-ITS-R3-Z00000-2000003	R		H	
1.6		Material Approval & Shop Drawing - Traffic Signal Poles and Gantries	SHC 306 Section 12.2.2 Supporting Structure Specifications IFC Drawing QRXP117115-DAH-VORA2R-DWG-GEN-R3-Z00000-5000006	QRXM114000-HFC-TEC-MAT-ITS-02-R05-00015 Material Approval Request for TRAFFIC SIGNAL POLES AND GANTRIES Approved SHOP DRAWINGS: QRXM114000-HFC-DRW-SDW-ITS-02-R05-00019-R02 QRXM114000-HFC-DRW-SDW-ITS-02-R05-00031-R01 QRXM114000-HFC-DRW-SDW-ITS-02-R05-00044-R01	R		H	

HAIF-FSA JV Inspection & Test Plan					I &TP	APPROVED DATE	DISCIPLINE
Inteligent Transportation System Works for TRAFFIC SIGNAL SYSTEM					**HFC-ITP-090**		**ITS**
PROJECT TITLEWBS Access Road To Resort Core (RA2RC)					CONTRACTOR/SUBCONTRACTOR		
WIR No.					CONSTRUCTION- Intelligent Transportation System Works for TRAFFIC SIGNAL SYSTEM	HAIF	

ITEM NO.	PROJECT PHASE	TASK / ACTIVITY	Quality Requirements /references/ specifications	Quality Record	INSPECTION RESPONSIBILITY ASSIGNMENTS			REMARKS
					Contractor	Third Party	Consultant	
1.0 DOCUMENT REVIEW								
1.7		Material Approval & Shop Drawing - Vehicle Video Detection System	QRXP117115-DAH-VORA2R-SPE-INF-R1-Z00000-000001-0B Section 137714 VEHICLE DETECTION SYSTEM IFC Drawing QRXP117115-DAH-VORA2R-DWG-GEN-R3-Z00000-5000006	QRXM114000-HFC-TEC-MAT-ITS-02-R05-00010 Material Approval Request for VEHICLE VIDEO DETECTION SYSTEM Approved SHOP DRAWINGS: QRXM114000-HFC-DRW-SDW-ITS-02-R05-00019-R02 QRXM114000-HFC-DRW-SDW-ITS-02-R05-00031-R01 QRXM114000-HFC-DRW-SDW-ITS-02-R05-00044-R01	R		H	
2.0 MATERIAL RECEIVING INSPECTION								
2		Material receiving inspection, protection & storage	QD0002-ADM-TEM-QMS00007[0A] MaterialReceiving Inspection in site HFC-CKL-9001	QD0002-ADM-TEM-QMS00007[0A] MaterialReceivingInspection in site HFC-CKL-9001	H		H	MIR to be submitted
3.0 WORK INSTAILATION								
3.1		PRE - INSTALLATION	HFC-CKL-9002	HFC-CKL-9002	H		H	
3.2		INSTALLATION	HFC-CKL-9003	HFC-CKL-9003	H		H	
3.3		TESTING	HFC-CKL-9004	HFC-CKL-9004	H		H	

GENERAL NOTES

1	Surveillance: QA/QC organization to monitor work in progress without notice from Construction Organization
2	Witness: QA/QC organization shall be notified of the timing of Inspection or test in advance. However, the inspection or test shall be performed as scheduled if the QA/QC organization representative is not present
3	Hold: QA/QC organization shall be notified of the timing of inspection or test in advance. Inspection or test shall not be carried out without the QA/QC organization representative in attendance.
4	If the Main Contractor delegates the assigned responsibility to the Subcontractor, then the Main Contractor will have the same degree of responsibility as assigned to Consultant.

LEGEND

H	Hold Point for QC Inspection/ Test	R	Review of Documents
W	Witness Inspection/T	RH	Review & approval of Documents
S	Surveillance		

Checklist : HFC-CKL-9003

INSTALLATION OF TRAFFIC SIGNAL SYSTEM

PROJECT TITLE: Road Access To Resort Core (RA2RC)	Checklist: HFC-CKL-9003	APPROVED DATE:	DISCIPLINE: ITS
WIR No.	WBS	CONTRACTOR/SUBCONTRACTOR	


CONSTRUCTION-
Intelligent Transportation System Works for INSTALLATION AND OPERATION of TRAFFIC SIGNAL SYSTEM — HAIF

ITEM NO.	Check Points & Acceptance Criteria	Reference	Pass	Fail	Not Applicable	Re-Inspection
1.0	**INSTALLATION OF TRAFFIC SIGNAL SYSTEM - EMERGENCY VEHICLE PRE-EMPTION SYSTEM (EVPS)**					
1.1	Are all Shop Drawings, Method Statement and Material Submittals were approved ?	SHC 306 SECTION 12.TRAFFIC SIGNALS, 12.2 SPEFICIFICATIONS	–			
1.2	Are all EVPS equipment firmly secured?	QRXP117115-DAH-VORA2R-SPE-INF-R1-Z00000-000001-0H SECTION 137780 EMERGENCY VEHICLE PREEMPTION (EVP) SYETEM PART 3 EXECUTION 3.1 INSTALLATION	–			
1.3	Is installation performed in accordance with the applicable standards, requirements, manufacturers' guidelines and any authorities having jurisdiction	QRXP117115-DAH-VORA2R-SPE-INF-R1-Z00000-000001-0H SECTION 137780 EMERGENCY VEHICLE PREEMPTION (EVP) SYETEM PART 3 EXECUTION 3.1 INSTALLATION	–			
1.4	Are all EVPS components labeled and marked?	QRXP117115-DAH-VORA2R-SPE-INF-R1-Z00000-000001-0H SECTION 137780 EMERGENCY VEHICLE PREEMPTION (EVP) SYETEM PART 3 EXECUTION 3.1 INSTALLATION	–			
1.5	Are all EVPS fittings and accessories,have been installed as per requirements for proper,safe, and reliable operation of the system?	QRXP117115-DAH-VORA2R-SPE-INF-R1-Z00000-000001-0H SECTION 137780 EMERGENCY VEHICLE PREEMPTION (EVP) SYETEM PART 3 EXECUTION 3.1 INSTALLATION	–			
1.6	Ensure safe ingress and egress from all work areas are maintained during movement and installation of equipment/materials	QRXP117115-DAH-VORA2R-SPE-INF-R1-Z00000-000001-0H SECTION 137780 EMERGENCY VEHICLE PREEMPTION (EVP) SYETEM PART 3 EXECUTION 3.1 INSTALLATION	–			
1.7	Are the EVPS structural details installed as per approved Shop drawings?	QRXP117115-DAH-VORA2R-SPE-INF-R1-Z00000-000001-0H SECTION 137780 EMERGENCY VEHICLE PREEMPTION (EVP) SYETEM PART 3 EXECUTION 3.1 INSTALLATION	–			
1.8	Are the EVPS cameras installed on the support structure as per manufacturer's instructions?	QRXP117115-DAH-VORA2R-SPE-INF-R1-Z00000-000001-0H SECTION 137780 EMERGENCY VEHICLE PREEMPTION (EVP) SYETEM PART 3 EXECUTION 3.1 INSTALLATION	–			
1.9	Are conductors, control and signal cables installed as per manufacturer's instruction?	QRXP117115-DAH-VORA2R-SPE-INF-R1-Z00000-000001-0H SECTION 137780 EMERGENCY VEHICLE PREEMPTION (EVP) SYETEM PART 3 EXECUTION 3.1 INSTALLATION	–			
1.10	Are patch cords, cables have been properly labeled as per specifications and approved shop drawings?	QRXP117115-DAH-VORA2R-SPE-INF-R1-Z00000-000001-0H SECTION 137780 EMERGENCY VEHICLE PREEMPTION (EVP) SYETEM PART 3 EXECUTION 3.1 INSTALLATION	–			
1.11	Are the connections completed on numbered terminal strips in junction, pull, and outlet boxes; terminal cabinets; and equipment enclosures?	QRXP117115-DAH-VORA2R-SPE-INF-R1-Z00000-000001-0H SECTION 137780 EMERGENCY VEHICLE PREEMPTION (EVP) SYETEM PART 3 EXECUTION 3.1 INSTALLATION	–			

Remarks

PM/Contractor			QDC		
Contractor Construction			**Third Party (if applicable)**		
The work is ready for Inspection			**Document Reviewed**	**Work Inspected**	**Test Records Verified**
Name: Mutharis	Signature	Date: 15/6/26	Name: M. YASIR.	Signature	15/06/2026
Contractor QC Inspector			QDC Supervision Consultant		

Form Ref. No. QD0002-ADM-TEM-QTY-00003– Rev.0A

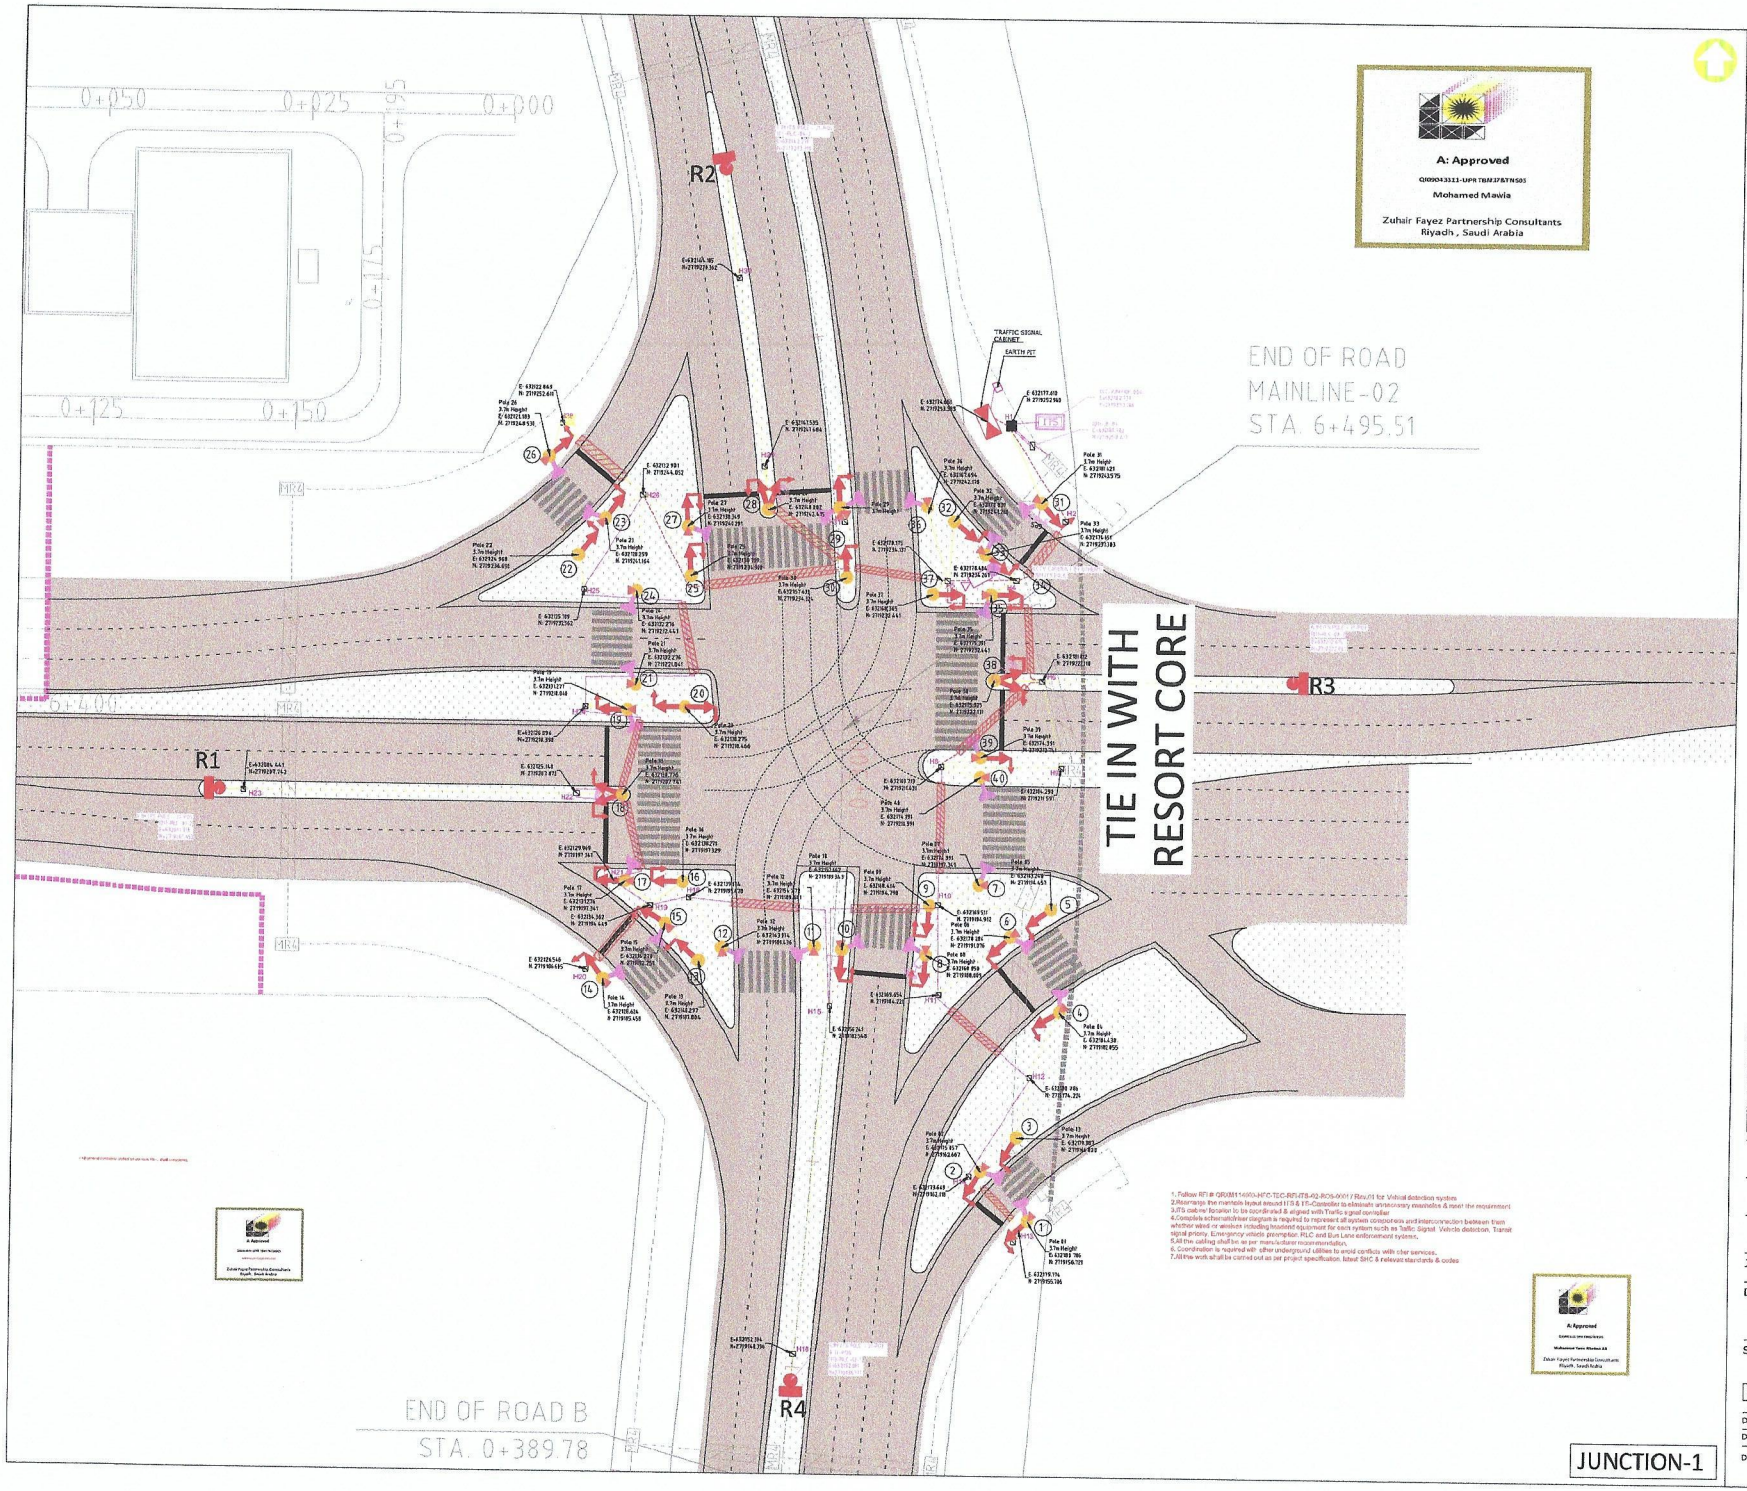

A: Approved
QI09043321-UPR TBM37&TN505
Mohamed Mawia
Zuhair Fayez Partnership Consultants
Riyadh , Saudi Arabia

Qiddiya

Consultant's information

HEAD OFFICE - Riyadh
6283 King Abdul Aziz Rd, Ar Rabi
Riyadh 13316 2771, Saudi Arabia
Tel.: +966 11 4048484
Fax : +966 11 4048400
Website : www.zfp.com
Email.: zfpr@zfp.com

Zuhair Fayez Partnership

Notes:
1. ALL DIMENSIONS ARE IN MILLIMETER UNLESS OTHERWISE STATED.
2. ALL LEVELS ARE IN METERS UNLESS NOTED OTHERWISE.
3. THIS DRAWINGS IS TO BE READ IN CONJUNCTION WITH ALL RELEVANT ARCHITECTURAL, STRUCTURAL AND SERVICES DRAWINGS.

REFERENCE I.F.C DESIGN DRAWING NO:
1. QRXP117115-DAH-VORA2R-DWG-ITS-R3-Z00000-2000001
2. QRXP117115-DAH-VORA2R-DWG-ITS-R3-Z00000-5000001
3. QRXP117115-DAH-VORA2R-DWG-ITS-R3-Z00000-5000005
4. QRXP117115-DAH-VORA2R-DWG-ITS-R3-Z00000-5000006
5. QRXP117115-DAH-VORA2R-DWG-ITS-R3-Z00000-6000001
6. QRXP117115-DAH-VORA2R-DWG-ICT-R3-Z00000-2000000

LEGEND:

Rev. No.	Date	Description	Appr.
00	30-8-2025	FOR REVIEW AND APPROVAL	C
01	06-10-2025	FOR REVIEW AND APPROVAL	B
02	04-11-2025	FOR REVIEW AND APPROVAL	B
03	04-02-2026	FINAL REVISION	
--	--	--	--
--	--	--	--
--	--	--	--

Consultant
Contractor: Hail Company
ITS Contractor: TRAFFIC TECH
Project: Qiddiya

Job title: Road Access To Resort Core


Drawing title: SHOPDRAWING OF TRAFFIC SIGNAL SYSTEM FOR JUNCTION-1

Sheet number: SHEET 1 / 18

Scale:1:1000 @ A0

Drawn: M.Elsayed | Checked: M.Abuzaid
Designed: | Approved:

Drawing number: QRXM114000-HFC-DRW-SDW-ITS-02-RO5-00015 | Revision 03

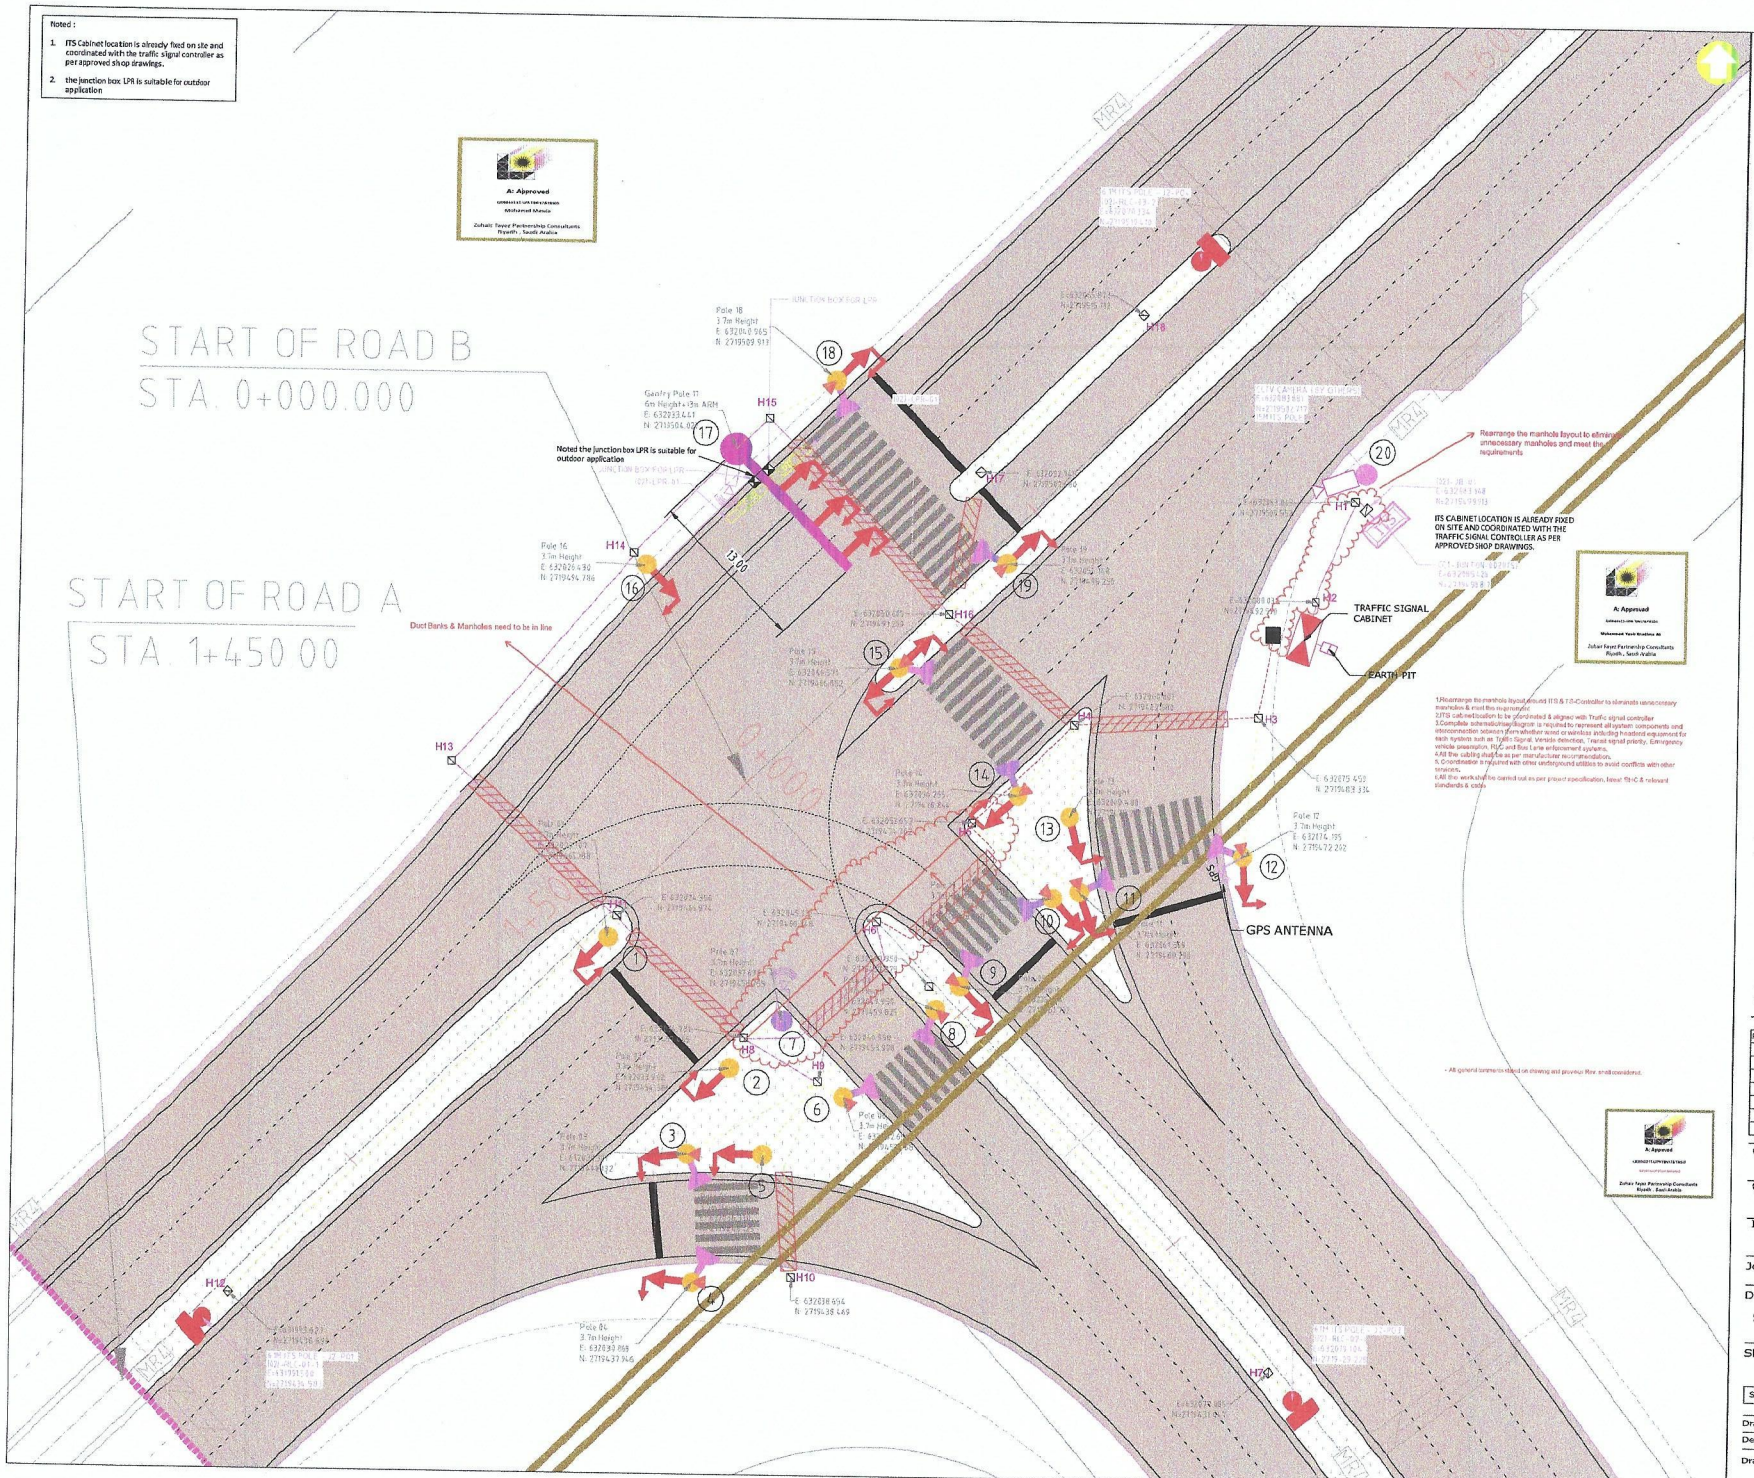

القديـــة
Qiddiya

Consultant's information

HEAD OFFICE - Riyadh
6283 King Abdul Aziz Rd, Ar Rabi
Riyadh 13316 2771, Saudi Arabia
Tel.: +966 11 4048484
Fax : +966 11 4048400
Website : www.zfp.com
Email.: zfpr@zfp.com

Zuhair Fayez Partnership

Notes:
1. ALL DIMENSIONS ARE IN MILLIMETER UNLESS OTHERWISE STATED.
2. ALL LEVELS ARE IN METERS UNLESS NOTED OTHERWISE.
3. THIS DRAWINGS IS TO BE READ IN CONJUNCTION WITH ALL RELEVANT ARCHITECTURAL, STRUCTURAL AND SERVICES DRAWINGS.

REFERENCE I.F.C DESIGN DRAWING NO:
1. QJKXP117115-DAH-VORA2R-DWG-ITS-R3-Z00000-2000002
2. QJKXP117115-DAH-VORA2R-DWG-ITS-R3-Z00000-5000001
3. QJKXP117115-DAH-VORA2R-DWG-ITS-R3-Z00000-5000002
4. QJKXP117115-DAH-VORA2R-DWG-ITS-R3-Z00000-5000005
5. QJKXP117115-DAH-VORA2R-DWG-ITS-R3-Z00000-5000006
6. QJKXP117115-DAH-VORA2R-DWG-ITS-R3-Z00000-6000001
7. QJKXP117115-DAH-VORA2R-DWG-ITS-R3-Z00000-6000002
8. QJKXP117115-DAH-VORA2R-DWG-ICT-R3-Z00000-2000000

LEGEND:

Rev. No.	Date	Description	Appr.
00	30-8-2025	FOR REVIEW AND APPROVAL	C
01	04-11-2025	FOR REVIEW AND APPROVAL	B
02	04-02-2026	FINAL REVISION	--
--	--	--	--
--	--	--	--
--	--	--	--
--	--	--	--

Consultant
Contractor
Hail Company
ITS Contractor
TRAFFIC TECH
Project:
القديـــة Qiddiya

Job title: Road Access To Resort Core

Drawing title: SHOPDRAWING OF TRAFFIC SIGNAL SYSTEM FOR JUNCTION-2


Sheet number: SHEET 1 / 19

Scale: 1:1000 @ A0

Drawn: M.Elsayed	Checked: M.Abuzaid
Designed:	Approved:

Drawing number: QRXM114000-HFC-DRW-SDW-ITS-02-RO5-00024

Revision 02

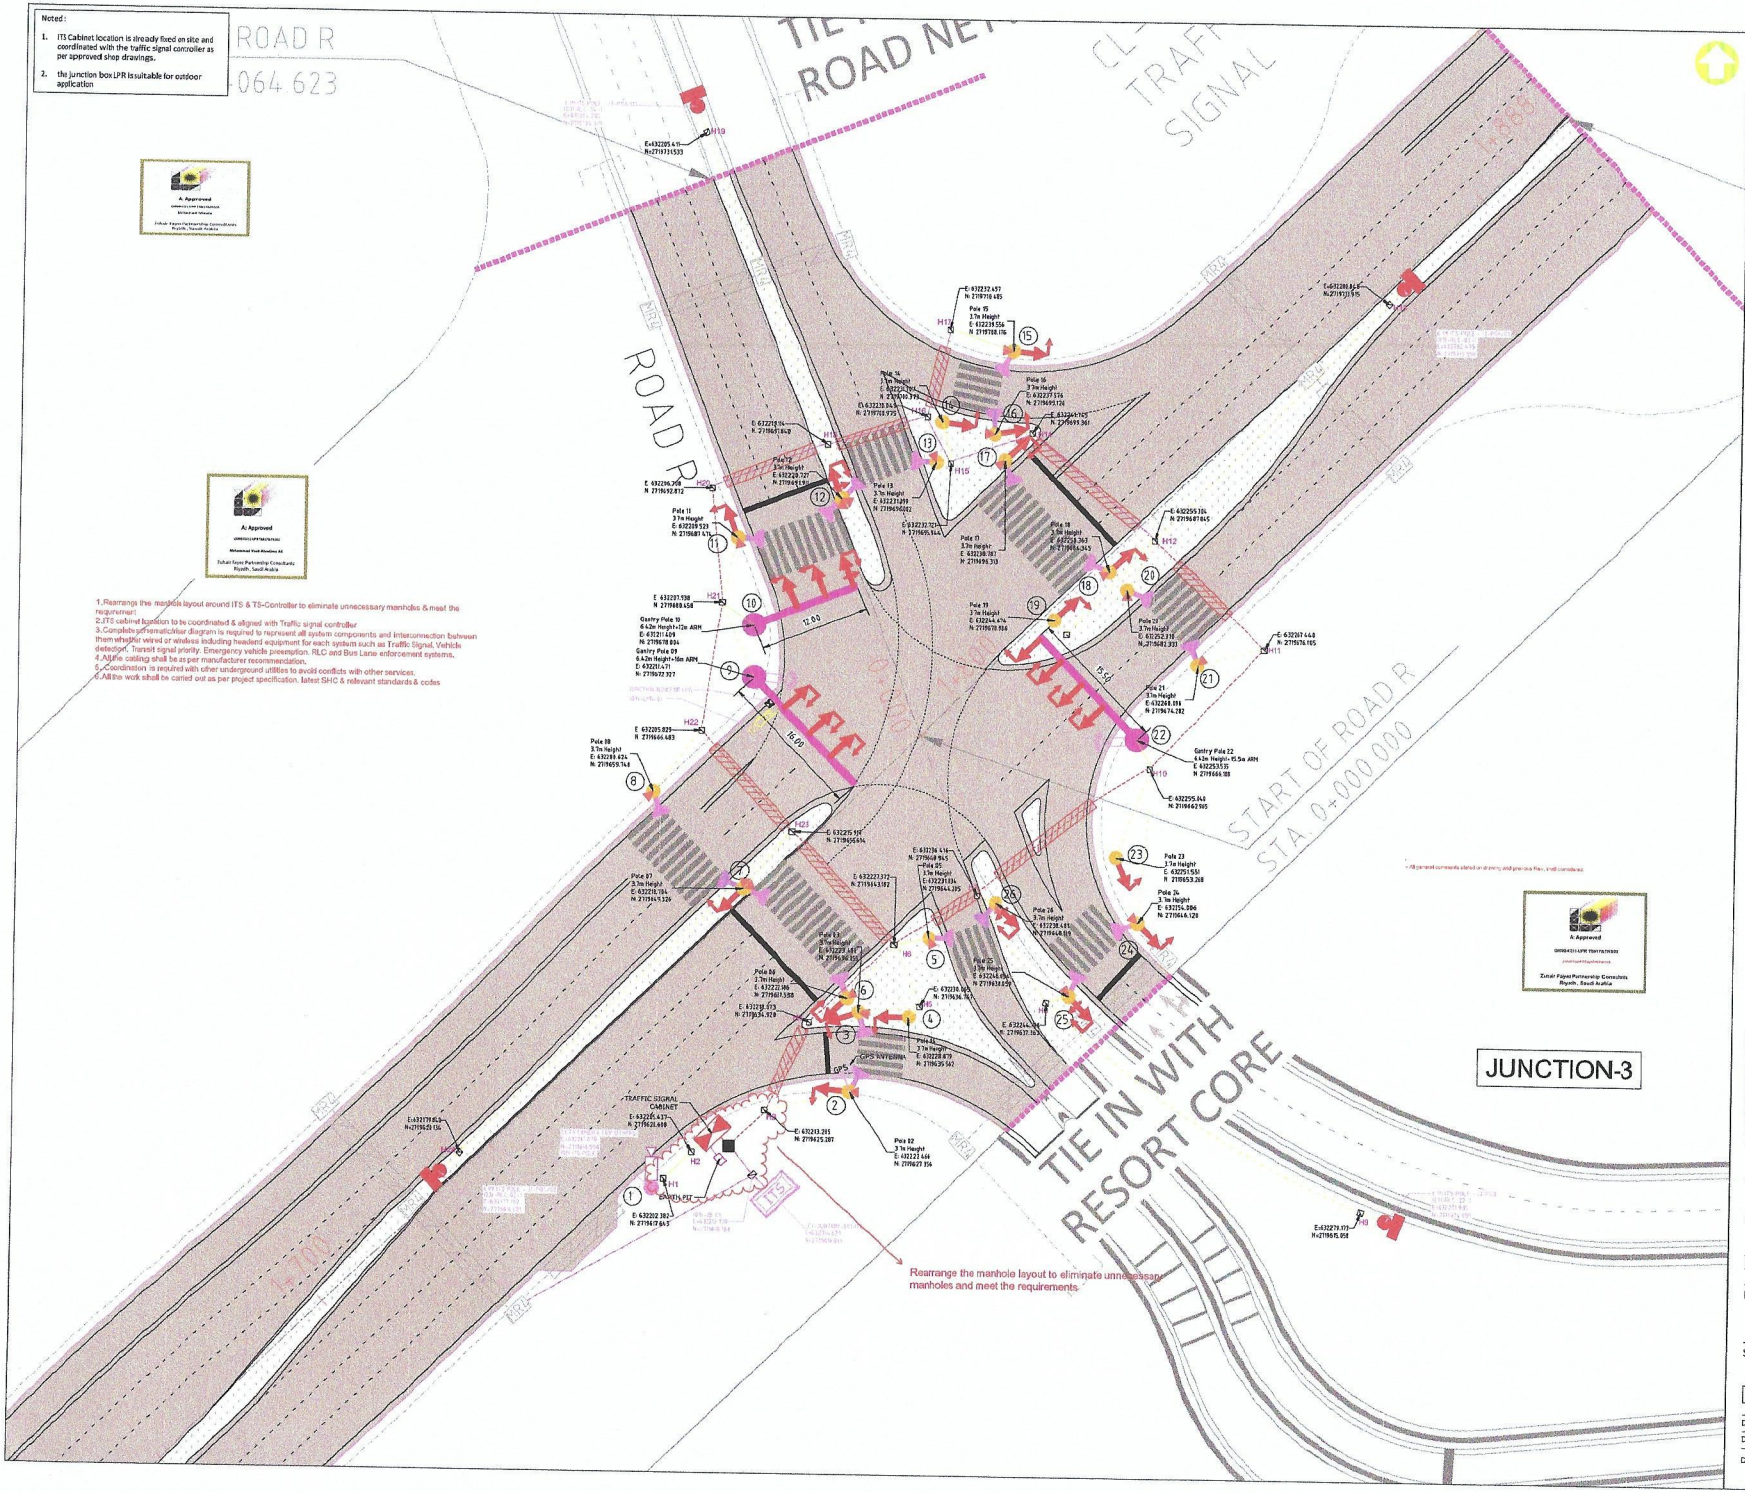

القديـــة
Qiddiya

Consultant's information
HEAD OFFICE - Riyadh
6283 King Abdul Aziz Rd, Ar Rabi
Riyadh 13316 2771, Saudi Arabia
Tel.: +966 11 4048484
Fax : +966 11 4048400
Website : www.zfp.com
Email.: zfpr@zfp.com
Zuhair Fayez Partnership

Notes:
1. ALL DIMENSIONS ARE IN MILLIMETER UNLESS OTHERWISE STATED.
2. ALL LEVELS ARE IN METERS UNLESS NOTED OTHERWISE.
3. THIS DRAWINGS IS TO BE READ IN CONJUNCTION WITH ALL RELEVANT ARCHITECTURAL, STRUCTURAL AND SERVICES DRAWINGS.

REFERENCE I.F.C DESIGN DRAWING NO:
1. QRXP117115-DAH-VORA2R-DWG-ITS-R3-Z00000-2000003
2. QRXP117115-DAH-VORA2R-DWG-ITS-R3-Z00000-5000001
3. QRXP117115-DAH-VORA2R-DWG-ITS-R3-Z00000-5000002
4. QRXP117115-DAH-VORA2R-DWG-ITS-R3-Z00000-5000005
5. QRXP117115-DAH-VORA2R-DWG-ITS-R3-Z00000-5000006
6. QRXP117115-DAH-VORA2R-DWG-ITS-R3-Z00000-6000001
7. QRXP117115-DAH-VORA2R-DWG-ITS-R3-Z00000-5000002
8. QRXP117115-DAH-VORA2R-DWG-CT-R3-Z00000-2000002

LEGEND:

Rev. No.	Date	Description	Appr.
00	31-8-2025	FOR REVIEW AND APPROVAL	C
01	08-11-2025	FOR REVIEW AND APPROVAL	B
02	04-02-2026	FINAL REVISION	
--	--	--	--
--	--	--	--
--	--	--	--
--	--	--	--

Consultant
Contractor
Hall Company
ITS Contractor
TRAFFIC
Project:
القديـــة
Qiddiya

Job title: Road Access To Resort Core

Drawing title:
SHOPDRAWING OF TRAFFIC SIGNAL SYSTEM FOR JUNCTION-3

Sheet number:
SHEET 1 / 20

Scale:1:1000 @ A0

Drawn: M.Elsayed | Checked: M.Abuzaid
Designed: | Approved:

Drawing number: QRXM114000-HFC-DRW-SDW-ITS-02-R05-00033
Revision 02