QIDDIYA DEVELOPMENT COMPANY					
DOCUMENT NUMBER:	QDC-ADM-TEM-QMS-00004	REVISION NUMBER:	00	ISSUED BY:	PMO
DOCUMENT TITLE	WIR FORM	DOCUMENT TYPE:	FORM	DATE ISSUED:	MAY-08-2022

WORK INSPECTION REQUEST (WIR) FORM

Contractor:	HAIF-FREYSSINET JV
Project:	RA2RC
Contract No.:	QPMO-410-CT-00618
Work Inspection Request Number:	QRXM114000-HFC-TEC-WIR-ITS-02-RO5-00049

HAIF-FREYSSINET JV

Discipline

Architecture	☐	Mechanical	☐	Information Technology	☐	Quality	☐	Project Controls	☐
Civil / Structural	☑	Electrical	☐	Landscape	☐	Safety	☐	Construction Management	☐
Other	☐								

WORK DESCRIPTION

Inspection / Test Location:	INTERIM ROAD Sta. JUNCTION -3 Aera		
GIS/GPS GeoTag Coordinates (If applicable)			
Inspection Date:	22-Oct-2026	Inspection Start Time:	10:30 am
ITP:	QRXM114000-HFC-TEC-ITP-CIV-02-RO5-00004	Checklist:	HFC-CKL-1502
Spec's / Dwg. Ref.:	QRXM114000-HFC-DRW-SDW-ITS-02-RO5-00033	Approved Method Statement Number:	QRXM114000-HFC-TEC-MST-CIV-02-RO5-00004
Attachments:	☑ Drawings ☐ Data Sheets ☐ TQs/RFI ☐ OTHER		

DESCRITPTION OF WORK

Inspection request for the Excavation and Bedding Compaction Testing for ITS RC Foundations Of Red-Light Camera Poles 6.10m From R1 To 4 Junction-3 & ITS RC Foundation Pole Of CCTV Camera 15m Junction-3 & ITS RC Foundations Of Traffic Signal Poles 3.70m From 1 TO 26 Junction-3, As Shown On Attached Drawing at Access to Resort core interim Road.

CONTRACTOR - QUALITY INSPECTOR - INITIAL INSPECTION FINDINGS:

Complies with Approved ITPs/Checklists?	◉ YES ○ NO ○ NA	REMARKS	
All Strucutral Embedded Items Cleared?	○ YES ○ NO ○ NA	WIR Number	
Embedded Electrical items Cleared by Electrical QC?	○ YES ○ NO ○ NA	WIR Number	
Embedded Mechanical Items Cleared by Mechanical QC?	○ YES ○ NO ○ NA	WIR Number	

Accepted:	◉
Accepted with Comments (See Remarks):	○
Rejected (See Remarks):	○

REMARKS:					
Name:	Naseem Ahmed	Signature:	Naseem Ahmed	Date:	22-10-2026

QIDDIYA / SUPERVISION CONSULTANT QC INSPECTOR - FINAL INSPECTION FINDINGS:

Contractor Has complied with Project spec requirements?	○ YES ○ NO	Okay to Proceed with next activity?	○ YES ○ NO ○ NA

Accepted:	✓
Accepted with Comments (See Remarks):	○
Rejected (See Remarks):	○

REMARKS:					
Name:	mahmud	Signature:		Date	5/11/26

FOR DETAILED MATERIAL INSPECTION STATUS, PLEASE SEE ATTACHED CHECKLIST.
CHECKLISTS THAT ARE NOT ATTACHED AND SIGNED BY SUPERVISION CONSULTANT WILL VOID THIS INSPECTION REQUEST.

This document is the property of Qiddiya Development Company, 2022

ALMUMAYAZ LABORATORY FOR CONSTRUCTION
MATERIAL'S TESTING
AL NAJAH STREET, AL YERMOK DISTRICT, AL RIYADH
Tel.: 011 4157461, Mob.: 0581748288
Email: s.faisal@almumayaz.sa & info@almumayaz.sa
ISO - 17025:2017

المميز
Al Mumayaz

SUMMARY OF FIELD DENSITY -TEST REPORT

Client	*Qiddiya Investment Company*	**Request No:-**	**QI/FDT-01808**
Project	*RA2RC (INTERIM ROAD)*	**Date**	**14/02/2026**
Contractor	*Haif-Freyssinet JV*	*Inspector*	*Khawaja Adnan*
Consultant:	*ZUHAIR FAYEZ PARTNERSHIP*	**Density S.C**	**2585**
Test Method	*ASTM D6938*	**Moisture S.C**	**677**
Unit No.	*70258*	**Test Time**	**15 sec.**
Model No.	*3440*	*Lab. #*	**HFDT- 1819**
Depth	*25 cm*	**WIR:-**	**QRXM114000-HFC-TEC-WIR-ITS-02-RO5-00049**

Test No.	Testing area	Soil type	In-Situ dry density Kg/m³	In-Situ wet density Kg/m³	In-Situ moisture %	Compaction %	Remarks
1	*Bedding Compaction Testing for ITS RC Foundations Of Red-Light Camera Poles 6.10m From R1 To 4 Junction-3 stock pile-1-H*	F/L	2243	2382	6.2	101.8	PASS
2							
3	*Bedding Compaction Testing for ITS RC Foundation Pole Of CCTV Camera 15m Junction-3 stock pile-1-H*	F/L	2218	2340	5.5	100.6	PASS
4							
5	*Bedding Compaction Testing for ITS Precast RC Manhole TYPE-1 (1.2*0.8*1) m Junction-3 stock pile-1-H*	F/L	2224	2353	5.8	100.9	PASS
6							
7							
Max.Dry Density Kg/m³	**2204**	**Optimum Moisture Content %**	**6.5**	**Project limit %**	**100%**

Remarks

Tested By: Semab — Lab Technician

Reviewed By: Khawaja Adnan — Senior Lab Technician

Approved By: Zohaib Khan — Site Lab Supervisor

مختبر المميز لفحص التربة و الأساسات و الخرسانة و الأسفلت
س.ت/ ١٠١٠٤٢٩٦٩٣
Al Mumayaz Laboratory

Client:	Consultant:	Contractor:
Qiddiya	Zuhair Fayez Partnership	Haif Company / Freyssinet — HAIF-FREYSSINET JV

TECHNICAL DOCUMENTS

Project Name: Package 3 - Interim Road Access to Resort Core	**Project Code:** QRXM114000
Location: 00	**Date:** 17-December-2025
Document Title: **Inspection & Test Plan for Future Duct Bank & Underground Utility Crossings**	**Ref No:** QRXM114000-HFC-TEC-ITP-CIV-02-RO5-00004
	Rev No: 01

Department: ☐ Architectural ☐ Structural ☐ Electrical ☐ Mechanical ☐ Authority ☒ Civil

Type: ☐ Pre-Qualification ☐ Method Statement ☐ Material Submittal ☐ Sample ☒ ITP

Document Description: This is Inspection & Test Plan for Future Duct Bank & Underground Utility Crossings.

Doc. Ref. No.	Title
QRXM114000-HFC-TEC-ITP-CIV-02-RO5-00004	**Inspection & Test Plan for Future Duct Bank & Underground Utility Crossings**

Enclosure:

Submitted By:	**Received By:**
Name: Eng. Moataz	Name:
Signature:	Signature:
Date: 17-Dec-2025	Date:

Below portion for Consultant Supervision use only

Status: ☐A- Approved ☐B- Approved as noted ☐C- Revise & Resubmit ☐R- For information only

Comments:

A: Approved
Zuhair Fayez Partnership Consultants
Riyadh , Saudi Arabia

A: Approved
Zuhair Fayez Partnership Consultants
Riyadh , Saudi Arabia

A: Approved
Zuhair Fayez Partnership Consultants
Riyadh , Saudi Arabia

Below portion for Client use only

Comments:

Signed by: Signature: Date:

HAIF Inspection & Test Plan		I &TP	APPROVED DATE	DISCIPLINE
Future Duct Bank & Underground Utility Crossings		HFC-ITP-015	00	CIVIL
PROJECT TITLE:	Road Access To Resort Core - RA2RC	WBS	CONTRACTOR/SUBCONTRACTOR	
WIR No.		CONSTRUCTION	HAIF-FSA JV	

ITEM NO.	PROJECT PHASE	TASK / ACTIVITY	Quality Requirements /references/ specifications	Quality Record	INSPECTION RESPONSIBILITY ASSIGNMENTS		REMARKS
					Contractor	Consultant	
1.0	**DOCUMENT REVIEW**						
1.1		GRP/HDPE/uPVC Pipes, Electrical duct conduits and accessories material approval	PQ, MTS & Test Reports	PQ, MTS & Test Reports	RH	RH	
1.2		Sidewalk Tiles / Warning Tape Material Approval	PQ, MTS & Test Reports	PQ, MTS & Test Reports	RH	RH	
1.3		Method Statement Approval	Document Approval	Document Approval	RH	RH	
1.4		Concrete Mix Design Approval	PQ, MTS & Test Reports	PQ, MTS & Test Reports	RH	RH	
2.0	**MATERIAL RECEIVING & PREINSTALLATION**						
2.1		GRP/HDPE/uPVC Pipes, Electrical duct conduits and accessories material receiving and storage inspection	HFC-CKL-1501	HFC-CKL-1501	H	W	
2.2		Sidewalk Tiles / Warning Tape receiving & storage inspection	HFC-CKL-1501	HFC-CKL-1501	H	W	
3.0	**INSTALLATION**						
3.1		Trench Excavation Inspection	HFC-CKL-1502	HFC-CKL-1502	W	H	
3.2		Bedding & Compaction Testing Inspection	HFC-CKL-1502	HFC-CKL-1502	H	H	
3.3		GRP/HDPE/uPVC Pipes, Electrical duct conduits installation inspection & casement inspection	HFC-CKL-1503	HFC-CKL-1503	H	H	
3.4		Cast-in-place ready mix concrete placement for future duct bank & underground utility crossings	HFC-CKL-1504	HFC-CKL-1504	H	H	
3.5		Side walk tiles, warning tape installation / backfilling & compaction	HFC-CKL-1505	HFC-CKL-1505	H	H	
4.0	**PRE-COMMISSIONING**						
4.1		Not Applicable					

GENERAL NOTES	
1	The first three incidents of each Inspection or testing activity listed require 100 % participation by the Consultant. After this period, the Consultant may adjust the levels of QDC participation based upon the Contractor's performance.
2	Surveillance: QA/QC organization to monitor work in progress without notice from Construction Organization
3	Witness: QA/QC organization shall be notified of the timing of Inspection or test in advance. However, the inspection or test shall be performed as scheduled if the QA/QC organization representative is not present.
4	Hold: QA/QC organization shall be notified of the timing of inspection or test in advance. Inspection or test shall not be carried out without the QA/QC organization representative in attendance.
5	If the Main Contractor delegates the assigned responsibility to the Subcontractor, then the Main Contractor will have the same degree of responsibility as assigned to Consultant.

LEGEND


Checklist		Checklist	APPROVED DATE	DISCIPLINE
Trench Excavation, Bedding & Compaction Inspection		HFC-CKL-1502	00	CIVIL
PROJECT TITLE:	Road Access To Resort Core - RA2RC	WBS	CONTRACTOR/SUBCONTRACTOR	
WIR No.		CONSTRUCTION-Utility Crossings	HAIF-FSA JV	

ITEM NO.	Check Points & Acceptance Criteria	Reference	Pass	Fail	Not Applicable	Re-Inspection
1.0	**Excavation Bedding & Compaction**					
1.1	The trench within which the pipe is to be placed shall be excavated to the widths shown on the plans.	MOT STD Sec 2.10.2.1 para6	✓			
1.2	JThe Contractor shall establish line and grade as shown on the plans and profile the original ground or embankment as directed by the Engineer.	MOT STD Sec 2.10.2.3	✓			
1.3	Material excavated from trenches shall be piled on one (1) side of and adjacent to the trench and maintained so that the toe of slope of the piled material is at least sixty (60) centimeters from the edge of the trench	MOT STD Sec 2.10.2.3 para 2	✓			
1.4	Care shall be taken not to excavate below the depth specified or ordered by the Engineer, and excavation below that depth shall be backfilled with sand bedding material	MOT STD Sec 2.10.2.3 para 3	✓			
1.5	Trench Width is to be as small as practicable with side's vertical. Remove mud, rock projections, boulders and hard spots from trench bottom and Trim level	Project Specs S23086-REV 1Sec 3.2 Para B	✓			
1.6	Check location and elevation of final finished grade	As per Approved Drawing	✓			
1.7	Grade preparation & Bedding shall be compacted to a dry density notless than ninety percent {90°/o) of the maximum dry density determined from MRDTM 212.	MOT STD Sec 2.10.2.5 Para 5	✓			
1.8	Trenches greater than one and one-half (1-1/2) meters in depth shall be excavated with sloping sides or shored and braced at the option of the Contractor.	MOT STD Sec 2.10.2.1 para 10	✓			
1.9	The Contractor shall not begin trench excavation which is greater than one and one-half (11/2) meters in depth until the Engineer has approved the plans	MOT STD Sec 2.10.2.1 para 10	✓			
1.10	The bottom of the trench shall be graded according to the lines, slopes and elevations shown on the plans or directed by the Engineer, and bedding material placed and compacted.	MOT STD Sec 2.10.2.1 para 12	✓			


Checklist		Checklist	APPROVED DATE	DISCIPLINE
Trench Excavation, Bedding & Compaction Inspection		HFC-CKL-1502	00	CIVIL
PROJECT TITLE:	Road Access To Resort Core - RA2RC	WBS	CONTRACTOR/SUBCONTRACTOR	
WIR No.		CONSTRUCTION-Utility Crossings	HAIF-FSA JV	

ITEM NO.	Check Points & Acceptance Criteria	Reference	Pass	Fail	Not Applicable	Re-Inspection
Remarks						

PM/Contractor			QDC		
Contractor Construction			Third Party (If applicable)		
The work is ready for inspection			Document Reviewed	Work Inspected	Test Records Verified
Name	Signature	Date	Name	Signature	Date
Mahmoud Kamel		29/10/25			
Contractor QC Inspector			QDC Supervision Consultant		
The work is ready for inspection			Document Reviewed	Work Inspected	Test Records Verified
Name	Signature	Date	Name	Signature	Date
Naseem Ahmed	Naseem	27/10/25	Mahmoud		5/11/25

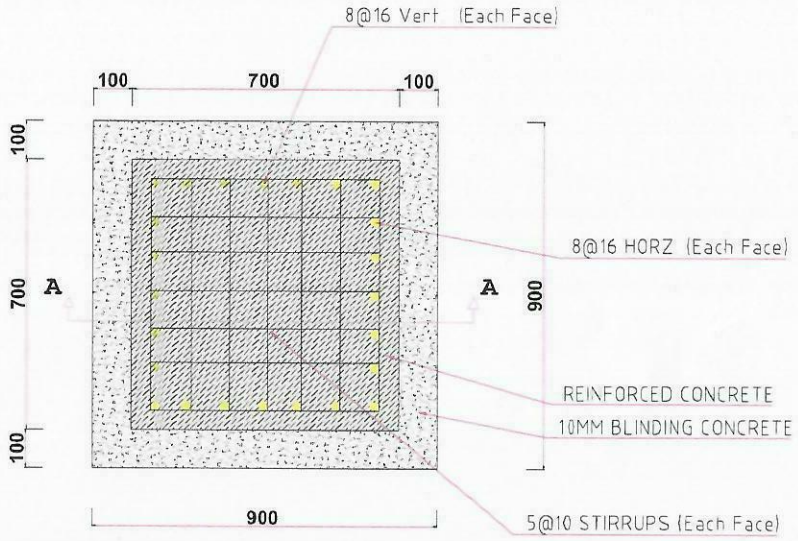

PLAN

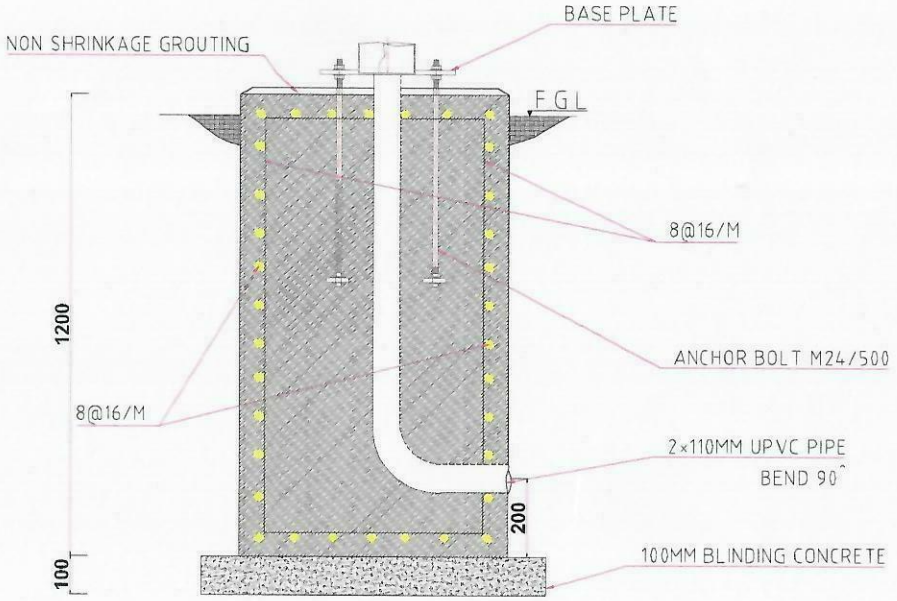

SECTION A-A

القدية
Qiddiya

Consultant's information

HEAD OFFICE - Riyadh
6283 King Abdul Aziz Rd, Ar Rabi
Riyadh 13316 2771, Saudi Arabia
Tel.: +966 11 4048484
Fax : +966 11 4048400
Website : www.zfp.com
Email.: zfp@zfp.com

Zuhair Fayez Partnership

Notes:

1-ALL DIMENSIONS ARE IN MILLIMETER UNLESS OTHERWISE STATED.
2-THIS DRAWINGS IS TO BE READ IN CONJUNCTION WITH ALL RELEVANT ITS, ARCHITECTURAL, STRUCTURAL AND SERVICES DRAWINGS.
3-ALL DIMENSIONS ARE CONFIRMED FROM THE MANUFACTURE.
3-BUSHINGS OR BELL ENDS TO BE INSTALLED AT ALL CONDUIT TERMINATIONS.
6-THE TOP OF THE COVERS TO BE PLACED 100MM ABOVE FINAL LEVEL. GREEN AREAS AND SHALL SUITE THE SURROUNDING PURPOSE.
7-ALL CHAMBERS SHALL BE PRECAST AND SHALL BE WATER PROOF.
8-The Concrete Compressive Strength as per the specs for Reinforced Concrete to be 35 MPa.
9-The Concrete Compressive Strength as per the specs for Plain Concrete under foundations to be 25 MPa.
10-The Steel bar tensile strength as per the specs. to be 420 MPa.

REFERENCE I.F.C DRAWING NO:

QRXP/7115-DAH-V0RA2R-DWG-ITS-R3-Z00000-5000003

Rev. No.	Date	Description	Appr.
00	9-12-2025	FOR REVIEW AND APPROVAL	
--	--	--	--
--	--	--	--
--	--	--	--
--	--	--	--
--	--	--	--
--	--	--	--

Consultant

Contractor

Project:

PROJECT :

ROAD ACCESS TO RESORT CORE

Drawing title:

SHOPDRAWING FOR ITS POLE FOUNDATION -REINFORCEMENT DETAILS ITS POLE WITH HEIGHT 6.10 M

Sheet number:

SHEET 2/5

Scale: 1:1000

Drawn: Mohamed Elsayed	Checked: Mohamed Elsayed
Designed:	Approved:


Drawing number: QRXM-14000-HFC-DRW-SDW-ITS-02-R05-00003

Revision 00

1-ALL DIMENS
2-THIS DRAW
ITS, ARCHITE
3-ALL DIMENS
3-BUSHINGS
TERMINATION
6-THE TOP OF
GREEN AREAS
7-ALL FOUND
8-The Concret
be 35 MPa.
9-The Concret
foundations to
10-The Steel
11-Concrete c
12-All Structu
16m arm gant
13-Foundation
14-Foundation


Plain C



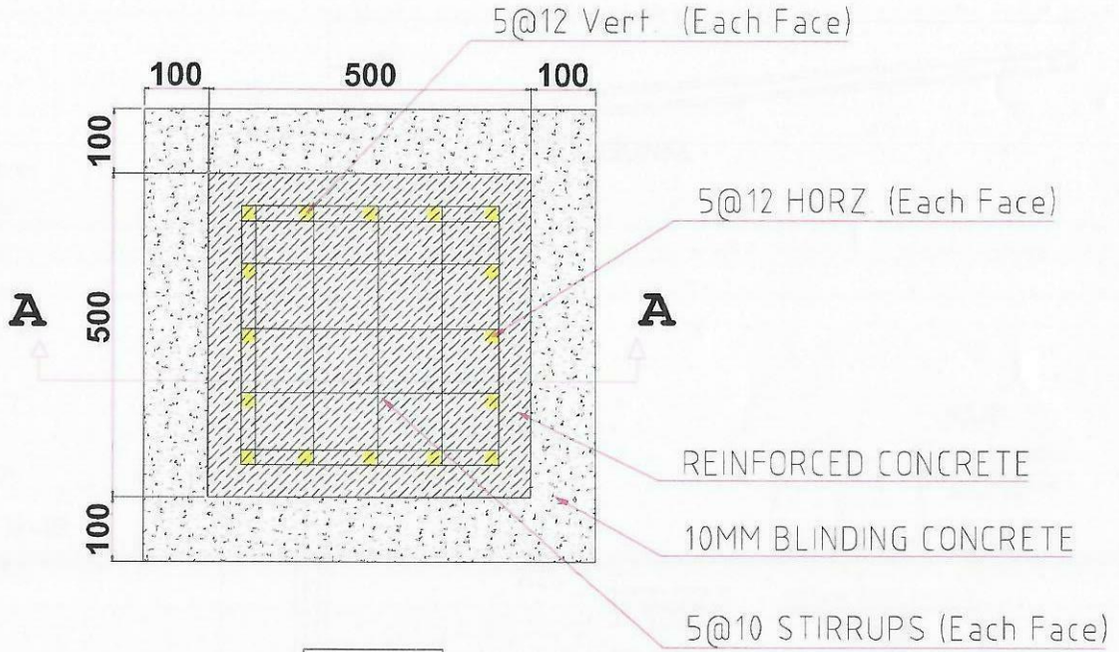

PLAN



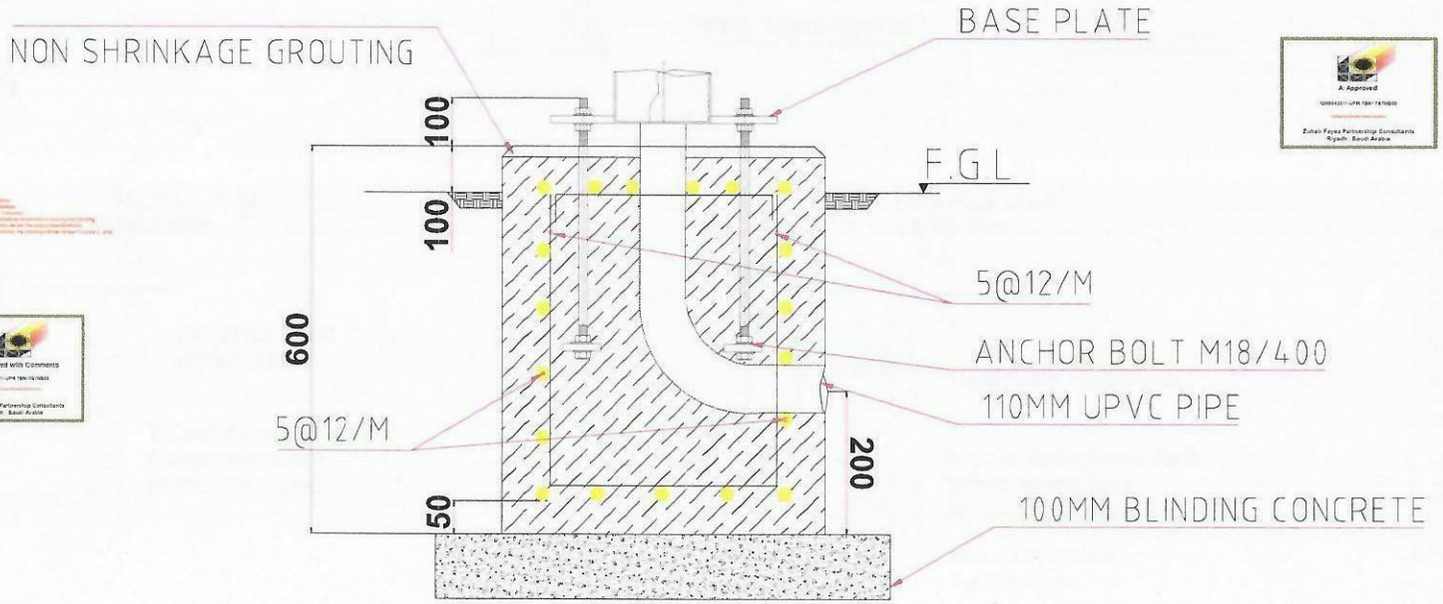

SECTION A-A

القديـــة
Qiddiya

Consultant's information

HEAD OFFICE - Riyadh
6283 King Abdul Aziz Rd, Ar Rabi
Riyadh 13316 2771, Saudi Arabia
Tel.: +966 11 4048484
Fax : +966 11 4048400
Website : www.zfp.com
Email.: zfpr@zfp.com

Zuhair Fayez Partnership

Notes:

1-ALL DIMENSIONS ARE IN MILLIMETER UNLESS OTHERWISE STATED.
2-THIS DRAWINGS IS TO BE READ IN CONJUNCTION WITH ALL RELEVANT ITS, ARCHITECTURAL, STRUCTURAL AND SERVICES DRAWINGS.
3-ALL DIMENSIONS ARE CONFIRMED FROM THE MANUFACTURE.
3-BUSHINGS OR BELL ENDS TO BE INSTALLED AT ALL CONDUIT TERMINATIONS.
6-THE TOP OF THE COVERS TO BE PLACED 100MM ABOVE FINAL LEVEL. GREEN AREAS AND SHALL SUITE THE SURROUNDING PURPOSE.
7-ALL CHAMBERS SHALL BE PRECAST AND SHALL BE WATER PROOF.
8-The Concrete Compressive Strength as per the specs for Reinforced Concrete to be 35 MPa.
9-The Concrete Compressive Strength as per the specs for Plain Concrete under foundations to be 25 MPa.
10-The Steel bar tensile strength as per the specs. to be 420 MPa.

REFERENCE I.F.C DRAWING NO:

QRXP117115-DAH-VORA2R-DWG-GEN-R3-Z00000-5000006

Rev. No.	Date	Description	Appr
00	9-12-2025	FOR REVIEW AND APPROVAL	
--	--	--	--
--	--	--	--
--	--	--	--
--	--	--	--
--	--	--	--
--	--	--	--

Consultant

Contractor
Hail Company

Project:

PROJECT :

ROAD ACCESS TO RESORT CORE

Drawing title:

SHOPDRAWING FOR ITS POLE FOUNDATION -REINFORCEMENT DETAILS
ITS POLE WITH HEIGHT 3.7 M

Sheet number:

SHEET 1 5

Scale: 1:1000

Drawn: Mohamed Elsayed	Checked: Mohamed Elsayed
Designed:	Approved:

Drawing number: QRXM114000-HFC-DRW-SDW-ITS-02-R05-00002

Revision 00