QIDDIYA DEVELOPMENT COMPANY					
DOCUMENT NUMBER:	QDC-ADM-TEM-QMS-00004	REVISION NUMBER:	OD	ISSUED BY:	PMO
DOCUMENT TITLE	WIR FORM	DOCUMENT TYPE:	FORM	DATE ISSUED:	MAY-08-2022

WORK INSPECTION REQUEST (WIR) FORM

Contractor:	HAIF-FREYSSINET JV
Project:	RA2RC
Contract No.:	QPMO-410-CT-00618
Work Inspection Request Number:	QRXM114000-HFC-TEC-WIR-ITS-02-RO5-00074

HAIF-FREYSSINET JV

Discipline

Architecture	☐	Mechanical	☐	Information Technology	☑	Quality	☐	Project Controls	☐
Civil / Structural	☐	Electrical	☐	Landscape	☐	Safety	☐	Construction Management	☐
Other	☐								

WORK DESCRIPTION

Inspection / Test Location:	INTERIM ROAD Sta. (JUNCTION -1, 2, 3)		
GIS/GPS GeoTag Coordinates (If applicable)			
Inspection Date:	25-Jul-2026	Inspection Start Time:	9:30 am
ITP:	QRXM114000-HFC-TEC-ITP-ITS-02-RO5-00006	Checklist:	HFC-CKL-9003
Spec's / Dwg. Ref.:	QRXM114000-HFC-DRW-SDW-ITS-02-RO5-00023 -32-42	Approved Method Statement Number:	QRXM114000-HFC-TEC-MST-ITS-02-RO5-00001
Attachments:	☑ Drawings ☐ Data Sheets ☐ TQs/RFI ☐ OTHER _____		

DESCRIPTION OF WORK

Inspection request for Installation of Traffic signal pole 3.7mtrs, Junction#1 , 39 pole, Junction#2 , 17 pole and Junction#3 , 22 pole, Total 78 poles, at Access to Resort core interim Road. As per attached drawing.

CONTRACTOR - QUALITY INSPECTOR - INITIAL INSPECTION FINDINGS:

Complies with Approved ITPs/Checklists?	◉ YES ○ NO ○ NA	REMARKS	
All Strucutral Embedded Items Cleared?	○ YES ○ NO ○ NA	WIR Number	
Embedded Electrical items Cleared by Electrical QC?	○ YES ○ NO ○ NA	WIR Number	
Embedded Mechanical Items Cleared by Mechanical QC?	○ YES ○ NO ○ NA	WIR Number	

Accepted:	◉
Accepted with Comments (See Remarks):	○
Rejected (See Remarks):	○

REMARKS:					
Name:	Naseem Ahmed	Signature:	Naseem Ahmed	Date:	25/07/026

QIDDIYA / SUPERVISION CONSULTANT QC INSPECTOR - FINAL INSPECTION FINDINGS:

Contractor Has complied with Project spec requirements?	○ YES ○ NO	Okay to Proceed with next activity?	○ YES ○ NO ○ NA

Accepted:	○
Accepted with Comments (See Remarks):	◉
Rejected (See Remarks):	○

REMARKS:	* final approval upon completion of signal heads installation. * Submit torque tightening certificate by Third Party. * final inspection and check for poles Verticality				
Name:	Mahmoud Mekkawy	Signature:		Date	26.9.25

FOR DETAILED MATERIAL INSPECTION STATUS, PLEASE SEE ATTACHED CHECKLIST.
CHECKLISTS THAT ARE NOT ATTACHED AND SIGNED BY SUPERVISION CONSULTANT WILL VOID THIS INSPECTION REQUEST.

This document is the property of Qiddiya Development Company, 2022

ZFP/ Approved (Code B)

26.9.26

QIDDIYA DEVELOPMENT COMPANY

DOCUMENT NUMBER:	QDC-ADM-TEM-QMS-00007	REVISION NUMBER:	0D	ISSUED BY:	PMO
DOCUMENT TITLE	MIR FORM	DOCUMENT TYPE:	FORM	DATE ISSUED:	MAY-08-2022

MATERIAL INSPECTION REQUEST (MIR) FORM

Contractor:	HAIF COMPANY
Project:	QPMO-410-CT-00618- ROAD ACCESS TO RESORT CORE
Contract No.:	QI09043311-VO-0004
Material Inspection Request Number:	QRXM114000-HFC-TEC-MIR-ITS-02-RO5-00004

HAIF-FREYSSINET JV

Discipline

Architecture	☐	Mechanical	☐	Information Technology	☐	Quality	☐	Project Controls	☐
Civil/Structural	☑	Electrical	☐	Landscape	☐	Safety	☐	Construction Management	☐
Other	☐								

MATERIAL DESCRIPTION

Inspection / Test Location:	INTERIM ROAD MAIN LINE-02		
Material Name:	ITS SYSTEMS (TRAFFIC SIGNALS POLE & ANCHOR BOLT)	Quantity:	494 Pcs.
P.O Number		Delivery Note Number:	TTSDN-HAIF-141225-007, 011, 161025-001, TTS-HAIF-DN-003, 009,
Approved Material Transmittal Number: (Aconex document Approval)		Approval Date:	
Inspection Date:	22-Jan-2026	Inspection Start Time:	10:00 AM
ITP:		Checklist:	
Spec's / Dwg. Ref.:	TRAFFIC TECH SECURITY W.L.L	Approved Method Statement Number:	
Attachments:	Test Certificate: ◉ Yes ○ No IFC / Shop Drawings: ○ Yes ◉ No		

DESCRITPTION OF MATERIAL

Abchor Bolt 700*27 (40 Pcs.) Base Plate 15*15*50 (5 Pcs.) HDG Anchor Bolt (M18*400) LG (120 Pcs.)Base Plate (350*350 (30 Pcs.) Anchor Bolt M18/400 J Type (144 Pcs.) Anchor Bolt M24/500 J Type (52 Pcs.) Anchor Bolt M30/1000 I Type(12 Pcs.) Template 300*300 (11 Pcs.),550*550 (03 Pcs.),350*350 (38 Pcs.),Traffic Signal Pole 3.7 Mtrs (39 Pcs.) for Interim Road Main Line-02

39

CONTRACTOR - QUALITY INSPECTOR - INITIAL INSPECTION FINDINGS:

Are Complete Details Mentioned in P.O and Delivery Note?	◉ YES	○ NO	REMARKS	
Complies with Approved ITPs/Checklists?	◉ YES	○ NO	REMARKS	
Signs of Physcial Damage?	○ YES	◉ NO	REMARKS	
Conforms to Approved Material Submittal?	○ YES	○ NO	REMARKS	

Accepted:	◉
Accepted with Comments:	○
Rejected (See Remarks):	○

REMARKS:					
Name:	Moataz Elkhateeb	Signature:		Date:	22-01-2026

QIDDIYA / SUPERVISION CONSULTANT QC INSPECTOR - FINAL INSPECTION FIN

Contractor Has complied with Material requirements?	○ YES	○ NO	y?	○ YES	○ NO ○ NA
Accepted:					○
Accepted with Comments:					◉
Rejected (See Remarks):					○

B: Approved with Comments
QI09043311-UPR TBN17&TN505
Saud Nawab
Zuhair Fayez Partnership Consultants
Riyadh , Saudi Arabia

REMARKS:	① Attach approved ITP. ② Comply with the comments mentioned on attached supporting documents.				
Name:	M-YASIR.	Signature:		Date	22/01/2026.

FOR DETAILED MATERIAL INSPECTION STATUS, PLEASE SEE ATTACHED CHECKLIST.
CHECKLISTS THAT ARE NOT ATTACHED AND SIGNED BY SUPERVISION CONSULTANT WILL VOID THIS INSPECTION REQUEST.

This document is the property of Qiddiya Development Company, 2022

QIDDIYA DEVELOPMENT COMPANY					
DOCUMENT NUMBER:	QDC-ADM-TEM-QMS-00007	REVISION NUMBER:	00	ISSUED BY:	PMO
DOCUMENT TITLE	MIR FORM	DOCUMENT TYPE:	FORM	DATE ISSUED:	MAY-08-2022

MATERIAL INSPECTION REQUEST (MIR) FORM

Contractor:	HAIF COMPANY
Project:	QPMO-410-CT-00618- ROAD ACCESS TO RESORT CORE
Contract No.:	QI09043311-VO-0004
Material Inspection Request Number:	QRXM114000-HFC-TEC-MIR-ITS-02-RO5-00016

HAIF-FREYSSINET JV

Discipline

Architecture	☐	Mechanical	☐	Information Technology	☐	Quality	☐	Project Controls	☐
Civil/Structural	☑	Electrical	☐	Landscape	☐	Safety	☐	Construction Management	☐
Other	☐								

MATERIAL DESCRIPTION

Inspection / Test Location:	INTERIM ROAD MAIN LINE-02		
Material Name:	ITS SYSTEMS (TRAFFIC SIGNALS POLE W / TOP BOLTED)	Quantity:	31 Nos.
P.O Number		Delivery Note Number:	TTSDN-HAIF-060726-026
Approved Material Transmittal Number: (Aconex document Approval)	QRXM114000-HFC-TEC-MAT-ITS-02-RO5-00015	Approval Date:	
Inspection Date:	02-Aug-2026	Inspection Start Time:	10:00 AM
ITP:	QRXM114000-HFC-TEC-ITP-ITS-02-RO5-00006	Checklist:	HFC-CKL-9001
Spec's / Dwg. Ref.:	TRAFFIC TECH SECURITY W.L.L	Approved Method Statement Number:	
Attachments:	Test Certificate: ◉ Yes ○ No		
	IFC / Shop Drawings: ○ Yes ◉ No		

DESCRIPTION OF MATERIAL

Traffic Signal Pole 3.7 Mtrs (31 Nos.) 3.7 Tublar Traffic Signal Pole W/ Top Bolted Cap & Base PlateOnly. DWG. No. S-9571. Rev.-02 (31Nos.) Powder Coating Charges For The 3.7 m Pole (31 Pcs.) for Interim Road Main Line-02

CONTRACTOR - QUALITY INSPECTOR - INITIAL INSPECTION FINDINGS:

Are Complete Details Mentioned in P.O and Delivery Note?	◉ YES	○ NO	REMARKS	
Complies with Approved ITPs/Checklists?	◉ YES	○ NO	REMARKS	
Signs of Physcial Damage?	○ YES	◉ NO	REMARKS	
Conforms to Approved Material Submittal?	○ YES	○ NO	REMARKS	

Accepted:	◉
Accepted with Comments:	○
Rejected (See Remarks):	○

REMARKS:					
Name:	Moataz Elkhateeb	Signature:		Date:	02-08-2026

QIDDIYA / SUPERVISION CONSULTANT QC INSPECTOR - FINAL INSPECTION FINDINGS:

Contractor Has complied with Material requirements?	○ YES	○ NO	Materials Are Stored correctly?	○ YES	○ NO	○ NA

Accepted:	○
Accepted with Comments:	◉
Rejected (See Remarks):	○

REMARKS:	Inspection done for delivered material in the site Store area and found as per delivery note & granted approval.				
Name:	Abdelrahman Hassan	Signature:		Date	2/8/2026

FOR DETAILED MATERIAL INSPECTION STATUS, PLEASE SEE ATTACHED CHECKLIST.
CHECKLISTS THAT ARE NOT ATTACHED AND SIGNED BY SUPERVISION CONSULTANT WILL VOID THIS INSPECTION REQUEST.

This document is the property of Qiddiya Development Company, 2022

* Final approval subject to provide MTC for Traffic pole Post.
* Provide welding certificate.

QIDDIYA DEVELOPMENT COMPANY					
DOCUMENT NUMBER:	QDC-ADM-TEM-QMS-00007	REVISION NUMBER:	0D	ISSUED BY:	PMO
DOCUMENT TITLE	MIR FORM	DOCUMENT TYPE:	FORM	DATE ISSUED:	MAY-08-2022

Qiddiya

MATERIAL INSPECTION REQUEST (MIR) FORM

Contractor:	HAIF COMPANY
Project:	QPMO-410-CT-00618- ROAD ACCESS TO RESORT CORE
Contract No.:	QI09043311-VO-0004
Material Inspection Request Number:	QRXM114000-HFC-TEC-MIR-ITS-02-RO5-00019

HAIF-FREYSSINET JV

Discipline

Architecture	☐	Mechanical	☐	Information Technology	☐	Quality	☐	Project Controls	☐
Civil/Structural	☑	Electrical	☐	Landscape	☐	Safety	☐	Construction Management	☐
Other	☐								

MATERIAL DESCRIPTION

Inspection / Test Location:	INTERIM ROAD MAIN LINE-02		
Material Name:	ITS SYSTEMS (TRAFFIC SIGNALS POLE W / TOP BOLTED)	Quantity:	08 Nos.
P.O Number		Delivery Note Number:	TTSDN-HAIF-060726-026
Approved Material Transmittal Number: (Aconex document Approval)	QRXM114000-HFC-TEC-MAT-ITS-02-RO5-00015	Approval Date:	
Inspection Date:	02-Aug-2026	Inspection Start Time:	11:00 AM
ITP:	QRXM114000-HFC-TEC-ITP-ITS-02-RO5-00006	Checklist:	HFC-CKL-9001
Spec's / Dwg. Ref.:	TRAFFIC TECH SECURITY W.L.L	Approved Method Statement Number:	
Attachments:	Test Certificate: ◉ Yes ○ No IFC / Shop Drawings: ○ Yes ◉ No		

DESCRIPTION OF MATERIAL

Traffic Signal Pole 3.7 Mtrs (08 Nos.) 3.7 Tublar Traffic Signal Pole W/ Top Bolted Cap & Base PlateOnly. DWG. No. S-9571. Rev.-02 (08Nos.) Powder Coating Charges For The 3.7 m Pole (08 Pcs.) for Interim Road Main Line-02

CONTRACTOR - QUALITY INSPECTOR - INITIAL INSPECTION FINDINGS:

Are Complete Details Mentioned in P.O and Delivery Note?	◉ YES ○ NO	REMARKS	
Complies with Approved ITPs/Checklists?	◉ YES ○ NO	REMARKS	
Signs of Physcial Damage?	○ YES ◉ NO	REMARKS	
Conforms to Approved Material Submittal?	○ YES ○ NO	REMARKS	

Accepted:	◉
Accepted with Comments:	○
Rejected (See Remarks):	○

REMARKS:					
Name:	Moataz Elkhateeb	Signature:		Date:	02-08-2026

QIDDIYA / SUPERVISION CONSULTANT QC INSPECTOR - FINAL INSPECTION FINDINGS:

Contractor Has complied with Material requirements?	○ YES ○ NO	Materials Are Stored correctly?	○ YES ○ NO ○ NA

Accepted:	
Accepted with Comments:	○
Rejected (See Remarks):	○

REMARKS:	Inspection done For delivered materials with site key document and found as per delivery note and material approvals. Final approval subjected to provid MTC for Post & Welding Certificate.				
Name:	Abdelrahman Hassan	Signature:		Date	

FOR DETAILED MATERIAL INSPECTION STATUS, PLEASE SEE ATTACHED CHECKLIST.
CHECKLISTS THAT ARE NOT ATTACHED AND SIGNED BY SUPERVISION CONSULTANT WILL VOID THIS INSPECTION REQUEST. 2/8/2026

This document is the property of Qiddiya Development Company, 2022

7-8

Client:	Consultant:	Contractor:
Qiddiya	Zunair Fayez Partnership	Hail Company / Freyssinet — HAIF-FREYSSINET JV

TECHNICAL DOCUMENTS

Project Name: Package 3 - **Interim Road Access to Resort Core**	**Project Code:** QRXM114000
Location: 00	**Date:** 01-August-2026
Document Title: **Material Approval Request FOR ITS SYSTEM SUPPLYING & INSTALLING BY TRAFFIC TECH SECURITY W.L.L** (Traffic Signal Poles and Gantries)	**Ref No:** QRXM114000-HFC-TEC-MAT-ITS-02-RO5-00015
	Rev No: 01

Department: ☐ Architectural ☐ Structural ☐ Electrical ☐ Mechanical ☑ ITS ☐ Civil

Type: ☐ Pre-Qualification ☐ Method Statement ☒ Material Submittal ☐ Sample ☐ Other

Document Description: Material Approval Request FOR ITS SYSTEM SUPPLYING & INSTALLING BY TRAFFIC TECH SECURITY W.L.L (Traffic Signal Poles and Gantries)

Doc. Ref. No.	Title
QRXM114000-HFC-TEC-MAT-ITS-02-RO5-00015	**Material Approval Request FOR ITS SYSTEM SUPPLYING & INSTALLING BY TRAFFIC TECH SECURITY W.L.L** (Traffic Signal Poles and Gantries)

Enclosure:

Submitted By:	**Received By:**
Name: **Eng. Moataz** Signature: Date: 01-August-2026	Name: Signature:

Below portion for Consultant Supervision use only

Status: ☐A- Approved ☑B- Approved as noted ☐C- Revise & Resubmit ☐R- For information only

Comments: Subject to Addressing the Comments on the previous Version Ref. No. QRXM114000-HFC-TEC-MAT-ITS-02-RO5-00015 Rev No: 00

Below portion for Client use only

Comments:

Signed by: Signature: Date:

ZFA/ Approved (Code B)
20.9.26

Client:	Consultant:	Contractor:
Qiddiya	Zuhair Fayez Partnership	Haif Company / Freyssinet — HAIF-FREYSSINET JV

TECHNICAL DOCUMENTS

Project Name: Package 3 - Interim Road Access to Resort Core	**Project Code:** QRXM114000
Location: 00	**Date:** 4 -June-2026
Document Title: **Inspection & Test Plan for Inteligent Transportation System Works for TRAFFIC SIGNAL SYSTEM**	**Ref No:** QRXM114000-HFC-TEC-ITP-ITS-00006
	Rev No: 00

Department: ☐ Architectural ☐ Structural ☒ Electrical ☐ Mechanical ☐ Authority ☐ Civil

Type: ☐ Pre-Qualification ☐ Method Statement ☐ Material Submittal ☐ Sample ☒ ITP

Document Description: This is Inspection&Test Plan for Inspection&Test Plan for Inteligent Transportation system Works for TRAFFIC SIGNAL SYSTEM

Doc. Ref. No.	Title
QRXM114000-HFC-TEC-ITP-ITS-00006	**Inspection&Test Plan for Inteligent Transportation system Works for TRAFFIC SIGNAL SYSTEM**

Enclosure:

Submitted By:	**Received By:**
Name: Eng. Moataz Signature: Date: 4 -June-2026	Name: Signature: Date:

Below portion for Consultant Supervision use only

Status: ☐A- Approved ☐B- Approved as noted ☐C- Revise & Resubmit ☐R- For information only

Comments: All the work shall be carried out inaccordance with project specification, relevant standards & codes and manufacturer recommendations.

A: Approved — Zuhair Fayez Partnership Consultants, Riyadh , Saudi Arabia

A: Approved — Saud Nawab — Zuhair Fayez Partnership Consultants, Riyadh , Saudi Arabia

A: Approved — Zuhair Fayez Partnership Consultants, Riyadh , Saudi Arabia

Below portion for Client use only

Comments:

Signed by: Signature: Date:

HAIF-FSA JV Inspection & Test Plan					I &TP	APPROVED DATE	DISCIPLINE
Inteligent Transportation System Works for TRAFFIC SIGNAL SYSTEM					**HFC-ITP-090**		**ITS**
PROJECT TITLE:WBS Access Road To Resort Core (RA2RC)					CONTRACTOR/SUBCONTRACTOR		
WIR No.					CONSTRUCTION- Intelligent Transportation System Works for TRAFFIC SIGNAL SYSTEM HAIF		

ITEM NO.	PROJECT PHASE	TASK / ACTIVITY	Quality Requirements /references/ specifications	Quality Record	INSPECTION RESPONSIBILITY ASSIGNMENTS			REMARKS
					Contractor	Third Party	Consultant	
1.0 DOCUMENT REVIEW								
1.7		Material Approval & Shop Drawing - Vehicle Video Detection System	QRXP1171 15-DAH-VORA2R-SPE-INF-R1-Z00000-000001-0B Section 137714 VEHICLE DETECTION SYSTEM IFC Drawing QRXP1171 15-DAH-VORA2R-DWG-GEN-R3-Z00000-5000006	QRXM1 14000-HFC-TEC-MAT-ITS-02-R05-00010 Material Approval Request for VEHICLE VIDEO DETECTION SYSTEM Approved SHOP DRAWINGS: QRXM1 14000-HFC-DRW-SDW-ITS-02-R05-00019-R02 QRXM1 14000-HFC-DRW-SDW-ITS-02-R05-00031-R01 QRXM1 14000-HFC-DRW-SDW-ITS-02-R05-00044-R01	R		H	
2.0 MATERIAL RECEIVING INSPECTION								
2		Material receiving inspection, protection & storage	QD0002-ADM-TEM-QMS00007[0A] MaterialReceiving Inspection in site HFC-CKL-9001	QD0002-ADM-TEM-QMS00007[0A] MaterialReceivingInspection in site HFC-CKL-9001	H		H	MIR to be submitted
3.0 WORK INSTALLATION								
3.1		PRE - INSTALLATION	HFC-CKL-9002	HFC-CKL-9002	H		H	
3.2		INSTALLATION	HFC-CKL-9003	HFC-CKL-9003	H		H	
3.3		TESTING	HFC-CKL-9004	HFC-CKL-9004	H		H	

GENERAL NOTES

1	Surveillance: QA/QC organization to monitor work in progress without notice from Construction Organization
2	Witness: QA/QC organization shall be notified of the timing of Inspection or test in advance. However, the inspection or test shall be performed as scheduled if the QA/QC organization representative is not present
3	Hold: QA/QC organization shall be notified of the timing of inspection or test in advance. Inspection or test shall not be carried out without the QA/QC organization representative in attendance.
4	If the Main Contractor delegates the assigned responsibility to the Subcontractor, then the Main Contractor will have the same degree of responsibility as assigned to Consultant.

LEGEND

H	Hold Point for QC Inspection/ Test	R	Review of Documents
W	Witness Inspection/T	RH	Review & approval of Documents
S	Surveillance		

Checklist : HFC-CKL-9003

INSTALLATION OF TRAFFIC SIGNAL SYSTEM

PROJECT TITLE: Road Access To Resort Core (RA2RC)

WIR No.

Checklist	APPROVED DATE	DISCIPLINE
HFC-CKL-9003		ITS
WBS	CONTRACTOR/SUBCONTRACTOR	

CONSTRUCTION-
Intelligent Transportation System Works for
INSTALLATION AND OPERATION of
TRAFFIC SIGNAL SYSTEM

HAIF

ITEM NO.	Check Points & Acceptance Criteria	Reference	Pass	Fail	Not Applicable	Re-Inspection
1.0	**INSTALLATION OF TRAFFIC SIGNAL SYSTEM - EMERGENCY VEHICLE PRE-EMPTION SYSTEM (EVPS)**					
ITEM NO.	**Check Points & Acceptance Criteria**	**Reference**	**Pass**	**Fail**	**Not Applicable**	**Re-Inspection**
6.0	**INSTALLATION OF TRAFFIC SIGNAL SYSTEM - TRAFFIC SIGNAL POLE & GANTRIES**					
6.1	Are all Shop Drawings, Method Statement and Material Submittals were approved ?	SHC 306 SECTION 12.TRAFFIC SIGNALS, 12.2.2.SUPPORTING STRUCTURE SPECIFICATIONS	✓			
6.2	Are all TRAFFIC SIGNAL POLE AND GANTRIES installed as per approved Material Submittals?	SHC 306 SECTION 12.TRAFFIC SIGNALS, 12.2.2.SUPPORTING STRUCTURE SPECIFICATIONS	✓			
6.3	Are all TRAFFIC SIGNAL POLE AND GANTRIES material quantity as per approved Material Submittals and Shop Drawings?	SHC 306 SECTION 12.TRAFFIC SIGNALS, 12.2.2.SUPPORTING STRUCTURE SPECIFICATIONS	✓			
6.4	Is installation performed in accordance with the applicable standards, requirements, manufacturers' guidelines and any authorities having jurisdiction	SHC 306 SECTION 12.TRAFFIC SIGNALS, 12.2.2.SUPPORTING STRUCTURE SPECIFICATIONS	✓			
6.5	Setting out and installation of foundations were installed as per approved Shop Drawings?	SHC 306 SECTION 12.TRAFFIC SIGNALS, 12.2.2.SUPPORTING STRUCTURE SPECIFICATIONS	✓			
6.6	Are the Poles/Gantries were tightened, and fixed on the foundation's anchor bolts? NO	SHC 306 SECTION 12.TRAFFIC SIGNALS, 12.2.2.SUPPORTING STRUCTURE SPECIFICATIONS		✓		
6.7	Are the Poles/Gantries leveled and plumbed? NO	SHC 306 SECTION 12.TRAFFIC SIGNALS, 12.2.2.SUPPORTING STRUCTURE SPECIFICATIONS		✓		
6.8	Are the serial numbers of test report verified and matching with material NO	SHC 306 SECTION 12.TRAFFIC SIGNALS, 12.2.2.SUPPORTING STRUCTURE SPECIFICATIONS		✓		

Remarks


PM/Contractor			QDC		
Contractor Construction			**Third Party (If applicable)**		
The work is ready for inspection			**Document Reviewed**	**Work Inspected**	**Test Records Verified**
Name	Signature	Date	Name	Signature	
Muhammad Naseem Ahmed		25-07-26	Mr. Edmund Mekky		27.9.26
Contractor QC Inspector			QDC Supervision Consultant		

Form Ref. No. QD0002-ADM-TEM-QTY-00003– Rev.0A

Naseem Ahmed

Naseem Ahmed 25/7/26

ZP/
Refer to Comments on Cover sheet
27.9.26

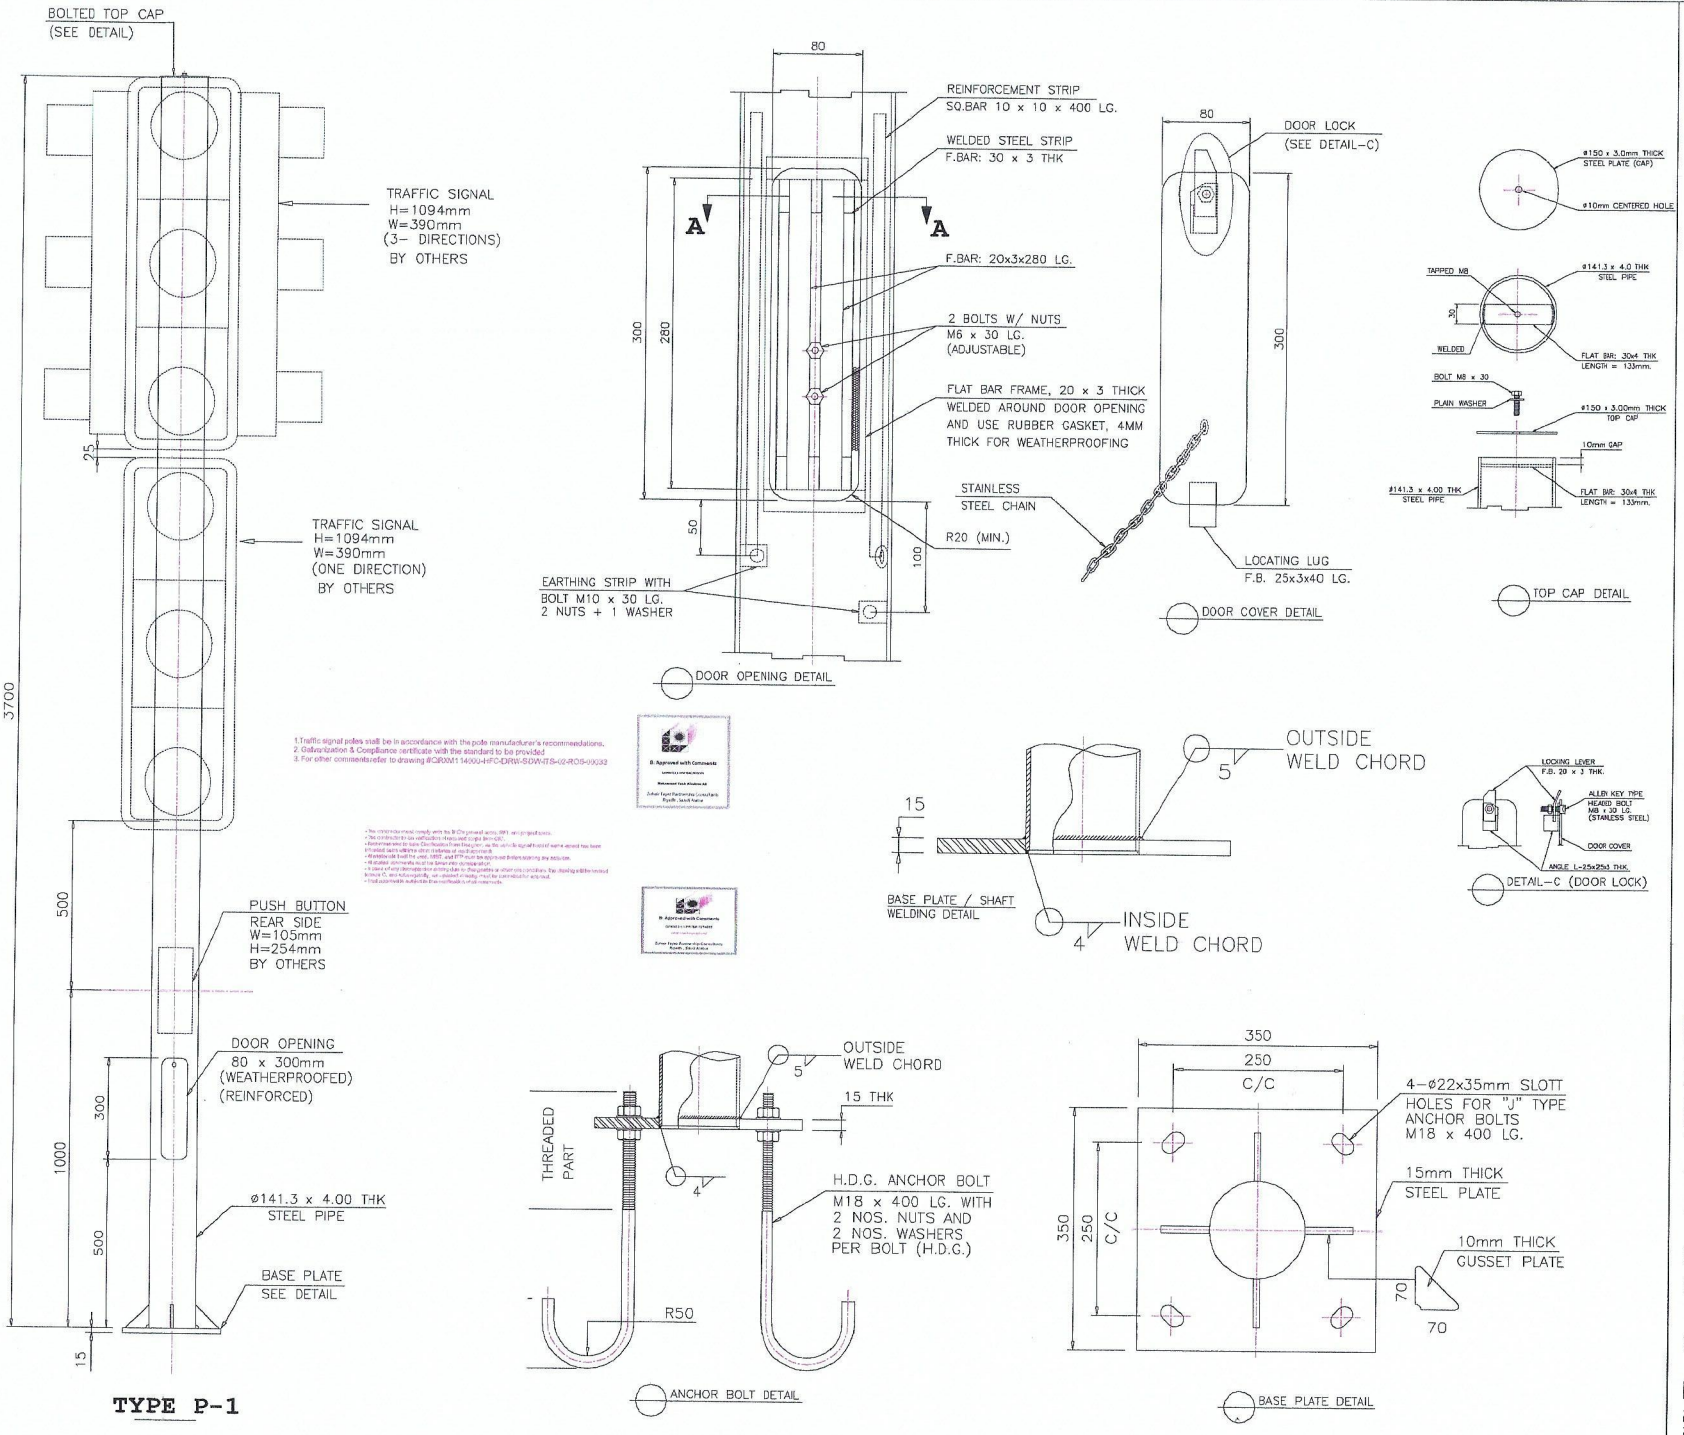


القدية
Qiddiya

Consultant's information

HEAD OFFICE - Riyadh
6283 King Abdul Aziz Rd, Ar Rabi
Riyadh 13316 2771, Saudi Arabia
Tel.: +966 11 4048484
Fax : +966 11 4048400
Website : www.zfp.com
Email.: zfpr@zfp.com

Zuhair Fayez Partnership

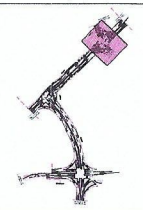

Notes:
1. ALL DIMENSIONS ARE IN MILLIMETER UNLESS OTHERWISE STATED.
2. ALL LEVELS ARE IN METERS UNLESS NOTED OTHERWISE.
3. THIS DRAWINGS IS TO BE READ IN CONJUNCTION WITH ALL RELEVANT ARCHITECTURAL, STRUCTURAL AND SERVICES DRAWINGS.

REFERENCE I.F.C DESIGN DRAWING NO:
1. QRXP117115-DAH-VORA2R-DWG-ITS-R3-Z00000-2000003
2. QRXP117115-DAH-VORA2R-DWG-ITS-R3-Z00000-5000001
3. QRXP117115-DAH-VORA2R-DWG-ITS-R3-Z00000-5000002
4. QRXP117115-DAH-VORA2R-DWG-ITS-R3-Z00000-5000005
5. QRXP117115-DAH-VORA2R-DWG-ITS-R3-Z00000-5000006
6. QRXP117115-DAH-VORA2R-DWG-ITS-R3-Z00000-6000001
7. QRXP117115-DAH-VORA2R-DWG-ITS-R3-Z00000-6000002
8. QRXP117115-DAH-VORA2R-DWG-ICT-R3-Z00000-2000000

LEGEND:

Rev. No.	Date	Description	Appr.
00	31-8-2025	FOR REVIEW AND APPROVAL	c
01	08-11-2025	FOR REVIEW AND APPROVAL	--
--	--	--	--
--	--	--	--
--	--	--	--
--	--	--	--
--	--	--	--

Consultant
Contractor
Hail Company
ITS Contractor
TRAFFIC TECH

Project:
القدية Qiddiya

Job title: Road Access To Resort Core


Drawing title:
SHOPDRAWING OF TRAFFIC SIGNAL SYSTEM FOR JUNCTION-3
TYPICAL STANDARD DETAIL OF 3.7m TUBULAR TRAFFIC SIGN POLE

Sheet number:
SHEET 10 / 20

Scale: NTS

Drawn: M.Sayed	Checked: M.Sayed
Designed:	Approved:

Drawing number: QRXM114000-HFC-DRW-SDW-ITS-02-R05-00042
Revision: 01

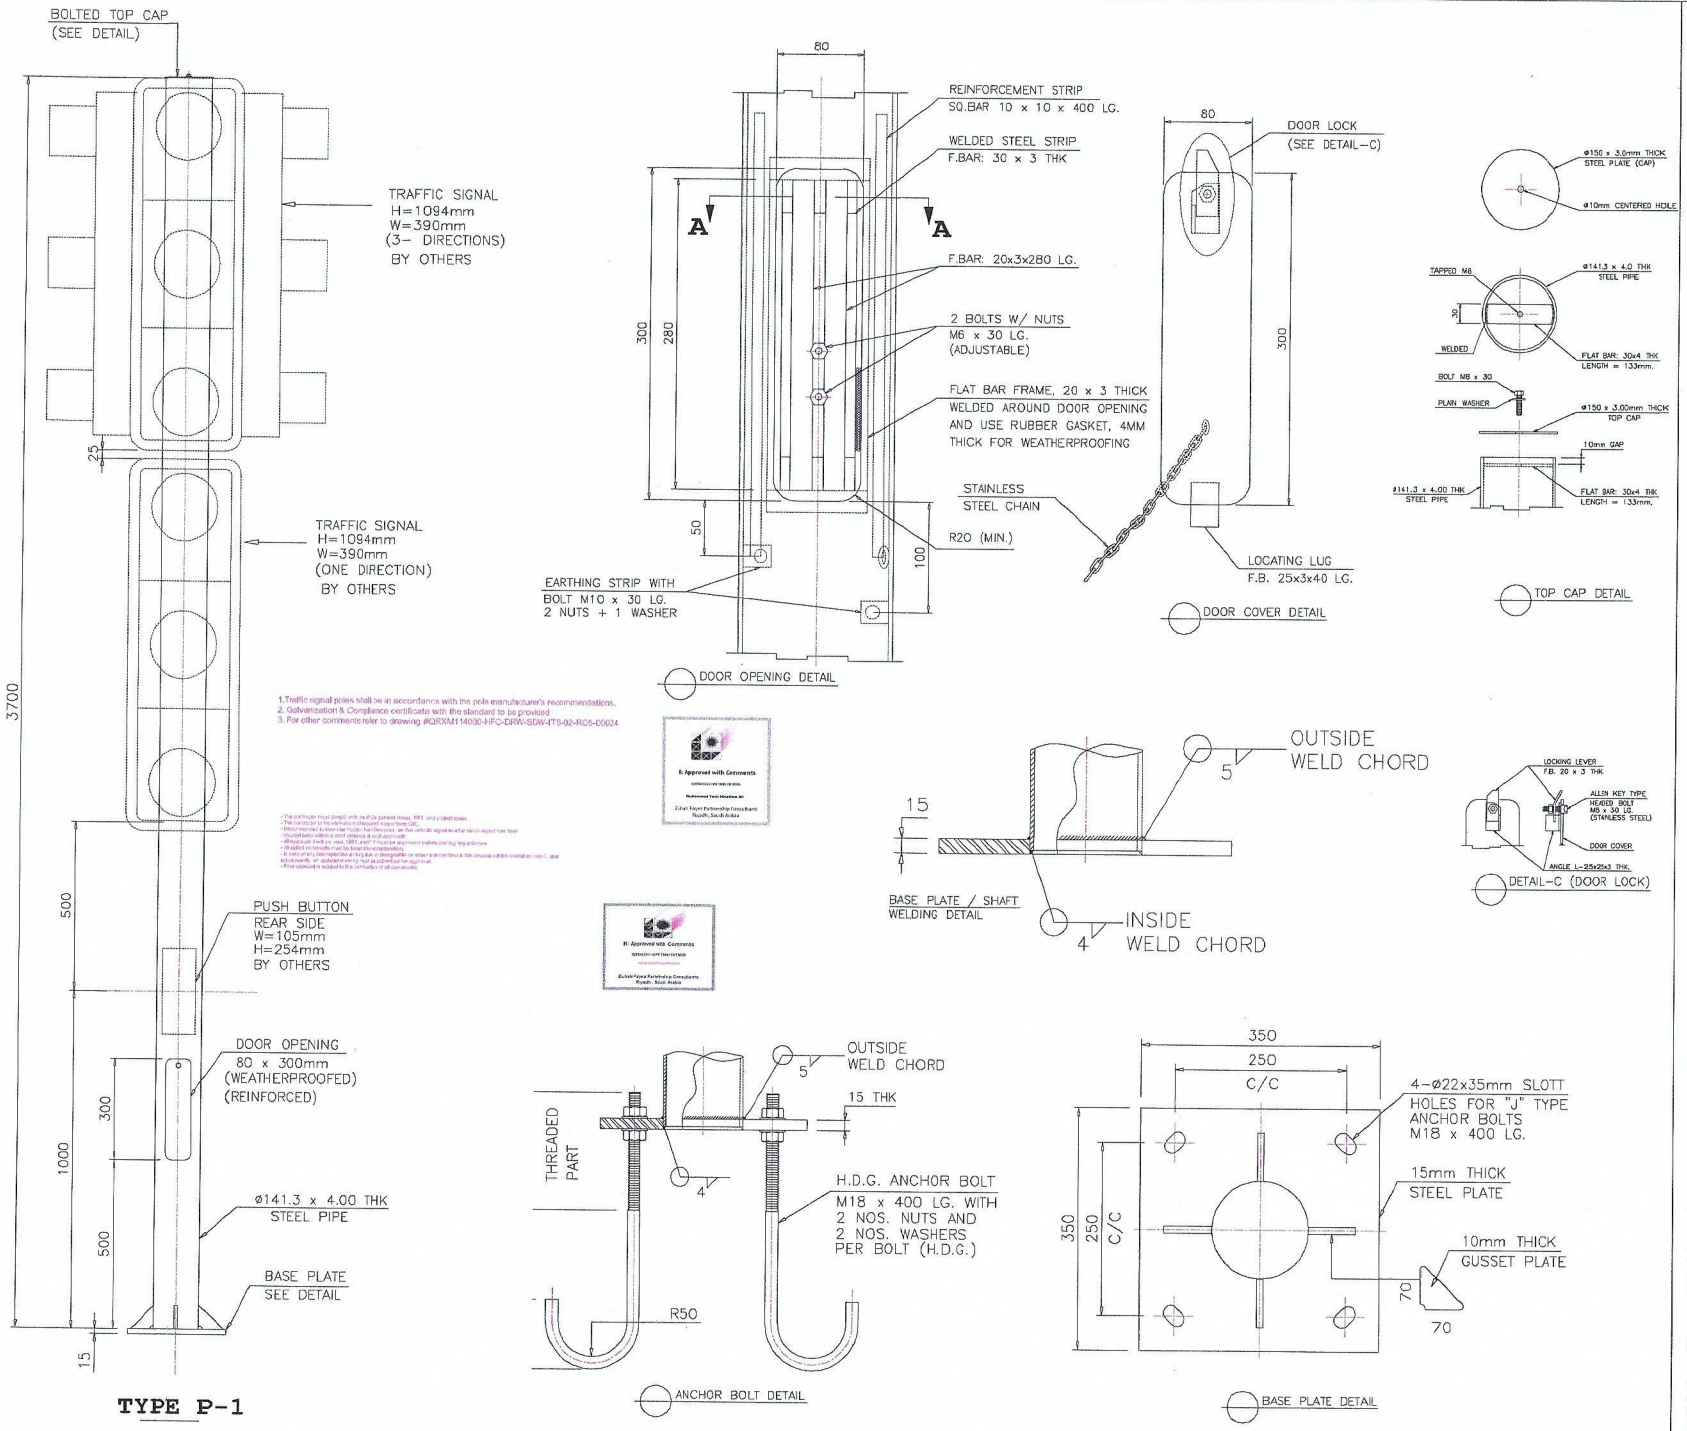

القديـــة
Qiddiya

Consultant's information

HEAD OFFICE - Riyadh
6283 King Abdul Aziz Rd, Ar Rabi
Riyadh 13316 2771, Saudi Arabia
Tel.: +966 11 4048484
Fax : +966 11 4048400
Website : www.zfp.com
Email.: zfpr@zfp.com

Zuhair Fayez Partnership

Notes:
1. ALL DIMENSIONS ARE IN MILLIMETER UNLESS OTHERWISE STATED.
2. ALL LEVELS ARE IN METERS UNLESS NOTED OTHERWISE.
3. THIS DRAWINGS IS TO BE READ IN CONJUNCTION WITH ALL RELEVANT ARCHITECTURAL, STRUCTURAL AND SERVICES DRAWINGS.

REFERENCE I.F.C DESIGN DRAWING NO:
1. QRXP117115-DAH-VORA2R-DWG-ITS-R3-Z00000-2000002
2. QRXP117115-DAH-VORA2R-DWG-ITS-R3-Z00000-5000001
3. QRXP117115-DAH-VORA2R-DWG-ITS-R3-Z00000-5000002
4. QRXP117115-DAH-VORA2R-DWG-ITS-R3-Z00000-5000005
5. QRXP117115-DAH-VORA2R-DWG-ITS-R3-Z00000-5000006
6. QRXP117115-DAH-VORA2R-DWG-ITS-R3-Z00000-6000001
7. QRXP117115-DAH-VORA2R-DWG-ITS-R3-Z00000-6000002
8. QRXP117115-DAH-VORA2R-DWG-ICT-R3-Z00000-2000000

LEGEND:

Rev. No.	Date	Description	Appr.
00	30-8-2025	FOR REVIEW AND APPROVAL	c
01	04-11-2025	FOR REVIEW AND APPROVAL	
--	--	--	--
--	--	--	--
--	--	--	--
--	--	--	--
--	--	--	--

Consultant
Contractor
Hail Company
ITS Contractor
TRAFFIC TECH
Project:
القديـــة Qiddiya

Job title: Road Access To Resort Core


Drawing title:
SHOPDRAWING OF TRAFFIC SIGNAL SYSTEM FOR JUNCTION-2
TYPICAL STANDARD DETAIL OF 3.7m TUBULAR TRAFFIC SIGN POLE

Sheet number:
SHEET 9 / 19

Scale:1:1000 @ A0

Drawn: M.Sayed	Checked: M.Sayed
Designed:	Approved:

Drawing number: QRXM114000-HFC-DRW-SDW-ITS-02-R05-00032
Revision: 01

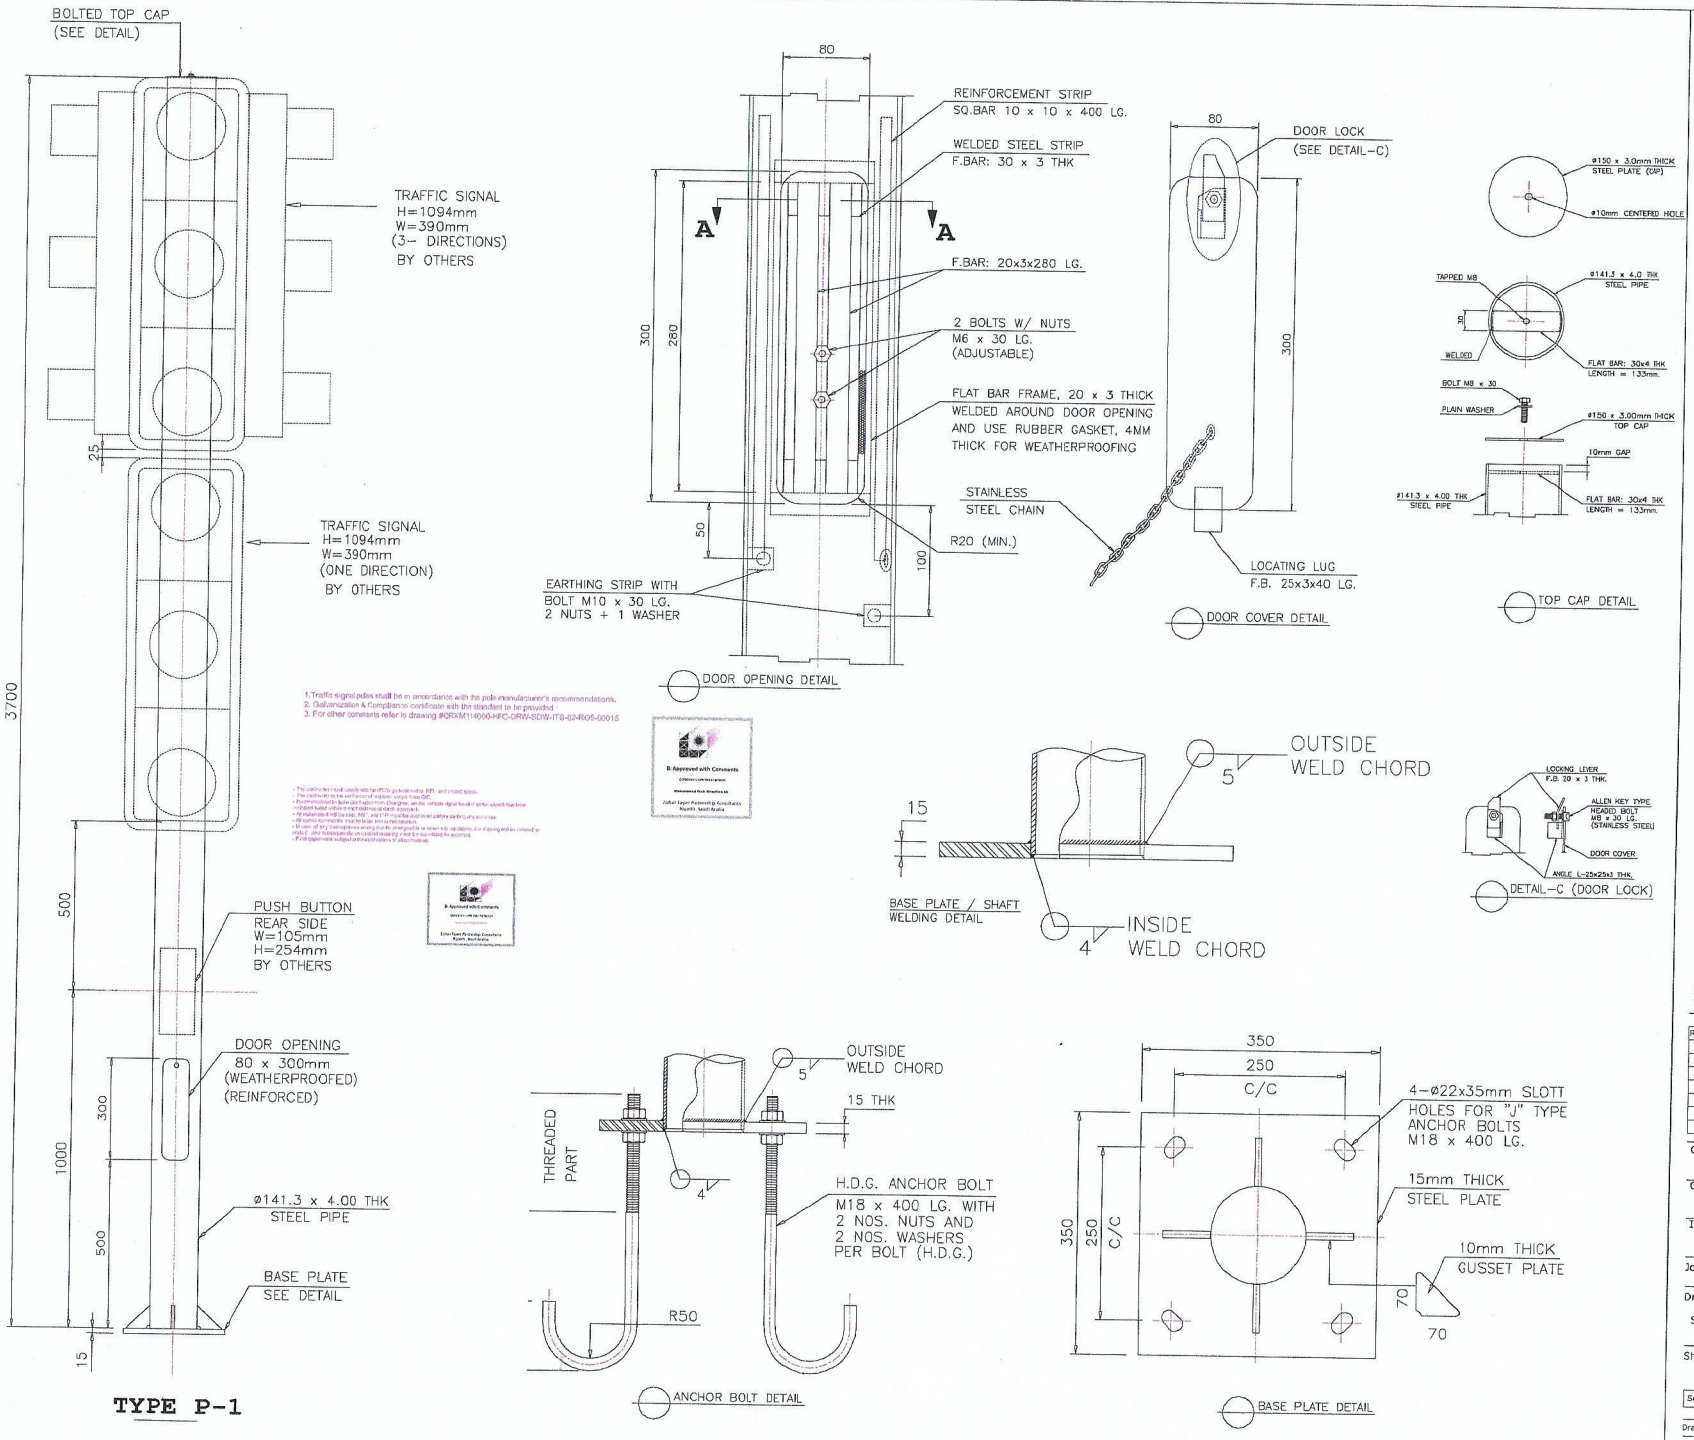

1. Traffic signal poles shall be in accordance with the pole manufacturer's recommendations.
2. Communication & Compliance certificate with the standard to be provided.
3. For other comments refer to drawing #QRXM114000-HFC-DRW-SDW-ITS-02-RO5-00015

B-Approved with Comments

Zuhair Fayez Partnership Consultants
Riyadh, Saudi Arabia

B-Approved with Comments

Zuhair Fayez Partnership Consultants
Riyadh, Saudi Arabia

Consultant's information

HEAD OFFICE - Riyadh
6283 King Abdul Aziz Rd, Ar Rabi
Riyadh 13316 2771, Saudi Arabia
Tel.: +966 11 4048484
Fax : +966 11 4048400
Website : www.zfp.com
Email.: zfpr@zfp.com

Zuhair Fayez Partnership

Notes:
1. ALL DIMENSIONS ARE IN MILLIMETER UNLESS OTHERWISE STATED.
2. ALL LEVELS ARE IN METERS UNLESS NOTED OTHERWISE.
3. THIS DRAWINGS IS TO BE READ IN CONJUNCTION WITH ALL RELEVANT ARCHITECTURAL, STRUCTURAL AND SERVICES DRAWINGS.

REFERENCE I.F.C DESIGN DRAWING NO:
1. QRXP117115-DAH-VORA2R-DWG-ITS-R3-Z00000-2000001
2. QRXP117115-DAH-VORA2R-DWG-ITS-R3-Z00000-5000001
3. QRXP117115-DAH-VORA2R-DWG-ITS-R3-Z00000-5000005
4. QRXP117115-DAH-VORA2R-DWG-ITS-R3-Z00000-5000006
5. QRXP117115-DAH-VORA2R-DWG-ITS-R3-Z00000-6000001
6. QRXP117115-DAH-VORA2R-DWG-ICT-R3-Z00000-2000000

LEGEND:

Rev. No.	Date	Description	Appr.
00	30-8-2025	FOR REVIEW AND APPROVAL	C
01	06-10-2025	FOR REVIEW AND APPROVAL	B
02	04-11-2025	FOR REVIEW AND APPROVAL	
--	--	--	--
--	--	--	--
--	--	--	--
--	--	--	--

Consultant

Contractor
Hail Company

ITS Contractor
TRAFFIC TECH

Project:
Qiddiya

Job title:
Road Access To Resort Core

Drawing title:
SHOPDRAWING OF TRAFFIC SIGNAL SYSTEM FOR JUNCTION-1
TYPICAL STANDARD DETAIL OF 3.7m TUBULAR TRAFFIC SIGN POLE

Sheet number:
SHEET 9 / 18

Scale: NTS

Drawn: M.Sayed | Checked: M.Sayed
Designed: | Approved:

Drawing number:
QRXM114000-HFC-DRW-SDW-ITS-02-RO5-00023

Revision
02

PO	EAST	NORTH	ELEVATION
1	632138.885	2719234.34	658.387
2	632138.28	2719241.965	658.44
3	632128.838	2719240.748	658.293
4	632124.691	2719236.917	658.215
5	632131.997	2719232.448	658.317
6	632121.255	2719248.447	658.164
7	632148.012	2719242.377	658.625
8	632156.743	2719242.595	658.755
9	632157.586	2719234.625	658.631
10	632174.754	2719237.675	658.472
11	632171.439	2719241.221	658.465
12	632167.604	2719242.976	658.566
13	632169.913	2719232.624	658.514
14	632175.376	2719232.556	658.468
15	632175.966	2719222.166	658.527

16	632174.532	2719210.625	658.448
17	632174.617	2719212.421	658.468
18	632183.076	2719194.478	658.194
19	632178.172	2719191.19	658.227
20	632168.024	2719188.768	658.364
21	632168.252	2719195.041	658.409
22	632174.104	2719197.502	658.37
23	632175.448	2719162.97	658.034
24	632179.435	2719166.675	658.089
25	632157.494	2719189.074	658.465
26	632154.134	2719189.149	658.484
27	632131.175	2719197.462	658.08
28	632136.235	2719192.242	658.068
29	632140.203	2719187.847	658.115
30	632143.072	2719189.361	658.274
31	632138.359	2719197.567	658.138

32	632131.138	2719217.997	658.261
33	632132.383	2719220.936	658.274
34	632138.108	2719218.476	658.365
35	632130.799	2719207.891	658.154
36	632237.607	2719699.148	662.562
37	632238.781	2719696.334	662.572
38	632231.59	2719700.406	662.45
39	632231.099	2719696.091	662.469
40	632220.776	2719691.807	662.621

41	632208.563	2719687.065	662.396
42	632200.544	2719659.702	662.17
43	632239.511	2719708.132	662.199
44	632184.685	2719182.257	658.226
45	632180.734	2719156.592	657.991
46	632128.759	2719185.172	657.821
47	632051.893	2719461.749	660.761
48	632050.096	2719459.952	660.749
49	632061.403	2719468.899	660.703
50	632059.245	2719468.742	660.759
51	632060.574	2719475.153	660.841
52	632056.312	2719476.726	661.028
53	632042.796	2719452.921	660.659
54	632036.168	2719448.179	660.258
55	632033.398	2719454.838	660.518
56	632023.802	2719464.954	660.739

57	632026.466	2719494.802	660.836
58	632041.156	2719509.459	660.939
59	632030.514	2719447.918	660.622
60	632030.9	2719438.025	660.356
61	632074.267	2719471.424	660.296
62	632046.642	2719486.914	661.152
63	632055.083	2719495.166	661.262
64	632210.496	2719649.302	662.478
65	632221.913	2719637.62	662.26
66	632223.236	2719636.041	662.202
67	632228.749	2719635.365	662.156
68	632231.178	2719643.731	662.229
69	632238.412	2719648.266	662.269
70	632246.517	2719637.924	662.077
71	632254.324	2719646.003	662.028
72	632251.337	2719653.099	662.132

73	632260.055	2719674.588	662.635
74	632250.505	2719684.5	662.914
75	632252.571	2719682.345	662.816
76	632244.338	2719679.11	662.814
77	632181.4207	2719243.575	658.472
78	632222.3721	2719627.431	662.202

QIDDIYA DEVELOPMENT COMPANY

DOCUMENT NUMBER:	QDC-ADM-TEM-QMS-00004	REVISION NUMBER:	00	ISSUED BY:	PMO
DOCUMENT TITLE	WIR FORM	DOCUMENT TYPE:	FORM	DATE ISSUED:	MAY-08-2022

WORK INSPECTION REQUEST (WIR) FORM

Contractor:	HAIF-FREYSSINET JV
Project:	RA2RC
Contract No.:	QPMO-410-CT-00618
Work Inspection Request Number:	QRXM114000-HFC-TEC-WIR-ITS-02-RO5-00017

HAIF-FREYSSINET JV

Discipline

Architecture	☐	Mechanical	☐	Information Technology	☐	Quality	☐	Project Controls	☐
Civil / Structural	☑	Electrical	☐	Landscape	☐	Safety	☐	Construction Management	☐
Other	☐								

WORK DESCRIPTION

Inspection / Test Location:	INTERIM ROAD Sta. (1 TO 40) JUNCTION -1		
GIS/GPS GeoTag Coordinates (If applicable)			
Inspection Date:	08-Jun-2026	Inspection Start Time:	8:30 am
ITP:	QRXM114000-HFC-TEC-ITP-ITS-02-RO5-00006	Checklist:	HFC-CKL-9002
Spec's / Dwg. Ref.:	QRXM114000-HFC-DRW-SDW-ITS-02-RO5-00015	Approved Method Statement Number:	QRXM114000-HFC-TEC-MST-ITS-02-RO5-00001
Attachments:	☑ Drawings ☑ Data Sheets ☐ TQs/RFI ☐ OTHER QRXM114000-HFC-DRW-SDW-CIV-02-RO5-00001		

DESCRITPTION OF WORK

Inspection request for Installing ITS Traffic Signal Poles Concrete Foundation Junction-1 1 TO 40 Of Traffic Signal Poles 3.7m. at Access to Resort core interim Road. ,Main Line-02 , As per attached drawing. JY

CONTRACTOR - QUALITY INSPECTOR - INITIAL INSPECTION FINDINGS:

Complies with Approved ITPs/Checklists?	◉ YES ○ NO ○ NA	REMARKS	
All Strucutral Embedded Items Cleared?	○ YES ○ NO ○ NA	WIR Number	
Embedded Electrical Items Cleared by Electrical QC?	○ YES ○ NO ○ NA	WIR Number	
Embedded Mechanical Items Cleared by Mechanical QC?	○ YES ○ NO ○ NA	WIR Number	

Accepted:	◉
Accepted with Comments (See Remarks):	○
Rejected (See Remarks):	○

REMARKS:					
Name:	Moataz	Signature:		Date:	08/06/26

QIDDIYA / SUPERVISION CONSULTANT QC INSPECTOR - FINAL INSPECTION FINDI

Contractor Has compiled with Project spec requirements?	☑ YES ○ NO		☑ YES ○ NO ○ NA
Accepted:			☑
Accepted with Comments (See Remarks):			○
Rejected (See Remarks):			○

A: Approved
Saud Nawab
Zuhair Fayez Partnership Consultants
Riyadh , Saudi Arabia

REMARKS:	Survey checked and found ok Submit all QC documents Listed in the ITP.				
Name:	Mohammed Ebaid	Signature:		Date	8/6/2026

FOR DETAILED MATERIAL INSPECTION STATUS, PLEASE SEE ATTACHED CHECKLIST.
CHECKLISTS THAT ARE NOT ATTACHED AND SIGNED BY SUPERVISION CONSULTANT WILL VOID THIS INSPECTION REQUEST.

This document is the property of Qiddiya Development Company, 2022

78 - 4

ITP/ Approved (Code B)
26.9.26

QIDDIYA DEVELOPMENT COMPANY						
DOCUMENT NUMBER:	QDC-ADM-TEM-QMS-00004	REVISION NUMBER:	0D	ISSUED BY:	PMO	Qiddiya
DOCUMENT TITLE	WIR FORM	DOCUMENT TYPE:	FORM	DATE ISSUED:	MAY-08-2022	

WORK INSPECTION REQUEST (WIR) FORM

Contractor:	HAIF-FREYSSINET JV
Project:	RA2RC
Contract No.:	QPMO-410-CT-00618
Work Inspection Request Number:	QRXM114000-HFC-TEC-WIR-ITS-02-RO5-00040

HAIF-FREYSSINET JV

Discipline

Architecture	☐	Mechanical	☐	Information Technology	☐	Quality	☐	Project Controls	☐
Civil / Structural	☑	Electrical	☐	Landscape	☐	Safety	☐	Construction Management	☐
Other	☐								

WORK DESCRIPTION

Inspection / Test Location:	INTERIM ROAD Sta. (1 TO 19) JUNCTION -2		
GIS/GPS GeoTag Coordinates (If applicable)			
Inspection Date:	09-Jun-2026	Inspection Start Time:	9:30 am
ITP:	QRXM114000-HFC-TEC-ITP-ITS-02-RO5-00006	Checklist:	HFC-CKL-9002
Spec's / Dwg. Ref.:	QRXM114000-HFC-DRW-SDW-ITS-02-RO5-00024	Approved Method Statement Number:	QRXM114000-HFC-TEC-MST-ITS-02-RO5-00001
Attachments:	☑ Drawings ☑ Data Sheets ☐ TQs/RFI ☐ OTHER QRXM114000-HFC-DRW-SDW-CIV-02-RO5-00001		

DESCRIPTION OF WORK

Inspection request for Installing ITS Concrete Foundations Of Traffic Signal Poles 3.7m From 1 TO 19 Junction-2 at Access to Resort core interim Road. ,Main Line-02 , As per attached drawing. 19 PC

CONTRACTOR - QUALITY INSPECTOR - INITIAL INSPECTION FINDINGS:

Complies with Approved ITPs/Checklists?	◉ YES ○ NO ○ NA	REMARKS	
All Strucutral Embedded Items Cleared?	○ YES ○ NO ○ NA	WIR Number	
Embedded Electrical Items Cleared by Electrical QC?	○ YES ○ NO ○ NA	WIR Number	
Embedded Mechanical Items Cleared by Mechanical QC?	○ YES ○ NO ○ NA	WIR Number	

Accepted:	
Accepted with Comments (See Remarks):	◉
Rejected (See Remarks):	○

REMARKS:					
Name:	Moataz Elkhateeb	Signature:		Date:	09-06-2026

QIDDIYA / SUPERVISION CONSULTANT QC INSPECTOR - FINAL INSPECTION FINDINGS:

Contractor Has complied with Project spec requirements?	☑ YES ○ NO	Okay to Proceed with next activity?	☑ YES ○ NO ○ NA
Accepted:			
Accepted with Comments (See Remarks):			☑
Rejected (See Remarks):			○

REMARKS:	Solve x - Checked and Found Ok Submit all documents related to foundations according to the approved ITP (Code "B")				
Name:	Mohammed Ebbaneb	Signature:		Date	9/6/2026

FOR DETAILED MATERIAL INSPECTION STATUS, PLEASE SEE ATTACHED CHECKLIST.
CHECKLISTS THAT ARE NOT ATTACHED AND SIGNED BY SUPERVISION CONSULTANT WILL VOID THIS INSPECTION REQUEST.

This document is the property of Qiddiya Development Company, 2022

No stamp.

ITP/ Approved Code (B)

26.9.26

Junction 3/ 22 PCs

QIDDIYA DEVELOPMENT COMPANY

DOCUMENT NUMBER:	QDC-ADM-TEM-QMS-00007	REVISION NUMBER:	0D	ISSUED BY:	PMO
DOCUMENT TITLE:	MIR FORM	DOCUMENT TYPE:	FORM	DATE ISSUED:	MAY-08-2022

Qiddiya

MATERIAL INSPECTION REQUEST (MIR) FORM

Contractor:	HAIF COMPANY
Project:	QPMO-410-CT-00618- ROAD ACCESS TO RESORT CORE
Contract No.:	QI09043311-VO-0004
Material Inspection Request Number:	QRXM114000-HFC-TEC-MIR-ITS-02-RO5-00009

Haif Company — Freyssinet — HAIF-FREYSSINET JV

Discipline

Architecture	☐	Mechanical	☐	Information Technology	☐	Quality	☐	Project Controls	☐
Civil/Structural	☑	Electrical	☐	Landscape	☐	Safety	☐	Construction Management	☐
Other	☐								

MATERIAL DESCRIPTION

Inspection / Test Location:	INTERIM ROAD MAIN LINE-02		
Material Name:	ITS - POLE	Quantity:	13 Pcs.
P.O Number		Delivery Note Number:	TTSDN-HAIF-251225-012-TTS-HAIF DN-0014
Approved Material Transmittal Number: (Aconex document Approval)	QRXM114000-HFC-TEC-MAT-ITS-02-RO5-00017	Approval Date:	
Inspection Date:	02-Apr-2026	Inspection Start Time:	10:30 AM
ITP:		Checklist:	
Spec's / Dwg. Ref.:	TRAFFIC TECH SECURITY W.L.L	Approved Method Statement Number:	
Attachments:	Test Certificate: ◉ Yes ○ No IFC / Shop Drawings: ○ Yes ◉ No		

DESCRITPTION OF MATERIAL

ITS POLE 7Mtrs. (05 Pcs.) ITS POLE 7Mtrs. for RWIS & QMS (02 Pcs.) ITS POLE 6.1 Mtrs. for Red Light Camera (04 Pcs.) ITS POLE 15 Mtrs. for CCTV Camera (01 Pcs.) Traffic Signal Controller Enconolite For J1 (01 Pcs.) Interim Road Main Line-02

CONTRACTOR - QUALITY INSPECTOR - INITIAL INSPECTION FINDINGS:

Are Complete Details Mentioned in P.O and Delivery Note?	◉ YES ○ NO	REMARKS	
Complies with Approved ITPs/Checklists?	◉ YES ○ NO	REMARKS	
Signs of Physcial Damage?	○ YES ◉ NO	REMARKS	
Conforms to Approved Material Submittal?	○ YES ○ NO	REMARKS	

Accepted:	◉
Accepted with Comments:	○
Rejected (See Remarks):	○

REMARKS:					
Name:	Moataz Elkhateeb	Signature:		Date:	02-04-2026

QIDDIYA / SUPERVISION CONSULTANT QC INSPECTOR - FINAL INSPECTION FINDI

Contractor Has complied with Material requirements?	○ YES ○ NO
Accepted:	
Accepted with Comments:	☑
Rejected (See Remarks):	○

B: Approved with Comments
QI09043311-UPR-TEN17&TEN05
Saud Nawab
Zuhair Fayez Partnership Consultants
Riyadh , Saudi Arabia

ictly? ○ YES ○ NO ○ NA

REMARKS:	① Attach approved ITP. ② Comply with the comments mentioned on attached supporting documents.				
Name:	M. YASIR.	Signature:		Date	02/04/2026.

FOR DETAILED MATERIAL INSPECTION STATUS, PLEASE SEE ATTACHED CHECKLIST.
CHECKLISTS THAT ARE NOT ATTACHED AND SIGNED BY SUPERVISION CONSULTANT WILL VOID THIS INSPECTION REQUEST.

This document is the property of Qiddiya Development Company, 2022

QIDDIYA DEVELOPMENT COMPANY

DOCUMENT NUMBER:	QDC-ADM-TEM-QMS-00004	REVISION NUMBER:	00	ISSUED BY:	PMO
DOCUMENT TITLE	WIR FORM	DOCUMENT TYPE:	FORM	DATE ISSUED:	MAY-08-2022

WORK INSPECTION REQUEST (WIR) FORM

HAIF-FREYSSINET JV

Contractor:	HAIF-FREYSSINET JV
Project:	RA2RC
Contract No.:	QPMO-410-CT-00618
Work Inspection Request Number:	QRXM114000-HFC-TEC-WIR-ITS-02-RO5-00098

Discipline

Architecture	☐	Mechanical	☐	Information Technology	☑	Quality	☐	Project Controls	☐
Civil / Structural	☐	Electrical	☐	Landscape	☐	Safety	☐	Construction Management	☐
Other	☐								

WORK DESCRIPTION

Inspection / Test Location:	INTERIM ROAD Sta. (Red Light Camera)		
GIS/GPS GeoTag Coordinates (If applicable)			
Inspection Date:	07-Sep-2026	Inspection Start Time:	10:00 am
ITP:	QRXM114000-HFC-TEC-ITP-ITS-02-RO5-00003	Checklist:	HFC-CKL-6003
Spec's / Dwg. Ref.:	QRXM114000-HFC-DRW-SDW-ITS-02-RO5-00026-033	Approved Method Statement Number:	QRXM114000-HFC-TEC-MST-ITS-02-RO5-00001
Attachments:	☑ Drawings ☐ Data Sheets ☐ TQs/RFI ☐ OTHER		

DESCRITPTION OF WORK

Inspection request for Installation of ITS Red Light Camera 6.1m.Pole with Accessories(7 Pcs.) at Junction-2 (03 No,s) and Junction-3 (04 No,s), at Access to Resort core interim Road. As per attached drawing.

CONTRACTOR - QUALITY INSPECTOR - INITIAL INSPECTION FINDINGS:

Complies with Approved ITPs/Checklists?	◉ YES ○ NO ○ NA	REMARKS	
All Strucutral Embedded Items Cleared?	○ YES ○ NO ○ NA	WIR Number	
Embedded Electrical items Cleared by Electrical QC?	○ YES ○ NO ○ NA	WIR Number	
Embedded Mechanical Items Cleared by Mechanical QC?	○ YES ○ NO ○ NA	WIR Number	

Accepted:	
Accepted with Comments (See Remarks):	◉
Rejected (See Remarks):	○
REMARKS:	○

Name:	Moataz Elkhateeb	Signature:		Date:	07-09-2026

QIDDIYA / SUPERVISION CONSULTANT QC INSPECTOR - FINAL INSPECTION FINDINGS:

Contractor Has complied with Project spec requirements?	☑ YES ○ NO	Okay to Proceed with next activity?	☑ YES ○ NO ○ NA

Accepted:	☑
Accepted with Comments (See Remarks):	☐
Rejected (See Remarks):	○
REMARKS:	QIC Confirms that the above activity was inspected, witnessed, and or approved by the former CSC (2AP). all associated responsibilities, liabilities, and obligations remain solely with 2AP. Dar's role is strictly limited to documentation review & shall not constitute acceptance of any such responsibilities or liabilities. final approval is subject to successful testing & commissioning.

Name:	Zawar Ahmad	Signature:		Date	9/9/26

FOR DETAILED MATERIAL INSPECTION STATUS, PLEASE SEE ATTACHED CHECKLIST.
CHECKLISTS THAT ARE NOT ATTACHED AND SIGNED BY SUPERVISION CONSULTANT WILL VOID THIS INSPECTION REQUEST.

This document is the property of Qiddiya Development Company, 2022

QIDDIYA DEVELOPMENT COMPANY

DOCUMENT NUMBER:	QDC-ADM-TEM-QMS-00004	REVISION NUMBER:	00	ISSUED BY:	PMO
DOCUMENT TITLE	WIR FORM	DOCUMENT TYPE:	FORM	DATE ISSUED:	MAY-08-2022

WORK INSPECTION REQUEST (WIR) FORM

Contractor:	HAIF-FREYSSINET JV
Project:	RA2RC
Contract No.:	QPMO-410-CT-00618
Work Inspection Request Number:	QRXM114000-HFC-TEC-WIR-ITS-02-RO5-00064

HAIF-FREYSSINET JV

Discipline

Architecture	☐	Mechanical	☐	Information Technology	☐	Quality	☐	Project Controls	☐
Civil / Structural	☑	Electrical	☐	Landscape	☐	Safety	☐	Construction Management	☐
Other	☐								

WORK DESCRIPTION

Inspection / Test Location:	INTERIM ROAD Sta. JUNCTION -3 Aera		
GIS/GPS GeoTag Coordinates (If applicable)			
Inspection Date:	06-Jun-2026	Inspection Start Time:	9:10 am
ITP:	QRXM114000-HFC-TEC-ITP-ITS-02-RO5-00006	Checklist:	HFC-CKL-9002
Spec's / Dwg. Ref.:	QRXM114000-HFC-DRW-SDW-ITS-02-RO5-00024	Approved Method Statement Number:	QRXM114000-HFC-TEC-MST-ITS-02-RO5-00001
Attachments:	☑ Drawings ☑ Data Sheets ☐ TQs/RFI ☐ OTHER QRXM114000-HFC-DRW-SDW-CIV-02-RO5-00001		

DESCRIPTION OF WORK

Inspection request for Installing ITS Concrete Foundations Of Traffic Signal Poles 3.7m From 1 TO 26 Junction-3 & Installing ITS Traffic Signal Cabinet Foundations Junction-3 & Installing ITS Cabinet Ground Mounted Enclosure Foundation (GME) Junction-3 As Shown On Attached Drawing at Access to Resort core interim Road.

CONTRACTOR - QUALITY INSPECTOR - INITIAL INSPECTION FINDINGS:

Complies with Approved ITPs/Checklists?	◉ YES ○ NO ○ NA	REMARKS	
All Strucutral Embedded Items Cleared?	○ YES ○ NO ○ NA	WIR Number	
Embedded Electrical items Cleared by Electrical QC?	○ YES ○ NO ○ NA	WIR Number	
Embedded Mechanical Items Cleared by Mechanical QC?	○ YES ○ NO ○ NA	WIR Number	

Accepted:	◉
Accepted with Comments (See Remarks):	○
Rejected (See Remarks):	○

REMARKS:					
Name:	Moataz Elkhateeb	Signature:		Date:	06-06-2026

QIDDIYA / SUPERVISION CONSULTANT QC INSPECTOR - FINAL INSPECTION FINDINGS:

Contractor Has complied with Project spec requirements?	○ YES ○ NO	Okay to Proceed with next activity?	○ YES ○ NO ○ NA

Accepted:	○
Accepted with Comments (See Remarks):	○
Rejected (See Remarks):	○

REMARKS:	Submit all QC documents Listed in the ITP				
Name:	Mahmoud Mekky	Signature:		Date	25.9.25

FOR DETAILED MATERIAL INSPECTION STATUS, PLEASE SEE ATTACHED CHECKLIST.
CHECKLISTS THAT ARE NOT ATTACHED AND SIGNED BY SUPERVISION CONSULTANT WILL VOID THIS INSPECTION REQUEST.

This document is the property of Qiddiya Development Company, 2022