QIDDIYA DEVELOPMENT COMPANY						
DOCUMENT NUMBER:	QDC-ADM-TEM-QMS-00004	REVISION NUMBER:	00	ISSUED BY:	PMO	Qiddiya
DOCUMENT TITLE	WIR FORM	DOCUMENT TYPE:	FORM	DATE ISSUED:	MAY-08-2022	

WORK INSPECTION REQUEST (WIR) FORM

Contractor:	HAIF-FREYSSINET JV
Project:	RA2RC
Contract No.:	QPMO-410-CT-00618
Work Inspection Request Number:	QRXM114000-HFC-TEC-WIR-ITS-02-RO5-00096

HAIF-FREYSSINET JV

Discipline

Architecture	☐	Mechanical	☐	Information Technology	☑	Quality	☐	Project Controls	☐
Civil / Structural	☐	Electrical	☐	Landscape	☐	Safety	☐	Construction Management	☐
Other	☐								

WORK DESCRIPTION

Inspection / Test Location:	INTERIM ROAD Sta. (Vehicle Video Detection System)		
GIS/GPS GeoTag Coordinates (If applicable)			
Inspection Date:	31-Aug-2026	Inspection Start Time:	11:00 am
ITP:	QRXM114000-HFC-TEC-ITP-ITS-02-RO5-00006	Checklist:	HFC-CKL-9003
Spec's / Dwg. Ref.:	QRXM114000-HFC-DRW-SDW-ITS-02-RO5-00033-24-15	Approved Method Statement Number:	QRXM114000-HFC-TEC-MST-ITS-02-RO5-00002
Attachments:	☑ Drawings ☐ Data Sheets ☐ TQs/RFI ☐ OTHER		

DESCRITPTION OF WORK

Inspection request for Installation of Vehicle Video Detection System Junction-1 (04 No,s) , Junction-2 (03 No,s) and Junction-3 (04 No,s), at Access to Resort core interim Road. As per attached drawing.

CONTRACTOR - QUALITY INSPECTOR - INITIAL INSPECTION FINDINGS:

Complies with Approved ITPs/Checklists?	◉ YES ○ NO ○ NA	REMARKS	
All Strucutral Embedded Items Cleared?	○ YES ○ NO ○ NA	WIR Number	
Embedded Electrical items Cleared by Electrical QC?	○ YES ○ NO ○ NA	WIR Number	
Embedded Mechanical Items Cleared by Mechanical QC?	○ YES ○ NO ○ NA	WIR Number	

Accepted:	◉
Accepted with Comments (See Remarks):	○
Rejected (See Remarks):	○

REMARKS:					
Name:	Naseem Ahmed	Signature:	Naseem Ahmed	Date:	31/8/26

QIDDIYA / SUPERVISION CONSULTANT QC INSPECTOR - FINAL INSPECTION FINDINGS:

Contractor Has complied with Project spec requirements?	☑ YES ○ NO	Okay to Proceed with next activity?	☑ YES ○ NO ○ NA

Accepted:	○
Accepted with Comments (See Remarks):	☑
Rejected (See Remarks):	○

REMARKS:	- QIC confirms that the above activity was inspected, witnessed, & or approved by the former Const supervision Consultant (ZHP). All associated responsibilities, liabilities, & obligations				
Name:		Signature:		Date	5/sep/2026

FOR DETAILED MATERIAL INSPECTION STATUS, PLEASE SEE ATTACHED CHECKLIST.
CHECKLISTS THAT ARE NOT ATTACHED AND SIGNED BY SUPERVISION CONSULTANT WILL VOID THIS INSPECTION REQUEST.

This document is the property of Qiddiya Development Company, 2022

remain solely with ZHP. Das's role is strictly limited to documentation review & shall not constitute acceptance of any such responsibilities or liabilities. final approval is for QIC.
- final approval is subject to Succesful testing & Commissioning.

QIDDIYA DEVELOPMENT COMPANY

DOCUMENT NUMBER	QDC-HSW-TSM-QHS-0809	REVISION NUMBER	00	ISSUED BY	HHO
DOCUMENT TITLE	MIR Form	DOCUMENT TYPE	FORM	DATE ISSUED	Mar-06-2022

MATERIAL INSPECTION REQUEST (MIR) FORM

Contractor:	HAIF COMPANY
Project:	QPMO-410-CT-00816- ROAD ACCESS TO RESORT CORE
Contract No.:	QIC/0403/1-VO-0004
Material Inspection Request Number:	QRXM114000-HFC-TEC-MIR-ITS-02-RO5-00011

HAIF-FREYSSINET JV

Discipline

Architecture	☐	Mechanical	☐	Information Technology	☐	Quality	☐	Project Controls	☐
Civil/Structural	☑	Electrical	☐	Landscape	☐	Safety	☐	Construction Management	☐
Other	☐								

MATERIAL DESCRIPTION

Inspection / Test Location:	INTERIM ROAD MAIN LINE-02		
Material Name:	VVDS Vehicle Video Detection System TRAFFIC CAM ACCESS AND CABLES	Quantity:	04 Nos.
P.O Number		Delivery Note Number:	TTSDN-HAIF-010626-022
Approved Material Transmittal Number: (Material Submission Approval)	QRXM114000-HFC-TEC-MAT-ITS-02-RO5-00010	Approval Date:	
Inspection Date:	08-Jun-2026	Inspection Start Time:	10:00 AM
ITP:		Checklist:	
Spec's / Dwg. Ref.:	TRAFFIC TECH SECURITY W.L.L	Approved Method Statement Number:	
Attachments:	Test Certificate: ◉ Yes ○ No IFC / Shop Drawings: ○ Yes ◉ No		

DESCRITPTION OF MATERIAL

Traffic Cam All-Wide (VVDS) With Accessories (03 NOS) II BPL3 EDGE B&SIU (01NOS) Interim Road Main Line-02

CONTRACTOR - QUALITY INSPECTOR - INITIAL INSPECTION FINDINGS:

Are Complete Details Mentioned in P.O and Delivery Note?	◉ YES ○ NO	REMARKS	
Complies with Approved ITPs/Checklists?	◉ YES ○ NO	REMARKS	
Signs of Physical Damage?	○ YES ◉ NO	REMARKS	
Conforms to Approved Material Submittal?	○ YES ○ NO	REMARKS	

Accepted:	
Accepted with Comments:	
Rejected (See Remarks):	

REMARKS:				
Name:	Moataz Elkhateeb	Signature:	Date:	08-06-2026

QIDDIYA / SUPERVISION CONSULTANT QC INSPECTOR - FINAL INSPECTION FIN

Contractor Has complied with Material requirements? ○ YES ○ NO

Accepted:

Accepted with Comments:

Rejected (See Remarks):

REMARKS: ① Final approval is subject to the successful completion and acceptance of Testing and commissioning.
② Comply with the comments mentioned on attached supporting documents.
③ Attach approved ITP

Name: M.Yasir

Signature:

Date: 09/06/2026

FOR DETAILED MATERIAL INSPECTION STATUS, PLEASE SEE ATTACHED CHECKLIST.
UNEVALUATED THAT ARE NOT ATTACHED AND SIGNED BY SUPERVISION CONSULTANT WILL VOID THIS INSPECTION REQUEST.

This document is the property of Qiddiya Development Company, 2022

QIDDIYA DEVELOPMENT COMPANY

DOCUMENT NUMBER	QX-XXX-XXX-QXXXXX7	REVISION NUMBER	00	ISSUED BY	PMO
DOCUMENT TITLE	HSR FORM	DOCUMENT TYPE	FORM	DATE ISSUED	04-09-2022

Qiddiya

MATERIAL INSPECTION REQUEST (MIR) FORM

Contractor:	HAIF COMPANY
Project:	QIPMO-410-CT-00618- ROAD ACCESS TO RESORT CORE
Contract No.:	QIP0943511-WO-0004
Material Inspection Request Number:	QRXM114000-HFC-TEC-MIR-ITS-02-ROS-00010

HAIF-FREYSSINET JV

Discipline

Architecture	☐	Mechanical	☐	Information Technology	☐	Quality	☐	Project Controls	☐
Civil/Structural	☑	Electrical	☐	Landscape	☐	Safety	☐	Construction Management	☐
Other	☐								

MATERIAL DESCRIPTION

Inspection / Test Location:	INTERIM ROAD MAIN LINE-02		
Material Name:	(ATS Vehicle Video Detection System, TRAFFIC CAM, MARSE AND CABLES)	Quantity:	08 Pcs.& 02 Rolls.
P.O Number		Delivery Note Number:	TTSDN-HAIF-010426-019-RO
Approved Material Transmittal Number: (Aconex Document Approval)	QRXM114000-HFC-TEC-MAT-ITS-02-ROS-00010	Approval Date:	
Inspection Date:	08-Apr-2026	Inspection Start Time:	10:30 AM
ITP:		Checklist:	
Spec's / Dwg. Ref.:	TRAFFIC TECH SECURITY W.L.L	Approved Method Statement Number:	
Attachments:	Test Certificate: ◉ Yes ○ No IPC / Shop Drawings: ○ Yes ◉ No		

DESCRIPTION OF MATERIAL

Traffic Cam AI-Wide Export Classification Not Controlled EU HTS Code:852589000 SR#TRC625835,TRC625888,TRC625889 TRC626064,TRC626065, TRC626069, TRC626077,TRC626082 (08 Pcs) TI BPL3 EDGE B&SIU EU HTS Code:8517620000 (02 Rolls.) Interim Road Main Line-02

CONTRACTOR - QUALITY INSPECTOR - INITIAL INSPECTION FINDINGS:

Are Complete Details Mentioned in P.O and Delivery Note?	◉ YES ○ NO	REMARKS	
Complies with Approved ITPs/Checklists?	◉ YES ○ NO	REMARKS	
Signs of Physical Damage?	○ YES ◉ NO	REMARKS	
Conforms to Approved Material Submittal?	○ YES ○ NO	REMARKS	

Accepted:	◉
Accepted with Comments:	○
Rejected (See Remarks):	○

REMARKS:					
Name:	Moataz Elkhateeb	Signature:		Date:	08-04-2026

QIDDIYA / SUPERVISION CONSULTANT QC INSPECTOR - FINAL INSPECTION FINDING

Contractor Has complied with Material requirements?	○ YES ○ NO		VT	○ YES ○ NO ○ NA	
Accepted:					✓
Accepted with Comments:					
Rejected (See Remarks):					
REMARKS:	① Final approval is subject to the acceptance of successful completion of Testing and commissioning.				
Name:	M. YASIR	Signature:		Date	02/04/2026

FOR DETAILED MATERIAL INSPECTION STATUS, PLEASE SEE ATTACHED CHECKLIST.
CHECKLISTS THAT ARE NOT ATTACHED AND SIGNED BY SUPERVISION CONSULTANT WILL VOID THIS INSPECTION REQUEST.

This document is the property of Qiddiya Development Company, 2022.

② Comments will be as mentioned in attached

Client:	Consultant:	Contractor:
Qiddiya	Zuhair Fayez Partnership	Haif Company / Freyssinet — HAIF-FREYSSINET JV

TECHNICAL DOCUMENTS

Project Name: Package 3 - Interim Road Access to Resort Core	**Project Code:** QRXM114000
Location: 00	**Date:** 4 -June-2026
Document Title: **Inspection & Test Plan for Inteligent Transportation System Works for TRAFFIC SIGNAL SYSTEM**	**Ref No:** QRXM114000-HFC-TEC-ITP-ITS-00006
	Rev No: 00

Department: ☐ Architectural ☐ Structural ☒ Electrical ☐ Mechanical ☐ Authority ☐ Civil

Type: ☐ Pre-Qualification ☐ Method Statement ☐ Material Submittal ☐ Sample ☒ ITP

Document Description: This is Inspection&Test Plan for Inspection&Test Plan for Inteligent Transportation system Works for TRAFFIC SIGNAL SYSTEM

Doc. Ref. No.	Title
QRXM114000-HFC-TEC-ITP-ITS-00006	**Inspection&Test Plan for Inteligent Transportation system Works for TRAFFIC SIGNAL SYSTEM**

Enclosure:

Submitted By:	**Received By:**
Name: Eng. Moataz Signature: Date: 4 -June-2026	Name: Signature: Date:

Below portion for Consultant Supervision use only

Status: ☐A- Approved ☐B- Approved as noted ☐C- Revise & Resubmit ☐R- For information only

Comments: All the work shall be carried out inaccordance with project specification, relevant standards & codes and manufacturer recommendations.

A: Approved — Zuhair Fayez Partnership Consultants, Riyadh, Saudi Arabia

A: Approved — Zuhair Fayez Partnership Consultants, Riyadh, Saudi Arabia

A: Approved — Zuhair Fayez Partnership Consultants, Riyadh, Saudi Arabia

Below portion for Client use only

Comments:

Signed by: Signature: Date:

HAIF-FSA JV Inspection & Test Plan										
Inteligent Transportation System Works for TRAFFIC SIGNAL SYSTEM							I &TP	APPROVED DATE	**DISCIPLINE ITS**	
PROJECT TITLE:WBS Access Road To Resort Core (RA2RC)							**HFC-ITP-090**			
WIR No.							CONTRACTOR/SUBCONTRACTOR			
							CONSTRUCTION- Intelligent Transportation System Works for TRAFFIC SIGNAL SYSTEM		HAIF	
ITEM NO.	PROJECT PHASE	TASK / ACTIVITY	Quality Requirements /references/ specifications	Quality Record	INSPECTION RESPONSIBILITY ASSIGNMENTS			REMARKS		
					Contractor	Third Party	Consultant			
1.0 DOCUMENT REVIEW										
1.7		Material Approval & Shop Drawing - Vehicle Video Detection System	QRXP117115-DAH-VORA2R-SPE-INF-R1-Z00000-000001-0B Section 137714 VEHICLE DETECTION SYSTEM IFC Drawing QRXP117115-DAH-VORA2R-DWG-GEN-R3-Z00000-5000006	QRXM114000-HFC-TEC-MAT-ITS-02-R05-00010 Material Approval Request for VEHICLE VIDEO DETECTION SYSTEM Approved SHOP DRAWINGS: QRXM114000-HFC-DRW-SDW-ITS-02-R05-00019-R02 QRXM114000-HFC-DRW-SDW-ITS-02-R05-00031-R01 QRXM114000-HFC-DRW-SDW-ITS-02-R05-00044-R01	R		H			
2.0 MATERIAL RECEIVING INSPECTION										
2		Material receiving inspection, protection & storage	QD0002-ADM-TEM-QMS00007[0A] MaterialReceiving Inspection in site HFC-CKL-9001	QD0002-ADM-TEM-QMS00007[0A] MaterialReceivingInspection in site HFC-CKL-9001	H		H	MIR to be submitted		
3.0 WORK INSTALLATION										
3.1		PRE - INSTALLATION	HFC-CKL-9002	HFC-CKL-9002	H		H			
3.2		INSTALLATION	HFC-CKL-9003	HFC-CKL-9003	H		H			
3.3		TESTING	HFC-CKL-9004	HFC-CKL-9004	H		H			

GENERAL NOTES

1	Surveillance: QA/QC organization to monitor work in progress without notice from Construction Organization
2	Witness: QA/QC organization shall be notified of the timing of Inspection or test in advance. However, the inspection or test shall be performed as scheduled if the QA/QC organization representative is not present
3	Hold: QA/QC organization shall be notified of the timing of inspection or test in advance. Inspection or test shall not be carried out without the QA/QC organization representative in attendance.
4	If the Main Contractor delegates the assigned responsibility to the Subcontractor, then the Main Contractor will have the same degree of responsibility as assigned to Consultant.

LEGEND

H	Hold Point for QC Inspection/ Test	R	Review of Documents
W	Witness Inspection/T	RH	Review & approval of Documents
S	Surveillance		


Checklist : HFC-CKL-9003			
INSTALLATION OF TRAFFIC SIGNAL SYSTEM	Checklist	APPROVED DATE	DISCIPLINE
PROJECT TITLE: Road Access To Resort Core (RA2RC)	HFC-CKL-9003		ITS
WIR No.	WBS	CONTRACTOR/SUBCONTRACTOR	
	CONSTRUCTION- Intelligent Transportation System Works for INSTALLATION AND OPERATION of TRAFFIC SIGNAL SYSTEM	HAIF	

ITEM NO.	Check Points & Acceptance Criteria	Reference	Pass	Fail	Not Applicable	Re-Inspection
1.0	**INSTALLATION OF TRAFFIC SIGNAL SYSTEM - EMERGENCY VEHICLE PRE-EMPTION SYSTEM (EVPS)**					
ITEM NO.	Check Points & Acceptance Criteria	Reference	Pass	Fail	Not Applicable	Re-Inspection
8.0	**INSTALLATION OF TRAFFIC SIGNAL SYSTEM - VEHICLE VIDEO DETECTION SYSTEM**					
8.1	Are all Shop Drawings, Method Statement and Material Submittals were approved ?	QRXP117115-DAH-VORA2R-SPE-INF-R1-Z00000-000001-0H SECTION 137715 VEHICLE DETECTION SYSTEM	✓			
8.2	Are all VEHICLE VIDEO DETECTION SYSTEM installed as per approved Material Submittals?	QRXP117115-DAH-VORA2R-SPE-INF-R1-Z00000-000001-0H SECTION 137715 VEHICLE DETECTION SYSTEM	✓			
8.3	Are all VEHICLE VIDEO DETECTION SYSTEM material quantity as per approved Material Submittals and Shop Drawings?	QRXP117115-DAH-VORA2R-SPE-INF-R1-Z00000-000001-0H SECTION 137715 VEHICLE DETECTION SYSTEM	✓			
8.4	Is installation performed in accordance with the applicable standards, requirements, manufacturers' guidelines and any authorities having jurisdiction	QRXP117115-DAH-VORA2R-SPE-INF-R1-Z00000-000001-0H SECTION 137715 VEHICLE DETECTION SYSTEM	✓			
8.5	Is the camera mounted on approved pole/mast arm/signal pole?	QRXP117115-DAH-VORA2R-SPE-INF-R1-Z00000-000001-0H SECTION 137715 VEHICLE DETECTION SYSTEM	✓			
8.6	Is the Mounting height as per specification	QRXP117115-DAH-VORA2R-SPE-INF-R1-Z00000-000001-0H SECTION 137715 VEHICLE DETECTION SYSTEM	✓			
8.7	Is the camera firmly secured with proper brackets and fasteners?	QRXP117115-DAH-VORA2R-SPE-INF-R1-Z00000-000001-0H SECTION 137715 VEHICLE DETECTION SYSTEM	✓			
8.8	Are Camera orientation aligned towards approach lanes?	QRXP117115-DAH-VORA2R-SPE-INF-R1-Z00000-000001-0H SECTION 137715 VEHICLE DETECTION SYSTEM	✓			
8.9	Are the cables terminated and properly labeled as per approved shop drawings?	QRXP117115-DAH-VORA2R-SPE-INF-R1-Z00000-000001-0H SECTION 137715 VEHICLE DETECTION SYSTEM	✓			
8.10	Is the earthing/grounding installed and verified?	QRXP117115-DAH-VORA2R-SPE-INF-R1-Z00000-000001-0H SECTION 137715 VEHICLE DETECTION SYSTEM	✓			
8.11	Did Technical Manual received for installed materials?	QRXP117115-DAH-VORA2R-SPE-INF-R1-Z00000-000001-0H SECTION 137715 VEHICLE DETECTION SYSTEM	✓			

Remarks

PM/Contractor			QDC		
Contractor Construction			Third Party (if applicable)		
The work is ready for inspection			Document Reviewed	Work Inspected	Test Records Verified
Name	Signature	Date	Name	Signature	
Contractor QC Inspector		31/8/26	QDC Supervision Consultant		

Form Ref No. QD0002-ADM-TEM-QTY-00003– Rev.0A

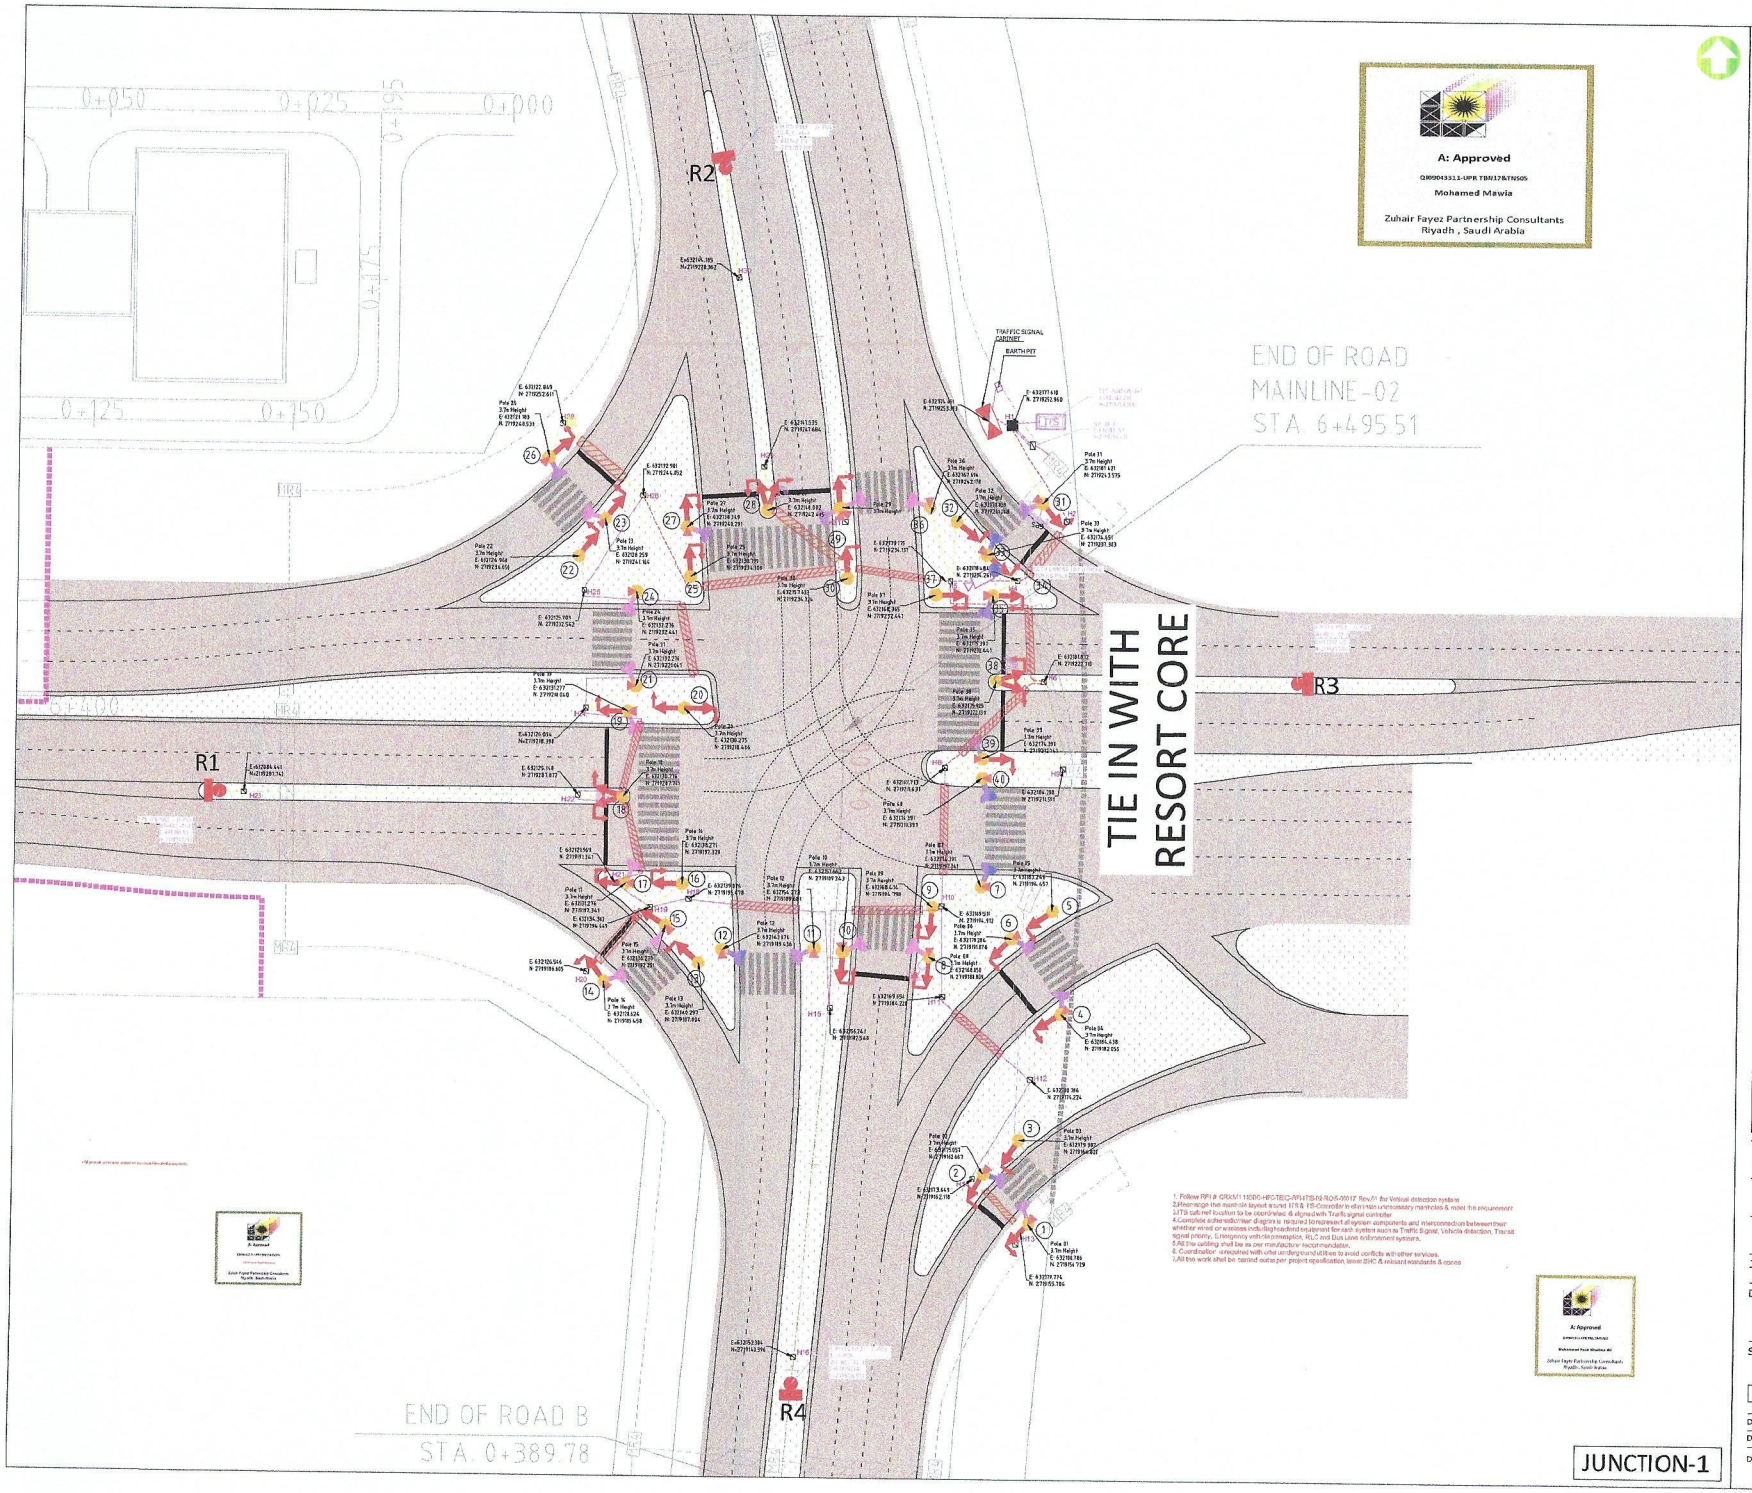

A: Approved
QRXM0433.1-UPR TBM17&TNS05
Mohamed Mawia
Zuhair Fayez Partnership Consultants
Riyadh , Saudi Arabia

القدية
Qiddiya

Consultant's information

HEAD OFFICE - Riyadh
6283 King Abdul Aziz Rd, Ar Rabi
Riyadh 13316 2771, Saudi Arabia
Tel.: +966 11 4048484
Fax : +966 11 4048400
Website : www.zfp.com
Email.: zfpr@zfp.com

Zuhair Fayez Partnership

Notes:
1. ALL DIMENSIONS ARE IN MILLIMETER UNLESS OTHERWISE STATED.
2. ALL LEVELS ARE IN METERS UNLESS NOTED OTHERWISE.
3. THIS DRAWINGS IS TO BE READ IN CONJUNCTION WITH ALL RELEVANT ARCHITECTURAL, STRUCTURAL AND SERVICES DRAWINGS.

REFERENCE I.F.C DESIGN DRAWING NO:
1. QRXP117115-DAH-VORA2R-DWG-ITS-R3-Z00000-2000001
2. QRXP117115-DAH-VORA2R-DWG-ITS-R3-Z00000-5000001
3. QRXP117115-DAH-VORA2R-DWG-ITS-R3-Z00000-5000005
4. QRXP117115-DAH-VORA2R-DWG-ITS-R3-Z00000-5000006
5. QRXP117115-DAH-VORA2R-DWG-ITS-R3-Z00000-6000001
6. QRXP117115-DAH-VORA2R-DWG-ICT-R3-Z00000-2000000

LEGEND:

SIGNAL PEDESTAL - 3.5m HEIGHT	CONCRETE ENCASED DUCT BANK
VEHICLE SIGNAL HEAD - CIRCULAR ASPECTS	UNPLASTICISED POLYVINYL CHLORIDE DUCT, Ø 110mm
VEHICLE SIGNAL HEAD - ARROW ASPECTS	UNPLASTICISED POLYVINYL CHLORIDE DUCT, Ø 110mm
VEHICLE SIGNAL HEAD - RIGHT TURN ASPECTS	UNPLASTICISED POLYVINYL CHLORIDE DUCT, Ø 110mm
VEHICLE SIGNAL HEAD - LEFT TURN ASPECTS	UNPLASTICISED POLYVINYL CHLORIDE DUCT, Ø 110mm
PEDESTRIAN HEAD SIGNAL	CLOSED CIRCUIT TELEVISION POLE - 5m HEIGHT
PEDESTRIAN PUSH BUTTON	CLOSED CIRCUIT TELEVISION CAMERA (BY OTHERS)
SIGNAL PEDESTAL/GANTRY NUMBER	VEHICLE DETECTION SYSTEM
JUNCTION BOX TYPE 1 : (800x400x600)	TRAFFIC SIGNAL CABINET
JUNCTION BOX TYPE 2 : (600x400x300)	ITS CABINET (GROUND MOUNTED ENCLOSURE 60MT)
JUNCTION BOX (LS)	RED LIGHT I-CAMERA WITH IR ILLUMINATOR (RLC)
GLOBAL POSITIONING SYSTEM ANTENNA	NUMBER OF DEVICES ON THE SAME LOCATION
DC-AAT 400V BIDIRECTIONAL CONVERTER (PACKAGE BY OTHERS)	DEVICE NO. IN THE TSSDRSPSHOPDRWG SHEET.
DC-AAT 400V UNIDIRECTIONAL CONVERTER (PACKAGE BY OTHERS)	DEVICE ABBREVIATION
PANELS TYPE (BY OTHERS)	SHEET No

Rev. No.	Date	Description	Appr.
00	30-8-2025	FOR REVIEW AND APPROVAL	C
01	06-10-2025	FOR REVIEW AND APPROVAL	B
02	04-11-2025	FOR REVIEW AND APPROVAL	B
03	04-02-2026	FINAL REVISION	
--	--	--	--
--	--	--	--
--	--	--	--

Consultant
Contractor
Hail Company
ITS Contractor
TRAFFIC TECH
Project:
القدية Qiddiya

Job title: Road Access To Resort Core


Drawing title: SHOPDRAWING OF TRAFFIC SIGNAL SYSTEM FOR JUNCTION-1

Sheet number: SHEET 1 / 18

Scale: 1:1000 @ A0

Drawn: M.Elsayed | Checked: M.Abuzaid
Designed: | Approved:

Drawing number: QRXM114000-HFC-DRW-SDW-ITS-02-R05-00015 | Revision 03

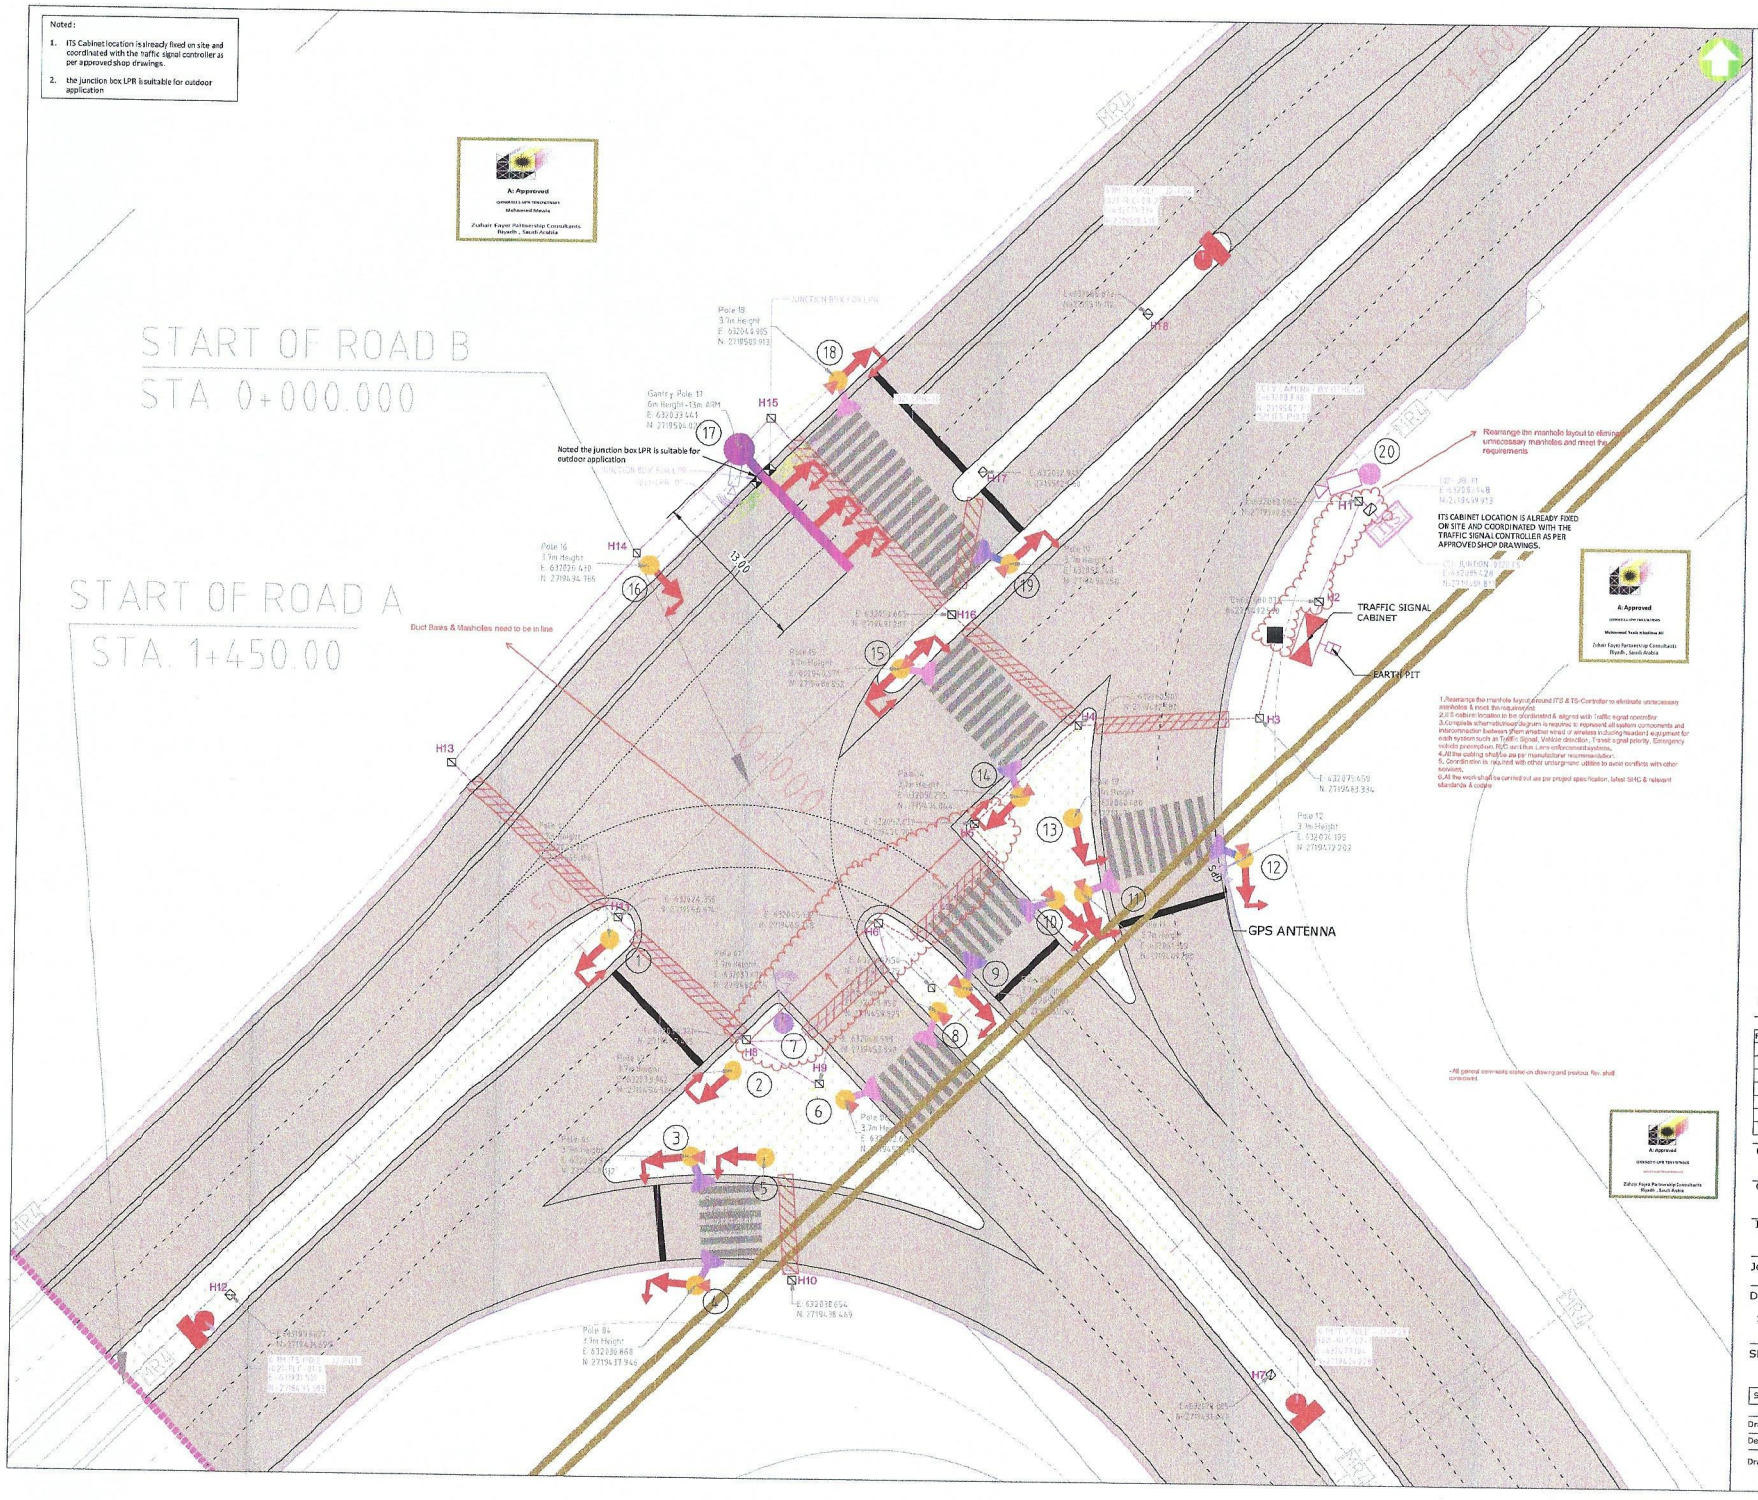

القدية
Qiddiya

Consultant's Information

HEAD OFFICE - Riyadh
6283 King Abdul Aziz Rd, Ar Rabi
Riyadh 13316 2771, Saudi Arabia
Tel.: +966 11 4048484
Fax : +966 11 4048400
Website : www.zfp.com
Email.: zfpr@zfp.com

Zuhair Fayez Partnership

Notes:
1. ALL DIMENSIONS ARE IN MILLIMETER UNLESS OTHERWISE STATED.
2. ALL LEVELS ARE IN METERS UNLESS NOTED OTHERWISE.
3. THIS DRAWINGS IS TO BE READ IN CONJUNCTION WITH ALL RELEVANT ARCHITECTURAL, STRUCTURAL AND SERVICES DRAWINGS.

REFERENCE I.F.C DESIGN DRAWING NO:
1. QRXP117115-DAH-VORA2R-DWG-ITS-R3-Z00000-2000002
2. QRXP117115-DAH-VORA2R-DWG-ITS-R3-Z00000-5000001
3. QRXP117115-DAH-VORA2R-DWG-ITS-R3-Z00000-5000002
4. QRXP117115-DAH-VORA2R-DWG-ITS-R3-Z00000-5000005
5. QRXP117115-DAH-VORA2R-DWG-ITS-R3-Z00000-5000006
6. QRXP117115-DAH-VORA2R-DWG-ITS-R3-Z00000-6000001
7. QRXP117115-DAH-VORA2R-DWG-ITS-R3-Z00000-6000002
8. QRXP117115-DAH-VORA2R-DWG-ICT-R3-Z00000-2000000

LEGEND:

Rev. No.	Date	Description	Appr.
00	30-8-2025	FOR REVIEW AND APPROVAL	C
01	04-11-2025	FOR REVIEW AND APPROVAL	B
02	04-02-2026	FINAL REVISION	--
--	--	--	--
--	--	--	--
--	--	--	--
--	--	--	--

Consultant

Contractor
Hail Company

ITS Contractor
TRAFFIC TECH

Project:
القدية Qiddiya

Job title: Road Access To Resort Core

Drawing title: SHOPDRAWING OF TRAFFIC SIGNAL SYSTEM FOR JUNCTION-2


Sheet number: SHEET 1 / 19

Scale:1:1000 @ A0

Drawn: M.Elsayed | Checked: M.Abuzaid

Designed: | Approved:

Drawing number: QRXM114000-HFC-DRW-SDW-ITS-02-R05-00024 | Revision 02

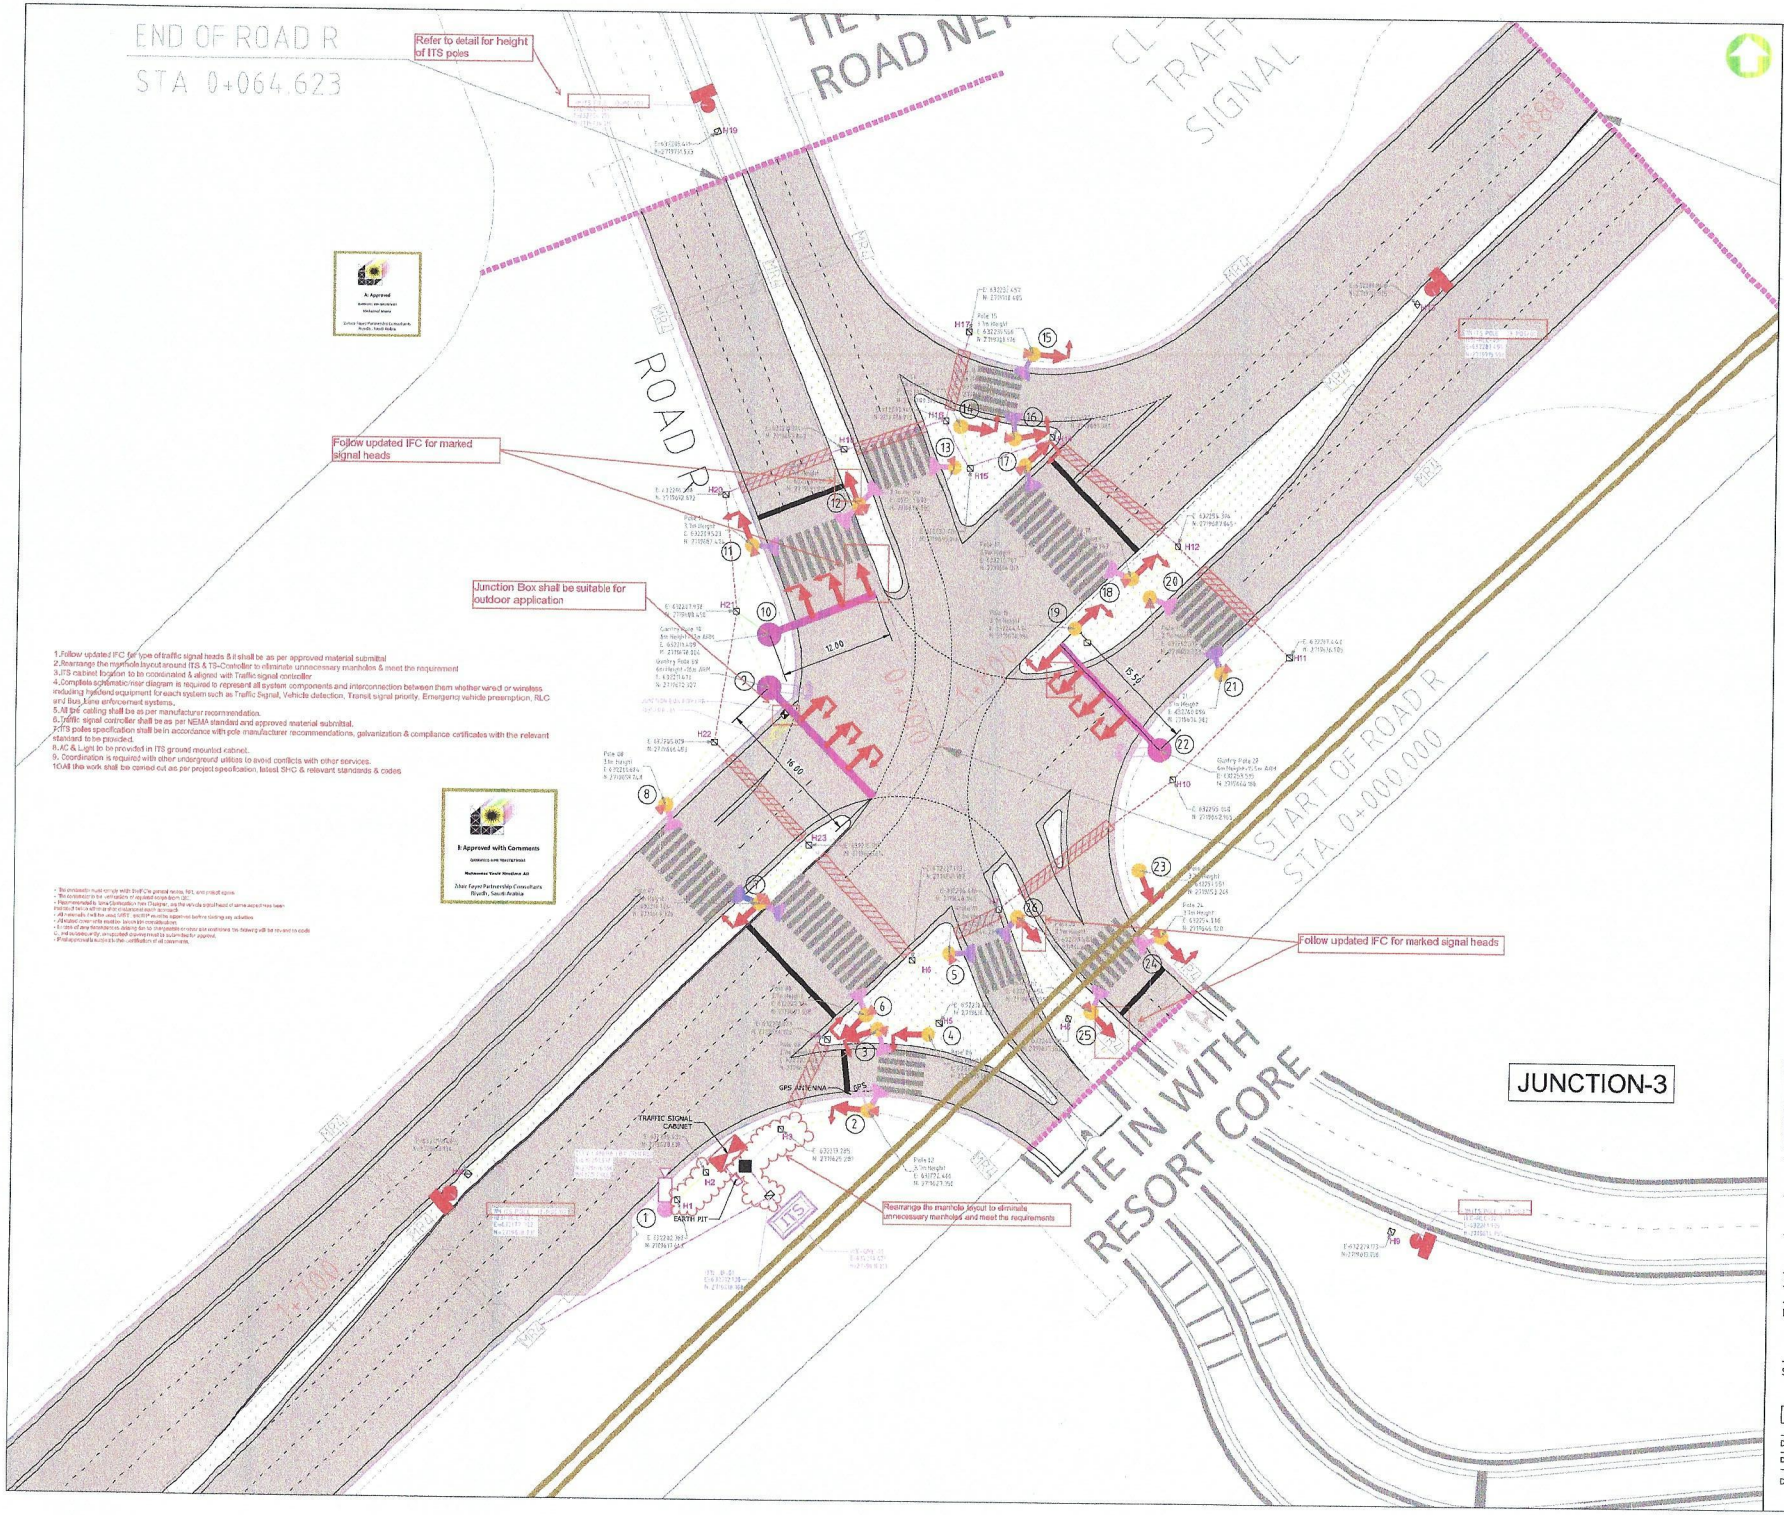

القدية
Qiddiya

Consultant's information

HEAD OFFICE - Riyadh
6283 King Abdul Aziz Rd, Ar Rabi
Riyadh 13316 2771, Saudi Arabia
Tel.: +966 11 4048484
Fax : +966 11 4048400
Website : www.zfp.com
Email.: zfpr@zfp.com

Zuhair Fayez Partnership

Notes:
1. ALL DIMENSIONS ARE IN MILLIMETER UNLESS OTHERWISE STATED.
2. ALL LEVELS ARE IN METERS UNLESS NOTED OTHERWISE.
3. THIS DRAWINGS IS TO BE READ IN CONJUCTION WITH ALL RELEVANT ARCHITECTURAL, STRUCTURAL AND SERVICES DRAWINGS.

REFERENCE I.F.C DESIGN DRAWING NO:
1. QRXP117115-DAH-VORA2R-DWG-ITS-R3-Z00000-2000003
2. QRXP117115-DAH-VORA2R-DWG-ITS-R3-Z00000-5000001
3. QRXP117115-DAH-VORA2R-DWG-ITS-R3-Z00000-5000002
4. QRXP117115-DAH-VORA2R-DWG-ITS-R3-Z00000-5000005
5. QRXP117115-DAH-VORA2R-DWG-ITS-R3-Z00000-5000006
6. QRXP117115-DAH-VORA2R-DWG-ITS-R3-Z00000-6000001
7. QRXP117115-DAH-VORA2R-DWG-ITS-R3-Z00000-6000002
8. QRXP117115-DAH-VORA2R-DWG-ICT-R3-Z00000-2000000

LEGEND:

Rev. No.	Date	Description	Appr.
00	31-8-2025	FOR REVIEW AND APPROVAL	c
01	08-11-2025	FOR REVIEW AND APPROVAL	
--	--	--	--
--	--	--	--
--	--	--	--
--	--	--	--
--	--	--	--

Consultant
Contractor
Hail Company
ITS Contractor
TRAFFIC TECH
Project:
القدية Qiddiya

Job title: Road Access To Resort Core

Drawing title: SHOPDRAWING OF TRAFFIC SIGNAL SYSTEM FOR JUNCTION-3

Sheet number: SHEET 1 / 20

Scale: 1:1000 @ A0

Drawn: M.Sayed	Checked: M.Sayed
Designed:	Approved:

Drawing number: QRXM114000-HFC-DRW-SDW-ITS-02-RO5-00033

Revision 01

Client:	Consultant:	Contractor:
Qiddiya	Zuhair Fayez Partnership	Haif Company / Freyssinet — HAIF-FREYSSINET JV

REQUEST FOR INFORMATION

Project: Package 3 - Interim Road Access to Resort Core	**Date: 26/02/2026**
	Ref. No: QRXM114000-HFC-TEC-RFI-ITS-02-RO5-00017
Location: RA2RC – Qiddiya Junction 01, 02, and 03	**Rev. No: 01**

Department: ☐ Architectural ☐ Structural ☐ Electrical ☐ Mechanical ☑ Others (ITS)

Location of Query:	RA2RC with Junction Area
Drawing Reference:	QRXP117115-DAH-VORA2R-DWG-ITS-R3-Z00000-2000001, 2000003, 2000003
Title :	TRAFFIC SIGNAL DESIGN AND ITS SYSTEM

Traffic Tech Response (25/01/2026)

Reference to the RFI: QRXM114000-HFC-TEC-RFI-ITS-02-RO5-00017, Revision00

With reference to the designer's comments on our proposed TraffiCam AI Video Detection Camera, please find below my detailed explanations for responding to the RFI comments:

- The proposed approach-based FLIR TraffiCam AI cameras are intended as the primary solution for vehicle video detection, replacing physical inductive loop detectors installed in asphalt. Each camera is dedicated to a single approach, providing improved vehicle recognition, a clear and focused field of view, and accurate vehicle presence and queue detection. The system closely replicates inductive loop detector functionality, including lane-level presence detection, call extension, and gap detection, enabling reliable traffic signal controller operation. In comparison, 360-degree wide-angle cameras are subject to image distortion—particularly at the periphery—resulting in reduced detection accuracy.

- Approach-wise video detection cameras offer superior performance under challenging site and environmental conditions, including low-light operation, headlight glare, rain, fog, and dusty environments. Wide-angle / 360-degree cameras often experience reduced detection accuracy due to scene over-compression and increased obstruction from junction elements. From a reliability perspective, failure of a single approach camera affects only the corresponding approach, whereas failure of a single 360-degree camera results in loss of detection for the entire junction.

- Approach-wise cameras enable independent detection for each lane and turning movement (left, through, and right), allowing precise signal actuation and improved junction performance. A single 360-degree camera may struggle to differentiate overlapping traffic movements during peak conditions. Detection zones for approach-based cameras are simpler to configure and fine-tune per approach, and any changes to lane geometry or road markings can be implemented locally without impacting the full junction. The solution is scalable, allowing additional lanes or approaches to be covered by adding or upgrading individual cameras, whereas a single 360-degree camera has limited scalability and higher obstruction constraints.

Client:	Consultant:	Contractor:
Qiddiya	Zuhair Fayez Partnership	Haif Company / Freyssinet / HAIF-FREYSSINET JV

Submitted by: Faraj Abu-Zaid	Signature:	Date: 26 / 02 /2026
Reviewed by: Khamis Yousef	Signature:	Date: 26 / 02 /2026
Below portion for Consultant Supervision use only		
Reply:		
☐ Architect	☐ Structural Eng.	☐ Electrical Eng. ☐ Mechanical Eng.
Engineer Name:	Signature:	Date: / /
Project Manager:	Signature:	Date: / /

DAR\Design Reply (01/03/2026):
Reference to RFI# QRXM114000-HFC-TEC-RFI-ITS-02-RO5-00017, Revision 01

-Based on latest direction from QIC, 360-degree camera for video detection is not recommended.

-Please proceed with installing standard video camera for each approach for vehicular detection.

Client:	Consultant:	Contractor:
Qiddiya	Zuhair Fayez Partnership	Haif Company / Freyssinet — HAIF-FREYSSINET JV

Submitted by: Faraj Abu-Zaid	Signature:		Date: 13 / 01 /2026
Reviewed by: Khamis Yousef	Signature:		Date: 13 / 01 /2026
Below portion for Consultant Supervision use only			
Reply:			
☐ Architect	☐ Structural Eng.	☐ Electrical Eng.	☐ Mechanical Eng.
Engineer Name:	Signature:	Date: / /	
Project Manager:	Signature:	Date: / /	

DAR/Designer Reply (19/01/2026):

Reference to the RFI: QRXM114000-HFC-TEC-RFI-ITS-02-RO5-00017, Revision00

Video Detection for Junctions #1, #2, and #3 – The proposed video detection system utilizes the latest generation of video camera technology. The recommended solution is a 360-degree fisheye video camera capable of providing full intersection coverage from a single mounting location. For larger intersections (Junctions #2 and #3), two fisheye cameras are proposed to ensure complete coverage. Given the wide field of view and detection capabilities of these cameras, individual cameras per approach are not required. (Refer to the attached vendor information for representative products; multiple manufacturers offer comparable camera solutions.)

The Contractor shall verify the availability of the proposed fisheye video detection cameras within the KSA market. If the specified camera type is not available, the Contractor shall submit formal written documentation identifying the availability constraints and proposed alternatives.

Subject to review and approval of the Contractor's documentation by the Engineer, the Contractor shall submit a Request for Information (RFI) if video detection per approach is proposed in lieu of the 360-degree camera configuration.

- Follow Dar Designer Reply.

Ashraf Mohamed

Miovision SmartView 360 Hardware Specifications



The Miovision SmartView 360 is a camera that is used to capture video at your intersection. Designed to operate in all weather conditions, the SmartView 360 is equipped with a 4K 12MP 360° lens with a 180° field of view delivers high-resolution video streams to your Miovision Core DCM so you can remotely manage and analyze your intersections. SmartView 360 utilizes a low power lens heater to keep the lens clear of ice/frost.

Contents

Kit contents	1 x Miovision SmartView 360 Camera, Camera Bell and installation accessories (weatherproof coupler, Torx bit, 3 x RJ45 connectors)
Optional items	SmartView 360 gooseneck mount with universal bracket for vertical or horizontal installations (for poles >2.375", 6.1cm)
	Universal SmartView 360 extension to add 6" to camera height

Device weight (not including cables)

Miovision® SmartView 360 Camera – Bell only	4.7 lbs (2.1 kg)
Camera with Gooseneck Mount and Universal Bracket	13.3 lbs (6.0 kg)
Camera with Gooseneck Mount, Universal Bracket and Extension	22.0 lbs (9.9 kg)

Power

Power delivery	PoE (IEEE802.3af compliant)
Power consumption	12.95 W (Class 0 device)

Operating conditions

Operating temp	-40°F to 165°F (-40°C to 74°C)
Camera Lens Heater to prevent ice/frost buildup	Thermostatically controlled Operates with standard PoE
Humidity	5% – 100% RH non-condensing
Dehumidification System	Electronic
Water and dust resistance	IP66, Type 4X(UL50), NEMA 4X compliant

Camera

Image sensor	Approximately 1/2 type 12MP CMOS image sensor
Minimum illumination	0.3 lx (0.0278709 footcandle)
Wide dynamic range	Max. 84 dB
Autofocus	Electronic motor for focusing
Tranmission type	H.264, H.265, JPEG
Resolution	Max.30 fps: 2992×2992 / 2192×2192 / 1280×1280 / 640×640 / 320×320 (fisheye mode)

Lens

Focal length	1.4 mm (1/16 inches)
Angular field of view	Horizontal : 183° Vertical : 183°
Maximum aperture ratio	1 : 1.9
Zoom	Digital (electronic)
Focus range	19 11/16 inches (0.5 m) – infinity

Network

Network Interface	10Base-T / 100Base-TX, RJ45 connector

General

Mounting method	Pole (vertical) and mast arm (horizontal), 3/4" (19 mm) banding
Safety	UL (UL62368-1), c-UL (CSA C22.2 No.62368-1), CE, IEC62368-1
EMC	FCC (Part15 ClassA), ICES003 ClassA, EN55032 ClassB, EN55024, EN55035, ECE-R10, EN50498 compliant, EN50121
Shock resistance	50J (IEC 60068-2-75 compliant), IK10 (IEC 62262), NEMA 2.2.9 Compliant (10g pulse)
Finish	Main body: Aluminum die cast Outer fixing screws: Stainless steel (Corrosion-resistant treatment) Dome section: Clear polycarbonate resin