QIDDIYA DEVELOPMENT COMPANY					
DOCUMENT NUMBER:	QDC-ADM-TEM-QMS-00004	REVISION NUMBER:	OD	ISSUED BY:	PMO
DOCUMENT TITLE	WIR FORM	DOCUMENT TYPE:	FORM	DATE ISSUED:	MAY-08-2022

WORK INSPECTION REQUEST (WIR) FORM

Contractor:	HAIF-FREYSSINET JV
Project:	RA2RC
Contract No.:	QPMO-410-CT-00618
Work Inspection Request Number:	QRXM114000-HFC-TEC-WIR-ITS-02-RO5-00098

HAIF-FREYSSINET JV

Discipline

Architecture	☐	Mechanical	☐	Information Technology	☑	Quality	☐	Project Controls	☐
Civil / Structural	☐	Electrical	☐	Landscape	☐	Safety	☐	Construction Management	☐
Other	☐								

WORK DESCRIPTION

Inspection / Test Location:	INTERIM ROAD Sta. (Red Light Camera)		
GIS/GPS GeoTag Coordinates (If applicable)			
Inspection Date:	07-Sep-2026	Inspection Start Time:	10:00 am
ITP:	QRXM114000-HFC-TEC-ITP-ITS-02-RO5-00003	Checklist:	HFC-CKL-6003
Spec's / Dwg. Ref.:	QRXM114000-HFC-DRW-SDW-ITS-02-RO5-00026 -033	Approved Method Statement Number:	QRXM114000-HFC-TEC-MST-ITS-02-RO5-00001
Attachments:	☑ Drawings ☐ Data Sheets ☐ TQs/RFI ☐ OTHER		

DESCRITPTION OF WORK

Inspection request for Installation of ITS Red Light Camera 6.1m.Pole with Accessories(7 Pcs.) at Junction-2 (03 No,s) and Junction-3 (04 No,s),
at Access to Resort core interim Road. As per attached drawing.

CONTRACTOR - QUALITY INSPECTOR - INITIAL INSPECTION FINDINGS:

Complies with Approved ITPs/Checklists?	◉ YES ○ NO ○ NA	REMARKS	
All Strucutral Embedded Items Cleared?	○ YES ○ NO ○ NA	WIR Number	
Embedded Electrical items Cleared by Electrical QC?	○ YES ○ NO ○ NA	WIR Number	
Embedded Mechanical Items Cleared by Mechanical QC?	○ YES ○ NO ○ NA	WIR Number	

Accepted:	◉
Accepted with Comments (See Remarks):	○
Rejected (See Remarks):	○

REMARKS:					
Name:	Moataz Elkhateeb	Signature:		Date:	07-09-2026

QIDDIYA / SUPERVISION CONSULTANT QC INSPECTOR - FINAL INSPECTION FINDINGS:

Contractor Has complied with Project spec requirements?	☑ YES ○ NO	Okay to Proceed with next activity?	☑ YES ○ NO ○ NA

Accepted:	☑
Accepted with Comments (See Remarks):	☑
Rejected (See Remarks):	○

REMARKS:	QIC Confirms that the above activity was inspected, witnessed, and or approved by the former CSC (ZHP). all associated responsibilities, liabilities, and obligations remain solely with ZHP. Dar's role is strictly limited to documentation review & shall not constitute acceptance of any such responsibilities or liabilities. final approval is subject to successful testing & commissioning.				
Name:	Zawar Ahmad	Signature:		Date	9/9/26

FOR DETAILED MATERIAL INSPECTION STATUS, PLEASE SEE ATTACHED CHECKLIST.
CHECKLISTS THAT ARE NOT ATTACHED AND SIGNED BY SUPERVISION CONSULTANT WILL VOID THIS INSPECTION REQUEST.

This document is the property of Qiddiya Development Company, 2022

Client:	Consultant:	Contractor:
Qiddiya	Zuhair Fayez Partnership	Hail Company / Freyssinet — HAIF-FREYSSINET JV

TECHNICAL DOCUMENTS

Project Name: Package 3 - **Interim Road Access to Resort Core**	**Project Code:** QRXM114000
Location: 00	**Date:** 17-September-2025
Document Title: **Material Approval Request FOR ITS SYSTEM SUPPLYING & INSTALLING BY TRAFFIC TECH SECURITY W.L.L Red Light Camera System**	**Ref No:** QRXM114000-HFC-TEC-MAT-ITS-02-RO5-00006
	Rev No: 00

Department: ☐ Architectural ☐ Structural ☐ Electrical ☐ Mechanical ☑ ITS ☐ Civil

Type: ☐ Pre-Qualification ☐ Method Statement ☒ Material Submittal ☐ Sample ☐ Other

Document Description: Material Approval Request FOR ITS SYSTEM SUPPLYING & INSTALLING BY TRAFFIC TECH SECURITY W.L.L Red Light Camera System

Doc. Ref. No.	Title
QRXM114000-HFC-TEC-MAT-ITS-02-RO5-00006	**Material Approval Request FOR ITS SYSTEM SUPPLYING & INSTALLING BY TRAFFIC TECH SECURITY W.L.L Red Light Camera System**

Enclosure:

Submitted By:	**Received By:**
Name: **Eng. Moataz**	Name:
Signature:	Signature:
Date: 17-Sept-2025	Date:

Below portion for Consultant Supervision use only

Status: ☐A- Approved ☐B- Approved as noted ☐C- Revise & Resubmit ☐R- For information only

Comments:

It is a conditional approval, as changes are expected in the design, specifications, and drawings of ITS system. The Contractor/Supplier must ensure proper coordination and compliance with expected changes & following comments prior to procurement. In case of any contradiction or non-compliance, this approval shall be deemed Code-C, and the Contractor/Supplier shall rectify it without any additional cost or time impact.

1.Provide references of previous projects where the Vista Pro camera has been supplied and is successfully operational.

2. Attach international certification of Vista Pro camera.

3.Provide Red light camera system storage calculation in accordance with project specification & attach data sheet for storage equipment.

4.Provide reference that the subject material has Category C1 as mentioned in the submittal.

5.Attach Riser Diagram of Red light camera system.

6. Warranty certificate for five years from the satisfactory completion of the experimental period to be provided in accordance with project specification

B: Approved with Comments
Muhammad Yasir Khadima Ali
Zuhair Fayez Partnership Consultants
Riyadh , Saudi Arabia

B: Approved with Comments
Saud Nawab
Zuhair Fayez Partnership Consultants
Riyadh , Saudi Arabia

Below portion for Client use only

Comments:

B: Approved with Comments
Zuhair Fayez Partnership Consultants
Riyadh , Saudi Arabia

Signed by: Signature: Date:

QIDDIYA DEVELOPMENT COMPANY

DOCUMENT NUMBER:	QDC-XXX-TEN-QAS-00007	REVISION NUMBER:	03	ISSUED BY:	HHG
DOCUMENT TITLE:	MIR FORM	DOCUMENT TYPE:	FORM	DATE ISSUED:	NOV-08-2023

Qiddiya

MATERIAL INSPECTION REQUEST (MIR) FORM

Contractor:	HAIF COMPANY
Project:	QPWD-410-CT-00618- ROAD ACCESS TO RESORT CORE
Contract No.:	QI0043311-WO-0004
Material Inspection Request Number:	QRXM114000-HFC-TEC-MIR-ITS-02-RO5-00005

HAIF-FREYSSINET JV

Discipline

Architecture	☐	Mechanical	☐	Information Technology	☐	Quality	☐	Project Controls	☐
Civil/Structural	☑	Electrical	☐	Landscape	☐	Safety	☐	Construction Management	☐
Other	☐								

MATERIAL DESCRIPTION

Inspection / Test Location:	INTERIM ROAD MAIN LINE-02		
Material Name:	ITS SYSTEMS RED LIGHT CAMERA, TRANSIT SIGNALS	Quantity:	20 Pcs.
P.O Number		Delivery Note Number:	TTS-HAIF- DN-0016,0017
Approved Material Transmittal Number: (Receive document Approval)		Approval Date:	
Inspection Date:	12 - 02 -2026	Inspection Start Time:	10:00 AM
ITP:		Checklist:	
Spec's / Dwg. Ref.:	TRAFFIC TECH SECURITY W.L.L	Approved Method Statement Number:	
Attachments:	Test Certificate: ◉ Yes ○ No IPC / Shop Drawings: ○ Yes ◉ No		

DESCRIPTION OF MATERIAL

Red Light Camera With Accesories (05 Pcs.) IR Strobe,48 LED (850nm,NIR) 20 Degree With Accesories (10 Pcs.),Transit Signal Priority System with Accessories For J1(01 Pcs.) Emergency Vehicle Preemption (EVP) System With Accessories For J1(04 Pcs. or Interim Road Main Line-02

CONTRACTOR - QUALITY INSPECTOR - INITIAL INSPECTION FINDINGS:

Are Complete Details Mentioned in P.O and Delivery Note?	◉ YES	○ NO	REMARKS	
Complies with Approved ITPs/Checklists?	◉ YES	○ NO	REMARKS	
Signs of Physical Damage?	○ YES	◉ NO	REMARKS	
Conforms to Approved Material Submittal?	○ YES	○ NO	REMARKS	

Accepted:	◉
Accepted with Comments:	○
Rejected (See Remarks):	○

REMARKS:					
Name:	Moataz Elkhateeb	Signature:		Date:	12-02-2026

QIDDIYA / SUPERVISION CONSULTANT QC INSPECTOR - FINAL INSPECTION FINI

Contractor Has complied with Material requirements?	○ YES	○ NO	y? ○ YES ○ NO ○ NA
Accepted:			○
Accepted with Comments:			✓
Rejected (See Remarks):			○

REMARKS: 1) Final approval is subject to the acceptance of succesful completion of Testing and commissioning.

Name:		Signature:	Date:

FOR DETAILED MATERIAL INSPECTION STATUS, PLEASE SEE ATTACHED CHECKLIST.
CHECKLISTS THAT ARE NOT ATTACHED AND SIGNED BY SUPERVISION CONSULTANT WILL VOID THIS INSPECTION REQUEST.

This document is the property of Qiddiya Development Company, 2022

(2) Comply with the comments mentioned in attached supporting documents.
(3) Attach approved ITP.

Client:	Consultant:	Contractor:
Qiddiya	Zuhair Fayez Partnership	Haif Company / Freyssinet — HAIF-FREYSSINET JV

TECHNICAL DOCUMENTS

Project Name: Package 3 - Interim Road Access to Resort Core	**Project Code:** QRXM114000
Location: 00	**Date:** 08-April-2026
Document Title: **Inspection & Test Plan for Red Light Camera Installation and Operation**	**Ref No:** QRXM114000-HFC-TEC-ITP-ITS-02-RO5-00003
	Rev No: 00

Department: ☐ Architectural ☐ Structural ☐ Electrical ☐ Mechanical ☐ Authority ☒ ITS

Type: ☐ Pre-Qualification ☐ Method Statement ☐ Material Submittal ☐ Sample ☒ ITP

Document Description: This is Inspection & Test Plan for Red Light Camera Installation and Operation

Doc. Ref. No.	Title
QRXM114000-HFC-TEC-ITP-ITS-02-RO5-00003	**Inspection & Test Plan for Red Light Camera Installation and Operation**

Enclosure:

Submitted By:	**Received By:**
Name: Eng. Moataz Signature: Date: 08-Apr-2026	Name: Signature:

Below portion for Consultant Supervision use only

Status: ☐A- Approved ☐B- Approved as noted ☐C- Revise & Resubmit ☐R- For information only

Comments: All the work shall be carried out in accordance with project specification and applcable standards & codes.







Below portion for Client use only

Comments:

Signed by: Signature: Date:

HAIF-FSA JV Inspection & Test Plan						I &TP	APPROVED DATE	DISCIPLINE
Intelligent Transportation System Works for RED LIGHT CAMERA INSTALLATION AND OPERATION						HFC-ITP-0060		ITS
PROJECT TITLE:WBS Access Road To Resort Core (RA2RC)						CONTRACTOR/SUBCONTRACTOR		
WIR No.						CONSTRUCTION- Intelligent Transportation System Works for INSTALLATION AND OPERATION of RED LIGHT CAMERA		HAIF

ITEM NO.	PROJECT PHASE	TASK / ACTIVITY	Quality Requirements /references/ specifications	Quality Record	INSPECTION RESPONSIBILITY ASSIGNMENTS		REMARKS
					Contractor	Consultant	
1.0 DOCUMENT REVIEW							
1		Material Approval & Shop Drawing	QRXM114000-HFC-TEC-MAT-ITS-02-RO5-00005 QRXM114000-HFC-DRW-SDW-ITS-02-RO5-00001-00086	QRXM114000-HFC-TEC-MAT-ITS-02-RO5-00005 QRXM114000-HFC-DRW-SDW-ITS-02-RO5-00001-00086	R	H	
2.0 MATERIAL RECEIVING INSPECTION							
2		Material receiving inspection, protection & storage	QD0002-ADM-TEM-QMS00007[0A] MaterialReceiving Inspection in site HFC-CKL-4001	QD0002-ADM-TEM-QMS00007[0A] MaterialReceivingInspection in siteHFC-CKL-4001	H	H	MIR to be submitted
3.0 WORK INSTALLATION							
3.1		PRE - INSTALLATION	HFC-CKL-6002	HFC-CKL-6002	H	H	
3.2		INSTALLATION	HFC-CKL-6003	HFC-CKL-6003	H	H	
3.3		TESTING	HFC-CKL-6004	HFC-CKL-6004	H	H	

GENERAL NOTES

1	Surveillance: QA/QC organization to monitor work in progress without notice from Construction Organization
2	Witness: QA/QC organization shall be notified of the timing of inspection or test in advance. However, the inspection or test shall be performed as scheduled if the QA/QC organization representative is not present.
3	Hold: QA/QC organization shall be notified of the timing of inspection or test in advance. Inspection or test shall not be carried out without the QA/QC organization representative in attendance.
4	If the Main Contractor delegates the assigned responsibility to the Subcontractor, then the Main Contractor will have the same degree of responsibility as assigned to Consultant.

LEGEND

H	Hold Point for QC Inspection/ Test	R	Review of Documents
W	Witness Inspection/T	RH	Review & approval of Documents
S	Surveillance		

Checklist : HFC-CKL-6003	Checklist	APPROVED DATE	DISCIPLINE
INSTALLATION OF RED LIGHT CAMERA	HFC-CKL-6003		ITS
PROJECT TITLE: Road Acess To Resort Core (RA2RC)	WBS	CONTRACTOR/SUBCONTRACTOR	
WIR No.	CONSTRUCTION- Intelligent Transportation System Works for INSTALLATION AND OPERATION of RED LIGHT CAMERA	HAIF	


ITEM NO.	Check Points & Acceptance Criteria	Reference	Pass	Fail	Not Applicable	Re-Inspection
1.0	**INSTALLATION OF ITS DEVICES - RED LIGHT CAMERA**					
1.1	All equipment shall be firmly secured in place unless requirements of portability dictate otherwise.	Project Specification SECTION 137740 - 17 RED LIGHT CAMERA SYSTEM 3.1 / A / 1	✓			
1.2	Equipment is to be laid out properly in communication rooms in a way to reserve relevant space for maintenance activities. This space shall also account for any future expansion of the system.	Project Specification SECTION 137740 - 17 RED LIGHT CAMERA SYSTEM 3.1 / A / 2	✓			
1.3	Installation shall be performed in accordance with the applicable standards, requirements, manufacturers' guidelines and any authorities having jurisdiction.	Project Specification SECTION 137740 - 17 RED LIGHT CAMERA SYSTEM 3.1 / A / 3	✓			
1.4	All boxes, equipment, etc. shall be plumb and square.	Project Specification SECTION 137740 - 17 RED LIGHT CAMERA SYSTEM 3.1 / A / 4	✓			
1.5	The Contractor shall take such precautions that are necessary to prevent and guard against electromagnetic interference.	Project Specification SECTION 137740 - 17 RED LIGHT CAMERA SYSTEM 3.1 / A / 5	✓			
1.6	After the proper layout of all equipment is accomplished, all components are to be labeled and marked.	Project Specification SECTION 137740 - 17 RED LIGHT CAMERA SYSTEM 3.1 / A / 6	✓			
1.7	During installation, consideration shall be given to operational efficiency as well as the overall aesthetic factors.	Project Specification SECTION 137740 - 17 RED LIGHT CAMERA SYSTEM 3.1 / A / 7	✓			
1.8	The Contractor shall supply and install all fittings and accessories, whether or not specified, required for proper, safe, and reliable operation of the system.	Project Specification SECTION 137740 - 17 RED LIGHT CAMERA SYSTEM 3.1 / A / 8	✓			
1.9	The Contractor shall ensure that safe ingress and egress from all work areas are maintained during movement and installation of equipment/materials.	Project Specification SECTION 137740 - 17 RED LIGHT CAMERA SYSTEM 3.1 / A / 9	✓			
1.10	For Red Light camera structure details, refer to structural drawings for foundation details.	Project Specification SECTION 137740 - 17 RED LIGHT CAMERA SYSTEM 3.1 / A / 10	✓			
1.11	The Contractor shall install the red-light camera cameras on the support structures as per manufacturer's instructions.	Project Specification SECTION 137740 - 17 RED LIGHT CAMERA SYSTEM 3.1 / A / 11	✓			
1.12	Wiring within Enclosures: Bundle, lace, and train cables to terminal points with no excess and without exceeding manufacturer's limitations on bending radii. Provide and use lacing bars and distribution spools.	Project Specification SECTION 137740 - 17 RED LIGHT CAMERA SYSTEM 3.1 / B / 1	✓			
1.13	Install manufactured conduit sweeps and long-radius elbows whenever possible.	Project Specification SECTION 137740 - 17 RED LIGHT CAMERA SYSTEM 3.1 / B / 2	✓			
1.14	Terminate conductors; no cable shall contain un-terminated elements. Make terminations only at outlets and terminals.	Project Specification SECTION 137740 - 17 RED LIGHT CAMERA SYSTEM 3.1 / B / 3	✓			
1.15	Splices, Taps, and Terminations: Arrange on numbered terminal strips in junction, pull, and outlet boxes; terminal cabinets; and equipment enclosures. Cables may not be spliced.	Project Specification SECTION 137740 - 17 RED LIGHT CAMERA SYSTEM 3.1 / B / 4	✓			
1.16	Secure and support cables at intervals not exceeding 760 mm (30 inches) and not more than 150 mm (6 inches) from cabinets, boxes, fittings, outlets, racks, frames, and terminals.	Project Specification SECTION 137740 - 17 RED LIGHT CAMERA SYSTEM 3.1 / B / 5	✓			
1.17	Do not install bruised, kinked, scored, deformed, or abraded cable. Do not splice cable between termination, tap, or junction points. Remove and discard cable if damaged during installation and replace it with new cable.	Project Specification SECTION 137740 - 17 RED LIGHT CAMERA SYSTEM 3.1 / B / 6	✓			
1.18	Visually inspect wire and cable for faulty insulation prior to installation.	Project Specification SECTION 137740 - 17 RED LIGHT CAMERA SYSTEM 3.1 / B / 7	✓			
1.19	Protect cable ends at all times with acceptable end caps except during actual termination.	Project Specification SECTION 137740 - 17 RED LIGHT CAMERA SYSTEM 3.1 / B / 8	✓			
1.20	After installation, and before termination, all wiring and cabling shall be checked and tested to ensure there are no grounds, opens, or shorts on any conductors or shields.	Project Specification SECTION 137740 - 17 RED LIGHT CAMERA SYSTEM 3.1 / B / 9	✓			
1.21	Install LAN cables using techniques, practices, and methods that are consistent with Category 6A rating of components and fiber-optic rating of components, and that ensure Class EA and fiber-optic performance of completed and linked signal paths, end to end.	Project Specification SECTION 137740 - 18 RED LIGHT CAMERA SYSTEM 3.1 / B / 10	✓			
1.22	Install tamper switches on components indicated to receive tamper switches, arranged to detect unauthorized entry into system-component enclosures and mounted in self-protected, inconspicuous positions.	Project Specification SECTION 137740 - 18 RED LIGHT CAMERA SYSTEM 3.1 / B / 11	✓			

1.23	For units that are mounted outdoors, in damp locations, or where exposed to weather, install consistent with requirements of weatherproof rating.	Project Specification SECTION 137740 - 18 RED LIGHT CAMERA SYSTEM 3.1 / C / 1	✓		
1.24	Provide a typed schedule of all data ports according to each related room jack designation for all Telecommunications Rooms.	Project Specification SECTION 137740 - 18 RED LIGHT CAMERA SYSTEM 3.1 / D / 1	✓		
1.25	Provide labeling for all the cables terminated at the traffic signal cabinet.	Project Specification SECTION 137740 - 18 RED LIGHT CAMERA SYSTEM 3.1 / D / 2	✓		
1.26	Ground cable shields and equipment to eliminate shock hazard and to minimize ground loops, common-mode returns, noise pickup, cross talk, and other impairments.	Project Specification SECTION 137740 - 18 RED LIGHT CAMERA SYSTEM 3.1 / E / 1	✓		
1.27	Conductors: Sizes and types as recommended in writing by system manufacturer unless otherwise indicated.	Project Specification SECTION 137740 - 18 RED LIGHT CAMERA SYSTEM 3.1 / F / 1	✓		
1.28	Control and Signal Cables: Install unshielded, twisted-pair cable unless otherwise indicated or if manufacturer recommends shielded cable.	Project Specification SECTION 137740 - 18 RED LIGHT CAMERA SYSTEM 3.1 / F / 2	✓		
1.29	Identify distributors, racks, rack-mounted equipment, bonding conductors, backbone cabling subsystems, horizontal cabling subsystem, patch cables, access points and earth busbars.	Project Specification SECTION 137740 - 18 RED LIGHT CAMERA SYSTEM 3.1 / F / 3	✓		
1.30	Color-code cross-connect fields. Apply colors to voice and data service backboards, connections, covers, and labels.	Project Specification SECTION 137740 - 18 RED LIGHT CAMERA SYSTEM 3.1 / F / 4	✓		
1.31	For installations outside buildings, label cables, jointing chambers and cabinets with a unique identifier to enable tracing in both directions.	Project Specification SECTION 137740 - 18 RED LIGHT CAMERA SYSTEM 3.1 / F / 5	✓		
1.32	Labeling of optical fiber installations should be such that the polarization of duplex optical fiber connections is known and consistent throughout the installation.	Project Specification SECTION 137740 - 18 RED LIGHT CAMERA SYSTEM 3.1 / F / 6	✓		
1.33	Identification within Connector Fields in Equipment Rooms and Wiring Closets: Label each connector patch cord, and each discrete unit of cable-terminating and connecting hardware. Where similar jacks and plugs are used for both voice and data communication cabling, use a different color for jacks and plugs of each service.	Project Specification SECTION 137740 - 18 RED LIGHT CAMERA SYSTEM 3.1 / F / 7	✓		
1.34	Patch cords shall be labeled on each end specifying the source and destination of the cord.	Project Specification SECTION 137740 - 18 RED LIGHT CAMERA SYSTEM 3.1 / F / 8	✓		
1.35	Long cable runs in underground ducts shall be labeled at 50 meters intervals.	Project Specification SECTION 137740 - 18 RED LIGHT CAMERA SYSTEM 3.1 / F / 9	✓		
1.36	Labels shall be preprinted or computer-printed type with printing area and font color that contrasts with cable jacket color but still comples with requirements in ANSI/TIA-606-B and EN 50174-1.	Project Specification SECTION 137740 - 18 RED LIGHT CAMERA SYSTEM 3.1 / F / 10	✓		
1.37	Splices, Taps, and Terminations: Make connections only on numbered terminal strips in junction, pull, and outlet boxes; terminal cabinets; and equipment enclosures.	Project Specification SECTION 137740 - 18 RED LIGHT CAMERA SYSTEM 3.1 / G	✓		


Remarks

PM/Contractor			QDC		
Contractor Construction			**Third Party (if applicable)**		
The work is ready for inspection			**Document Reviewed**	**Work Inspected**	**Test Records Verified**
Name	Signature	Date	Name	Signature	
Contractor QC Inspector			QDC Supervision Consultant		


Form Ref. No. QD0002-ADM-TPI-QTY-00003–Rev.0A

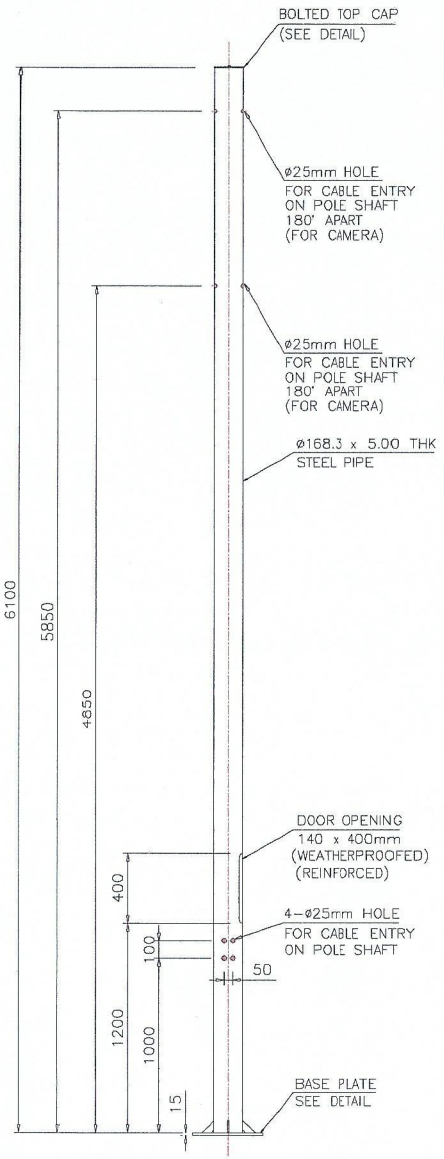


ITS POLE - 6.1M

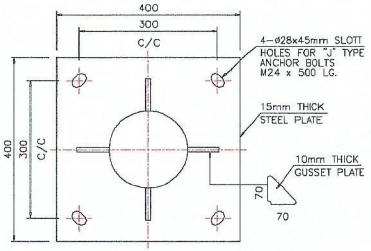

BASE PLATE DETAIL

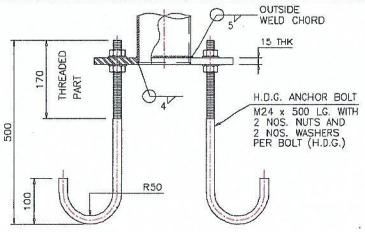


ANCHOR BOLT DETAIL

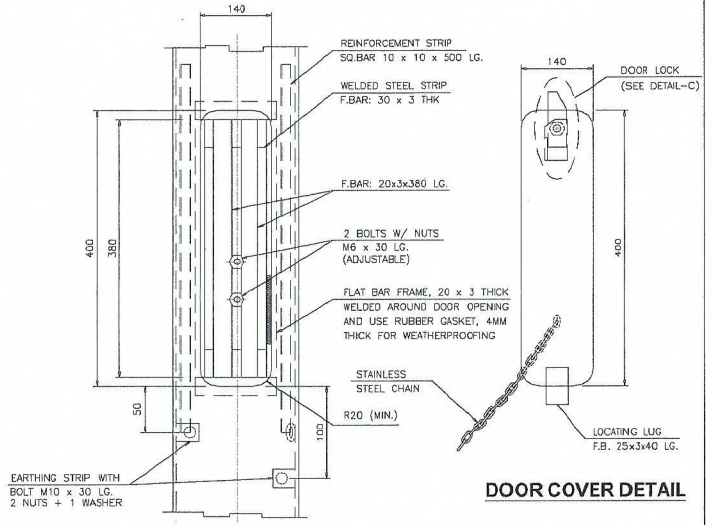


DOOR COVER DETAIL

DOOR OPENING DETAIL


1.ITS poles shall be in accordance with the pole manufacturer's recommendations.
2. Galvanization & Compliance certificates with the standards to be provided
3. For other comments refer to drawing #QRXM114000-HFC-DRW-SDW-ITS-02-R05-00015

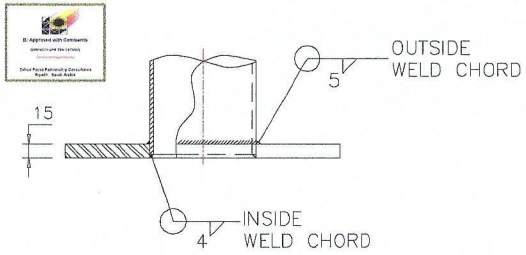

BASE PLATE/ SHAFT WELDING DETAIL

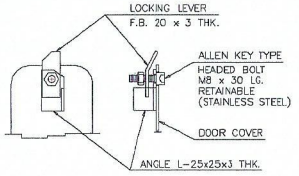

DETAIL - C (DOOR LOCK)

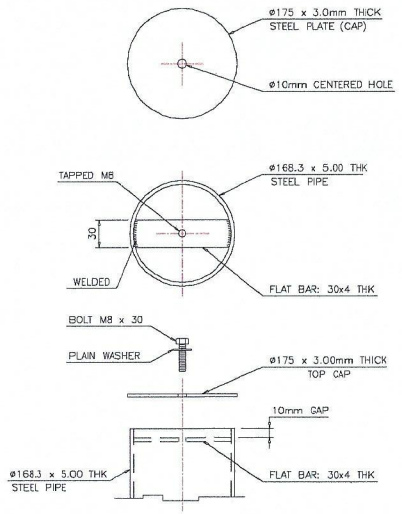

TOP CAP DETAIL

NOTES:


1. ALL DIMENSIONS ARE IN MILLIMETERS.
2. FINISH HOT DIPPED GALVANIZED IN ACCORDING TO ASTM A123.
3. MATERIAL SPECIFICATION :
   3.1 PIPE : ASTM A500 G–A OR EQUIV.
   3.2 OTHERS = ASTM A36, GRADE 36, OR EQUIV.
4. DESIGN : B.S. EN 40–3
5. DESIGN WIND SPEED : 160 KM/HR.
6. FOUNDATION DESIGN TO BE PROVIDED IN SEPARATE SUBMISSION

القدية
Qiddiya

Consultant's information

HEAD OFFICE - Riyadh
6283 King Abdul Aziz Rd, Ar Rabi
Riyadh 13316 2771, Saudi Arabia
Tel.: +966 11 4048484
Fax : +966 11 4048400
Website : www.zfp.com
Email.: zfpr@zfp.com


Zuhair Fayez Partnership

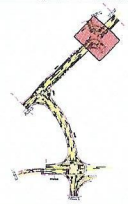

Notes:
1. ALL DIMENSIONS ARE IN MILLIMETER UNLESS OTHERWISE STATED.
2. ALL LEVELS ARE IN METERS UNLESS NOTED OTHERWISE.
3. THIS DRAWINGS IS TO BE READ IN CONJUNCTION WITH ALL RELEVANT ARCHITECTURAL, STRUCTURAL AND SERVICES DRAWINGS.

REFERENCE I.F.C DESIGN DRAWING NO:
1. QRXP117115-DAH-VOHA2R-DWG-ITS-R3-Z00000-2000003
2. QRXP117115-DAH-VOHA2R-DWG-ITS-R3-Z00000-5000001
3. QRXP117115-DAH-VOHA2R-DWG-ITS-R3-Z00000-5000002
4. QRXP117115-DAH-VOHA2R-DWG-ITS-R3-Z00000-5000005
5. QRXP117115-DAH-VOHA2R-DWG-ITS-R3-Z00000-5000006
6. QRXP117115-DAH-VOHA2R-DWG-ITS-R3-Z00000-6000001
7. QRXP117115-DAH-VOHA2R-DWG-ITS-R3-Z00000-6000002
8. QRXP117115-DAH-VOHA2R-DWG-ICT-R3-Z00000-2000000

LEGEND:

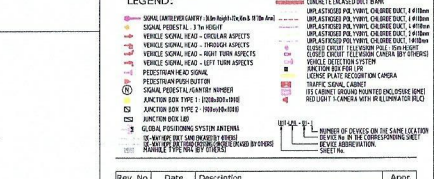

Rev. No.	Date	Description	Appr.
00	08-11-2025	FOR REVIEW AND APPROVAL	
--	--	--	--
--	--	--	--
--	--	--	--
--	--	--	--
--	--	--	--
--	--	--	--

Consultant
Contractor
Half Company
ITS Contractor
TRAFFIC TECH
Project:
القدية Qiddiya

Job title: Road Access To Resort Core

Drawing title:
SHOP DRAWING OF TRAFFIC SIGNAL SYSTEM FOR JUNCTION-3
TYPICAL ITS POLE DETAILS -
6.1M

Sheet number:
SHEET 20 / 20

Scale: NTS


Drawn: M.Sayed | Checked: M.Sayed
Designed: | Approved:

Drawing number: QRXM114000-HFC-DRW-SDW-ITS-02-R05-00076
Revision: 00


1. ITS poles shall be in accordance with the pole manufacturer's recommendations.
2. Galvanization & Compliance certificates with the standards to be provided.
3. For other comments refer to drawing #QRXM114000-HFC-DRW-SDW-ITS-02-R05-00024

B: Approved with Comments


Zuhair Fayez Partnership Consultants
Riyadh , Saudi Arabia

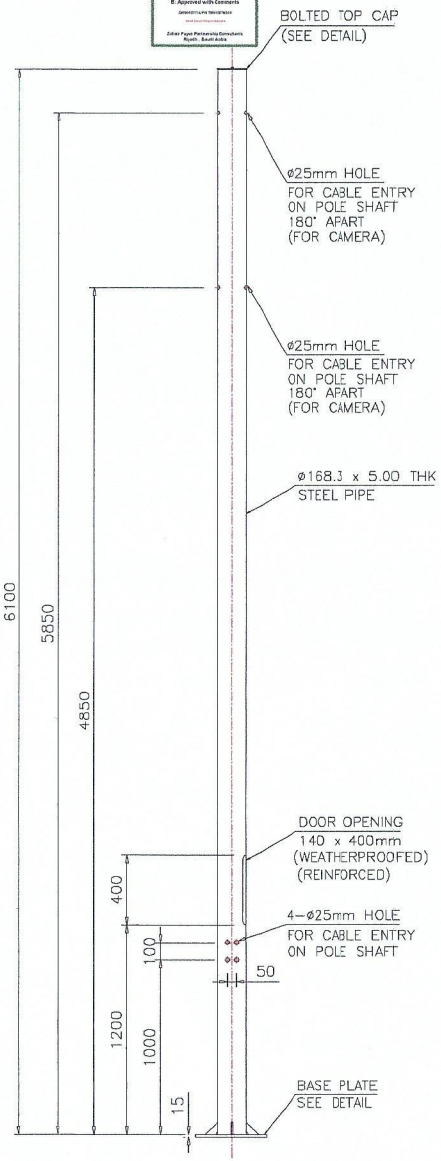


ITS POLE - 6.1M

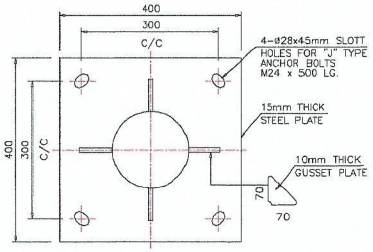

BASE PLATE DETAIL

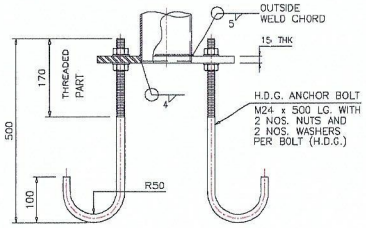


ANCHOR BOLT DETAIL

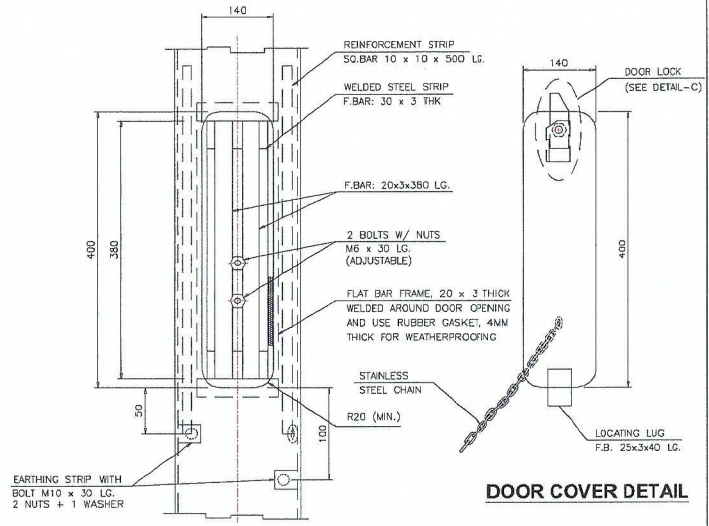


DOOR COVER DETAIL


DOOR OPENING DETAIL

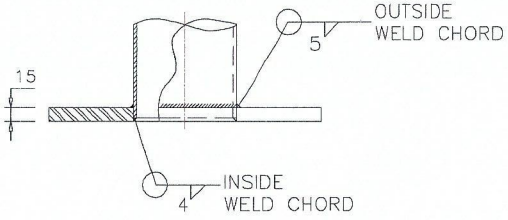

BASE PLATE/ SHAFT WELDING DETAIL

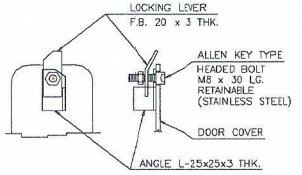

DETAIL - C (DOOR LOCK)

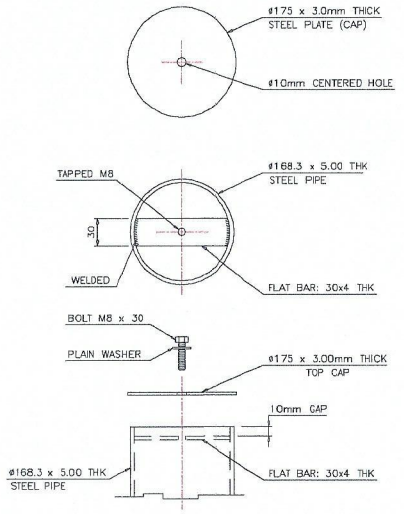

TOP CAP DETAIL

NOTES:


1. ALL DIMENSIONS ARE IN MILLIMETERS.
2. FINISH HOT DIPPED GALVANIZED IN ACCORDING TO ASTM A123.
3. MATERIAL SPECIFICATION :
   3.1 PIPE : ASTM A500 G-A OR EQUIV.
   3.2 OTHERS = ASTM A36, GRADE 36, OR EQUIV.
4. DESIGN : B.S. EN 40-3
5. DESIGN WIND SPEED : 160 KM/HR.
6. FOUNDATION DESIGN TO BE PROVIDED IN SEPARATE SUBMISSION

Qiddiya

Consultant's information

HEAD OFFICE - Riyadh
6283 King Abdul Aziz Rd, Ar Rabi
Riyadh 13316 2771, Saudi Arabia
Tel.: +966 11 4048484
Fax : +966 11 4048400
Website : www.zfp.com
Email.: zfpr@zfp.com

Zuhair Fayez Partnership

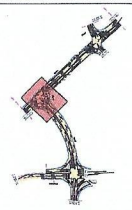

Notes:
1. ALL DIMENSIONS ARE IN MILLIMETER UNLESS OTHERWISE STATED.
2. ALL LEVELS ARE IN METERS UNLESS NOTED OTHERWISE.
3. THIS DRAWINGS IS TO BE READ IN CONJUNCTION WITH ALL RELEVANT ARCHITECTURAL, STRUCTURAL AND SERVICES DRAWINGS.

REFERENCE I.F.C DESIGN DRAWING NO:
1. QRXP117115-DAH-VORA2R-DWG-ITS-R3-Z00000-2000002
2. QRXP117115-DAH-VORA2R-DWG-ITS-R3-Z00000-5000001
3. QRXP117115-DAH-VORA2R-DWG-ITS-R3-Z00000-5000002
4. QRXP117115-DAH-VORA2R-DWG-ITS-R3-Z00000-5000005
5. QRXP117115-DAH-VORA2R-DWG-ITS-R3-Z00000-5000006
6. QRXP117115-DAH-VORA2R-DWG-ITS-R3-Z00000-6000001
7. QRXP117115-DAH-VORA2R-DWG-ITS-R3-Z00000-6000002
8. QRXP117115-DAH-VORA2R-DWG-ICT-R3-Z00000-2000000

LEGEND:



Rev. No.	Date	Description	Appr.
00	04-11-2025	FOR REVIEW AND APPROVAL	
--	--	--	--
--	--	--	--
--	--	--	--
--	--	--	--
--	--	--	--
--	--	--	--

Consultant
Contractor — Hall Company
ITS Contractor — TRAFFIC TECH

Project: Qiddiya

Job title: Road Access To Resort Core


Drawing title:
SHOPDRAWING OF TRAFFIC SIGNAL SYSTEM FOR JUNCTION-2
TYPICAL ITS POLE DETAILS - 6.1M

Sheet number: SHEET 19 / 19

Scale: NTS

Drawn: M.Sayed	Checked: M.Sayed
Designed:	Approved:

Drawing number: QRXM114000-HFC-DRW-SDW-ITS-02-R05-00066
Revision: 00

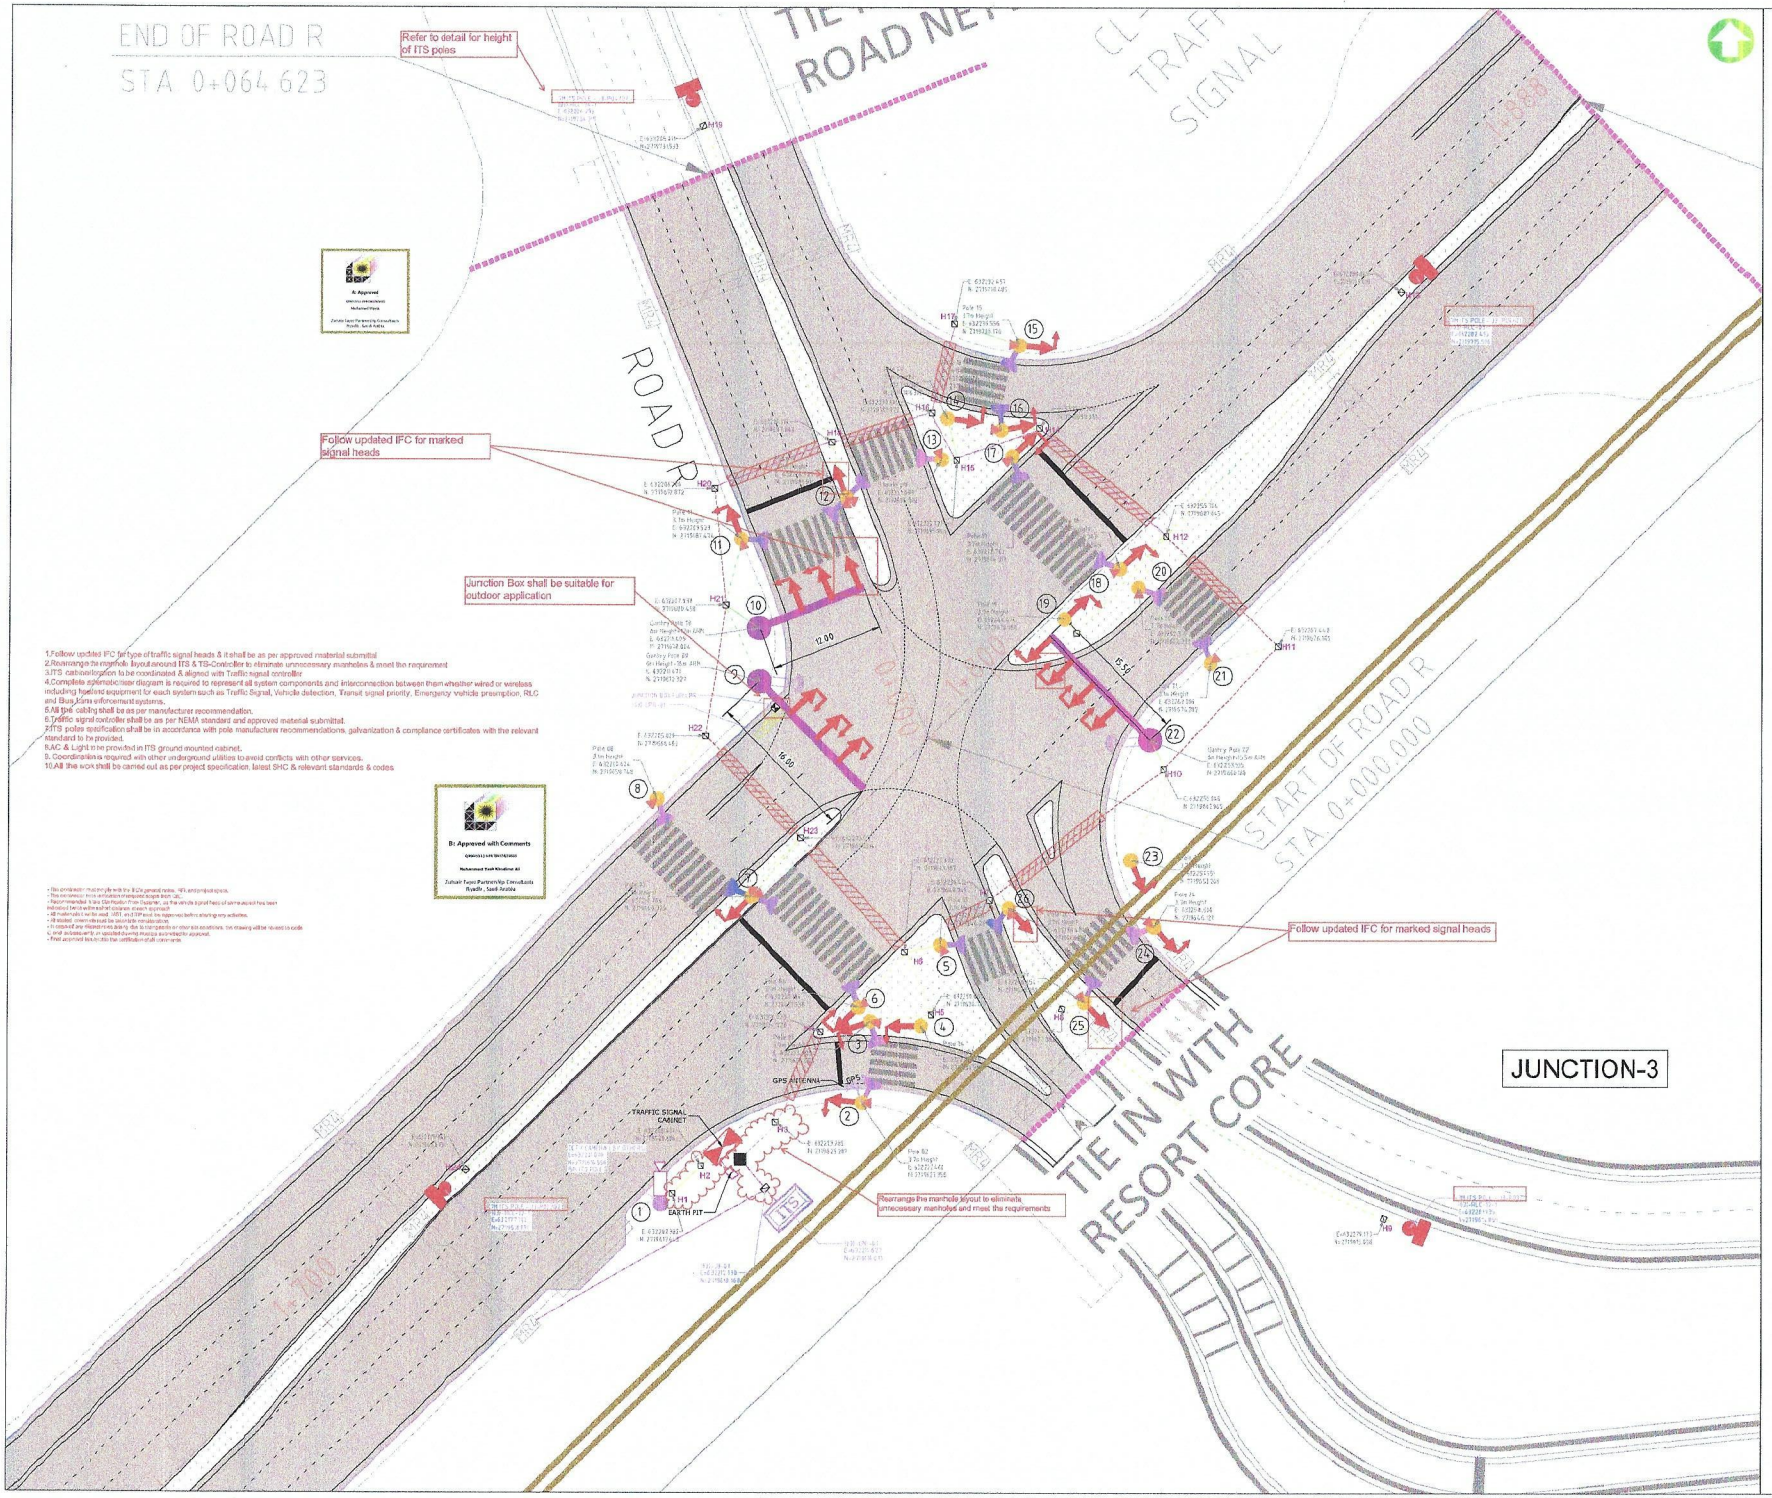


القدية
Qiddiya

Consultant's information

HEAD OFFICE - Riyadh
6283 King Abdul Aziz Rd, Ar Rabi
Riyadh 13316 2771, Saudi Arabia
Tel.: +966 11 4048484
Fax : +966 11 4048400
Website : www.zfp.com
Email.: zfpr@zfp.com

Zuhair Fayez Partnership

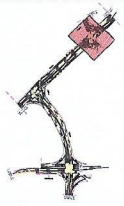

Notes:
1. ALL DIMENSIONS ARE IN MILLIMETER UNLESS OTHERWISE STATED.
2. ALL LEVELS ARE IN METERS UNLESS NOTED OTHERWISE.
3. THIS DRAWINGS IS TO BE READ IN CONJUNCTION WITH ALL RELEVANT ARCHITECTURAL, STRUCTURAL AND SERVICES DRAWINGS.

REFERENCE I.F.C DESIGN DRAWING NO:
1. QRXP117115-DAH-VOHA2R-DWG-ITS-R3-Z00000-2000003
2. QRXP117115-DAH-VOHA2R-DWG-ITS-R3-Z00000-5000001
3. QRXP117115-DAH-VOHA2R-DWG-ITS-R3-Z00000-5000002
4. QRXP117115-DAH-VOHA2R-DWG-ITS-R3-Z00000-5000005
5. QRXP117115-DAH-VOHA2R-DWG-ITS-R3-Z00000-5000006
6. QRXP117115-DAH-VOHA2R-DWG-ITS-R3-Z00000-6000001
7. QRXP117115-DAH-VOHA2R-DWG-ITS-R3-Z00000-6000002
8. QRXP117115-DAH-VOHA2R-DWG-ICT-R3-Z00000-2000000

LEGEND:

Rev. No.	Date	Description	Appr.
00	31-8-2025	FOR REVIEW AND APPROVAL	0
01	06-11-2025	FOR REVIEW AND APPROVAL	
--	--	--	--
--	--	--	--
--	--	--	--
--	--	--	--
--	--	--	--

Consultant

Project:

Contractor
Hail Company

ITS Contractor
TRAFFIC TECH

القدية
Qiddiya

Job title: Road Access To Resort Core

Drawing title: SHOPDRAWING OF TRAFFIC SIGNAL SYSTEM FOR JUNCTION-3


Sheet number: SHEET 1 / 20

Scale: 1:1000 @ A0

Drawn: M.Sayed	Checked: M.Sayed
Designed:	Approved:

Drawing number: QRXM114000-HFC-DRW-SDW-ITS-02-R05-00033

Revision: 01

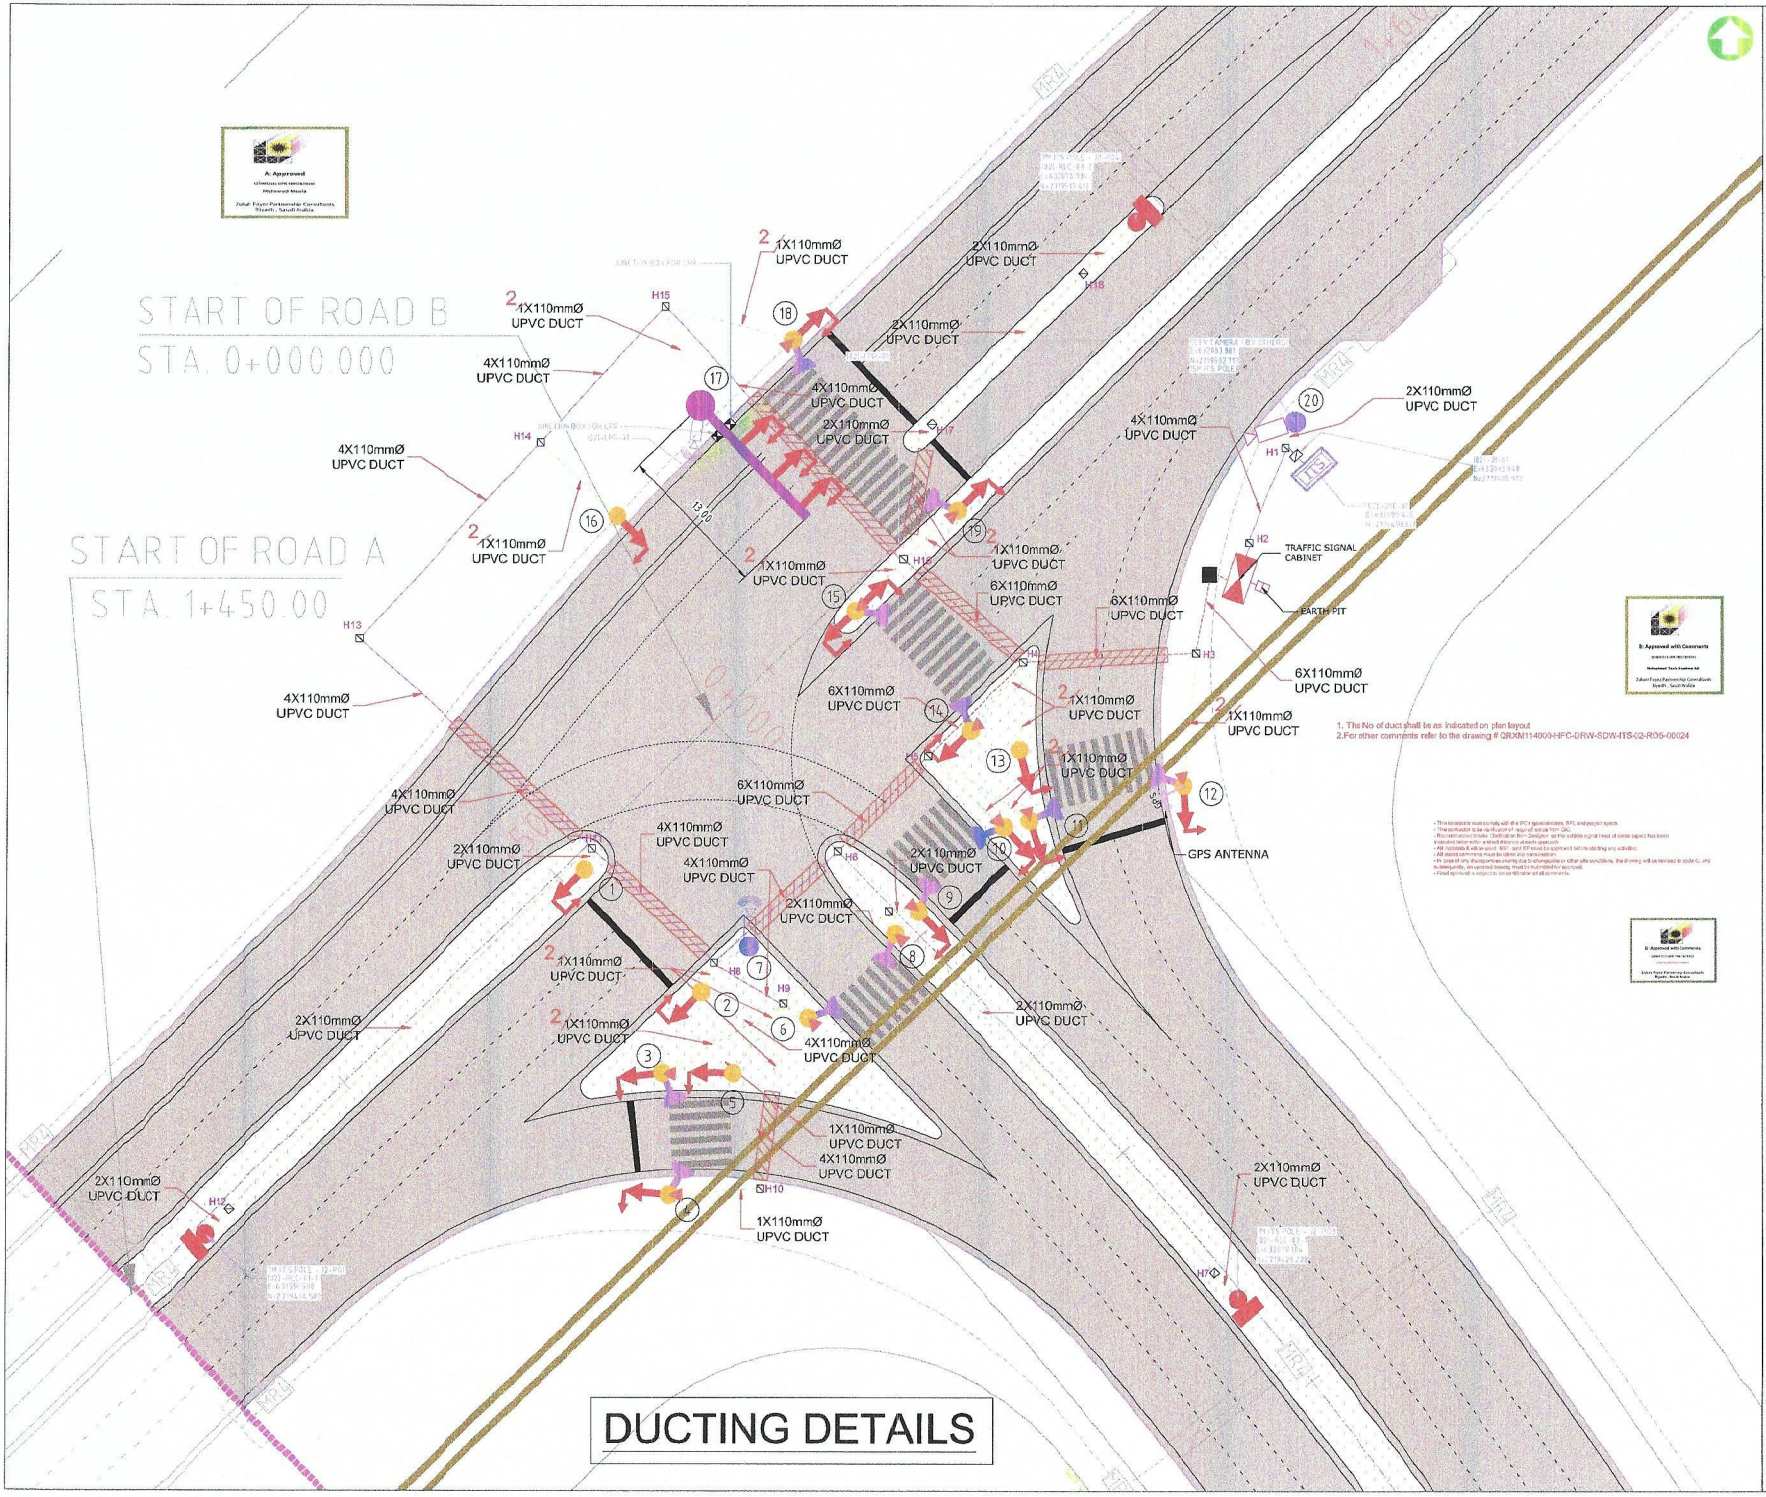

Qiddiya

Consultant's information

HEAD OFFICE - Riyadh
6283 King Abdul Aziz Rd, Ar Rabi
Riyadh 13316 2771, Saudi Arabia
Tel.: +966 11 4048484
Fax : +966 11 4048400
Website : www.zfp.com
Email.: zfpr@zfp.com

Zuhair Fayez Partnership

Notes:
1. ALL DIMENSIONS ARE IN MILLIMETER UNLESS OTHERWISE STATED.
2. ALL LEVELS ARE IN METERS UNLESS NOTED OTHERWISE.
3. THIS DRAWINGS IS TO BE READ IN CONJUNCTION WITH ALL RELEVANT ARCHITECTURAL, STRUCTURAL AND SERVICES DRAWINGS.

REFERENCE I.F.C DESIGN DRAWING NO:
1. QRXP117115-DAH-VOIA2R-DWG-ITS-R3-Z00000-2000002
2. QRXP117115-DAH-VOIA2R-DWG-ITS-R3-Z00000-5000001
3. QRXP117115-DAH-VOIA2R-DWG-ITS-R3-Z00000-5000002
4. QRXP117115-DAH-VOIA2R-DWG-ITS-R3-Z00000-5000005
5. QRXP117115-DAH-VOIA2R-DWG-ITS-R3-Z00000-5000006
6. QRXP117115-DAH-VOIA2R-DWG-ITS-R3-Z00000-6000001
7. QRXP117115-DAH-VOIA2R-DWG-ITS-R3-Z00000-6000002
8. QRXP117115-DAH-VOIA2R-DWG-ICT-R3-Z00000-2000000

LEGEND:

Rev. No.	Date	Description	Appr.
00	30-8-2025	FOR REVIEW AND APPROVAL	c
01	04-11-2025	FOR REVIEW AND APPROVAL	
---	---	---	---
---	---	---	---
---	---	---	---
---	---	---	---
---	---	---	---

Consultant
Contractor: Hail Company
ITS Contractor: TRAFFIC TECH
Project: Qiddiya

Job title: Road Access To Resort Core

Drawing title: SHOPDRAWING OF TRAFFIC SIGNAL SYSTEM FOR JUNCTION-2 DUCTING DETAILS


Sheet number: SHEET 3 / 19

Scale: 1:1000 @ A0


Drawn: M.Sayed | Checked: M.Sayed
Designed: | Approved:

Drawing number: QRXM114000-HFC-DRW-SDW-ITS-02-R05-00026 | Revision 01

LPR CAMERA

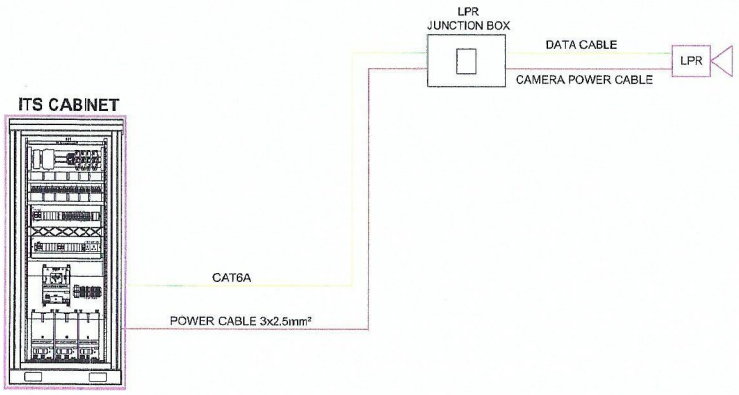


CCTV CAMERA

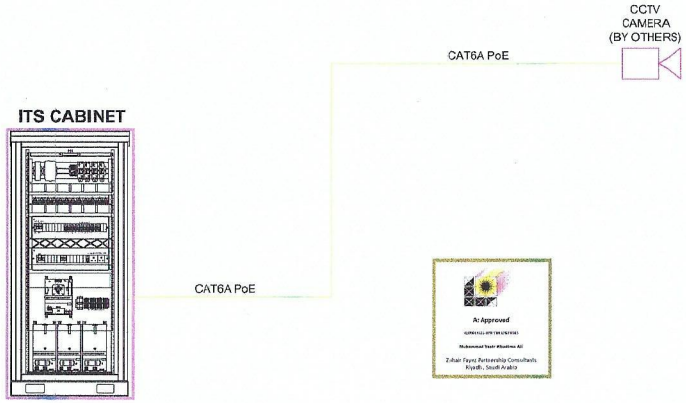

1.All the work/materials shall be in accordance with project specifications.
2.The storage size shall be sufficient to store data for the specified duration as mentioned in the project specifications.
3..The number of network switches in each ITS cabinet shall be based on the associated field device types.

RED LIGHT CAMERA

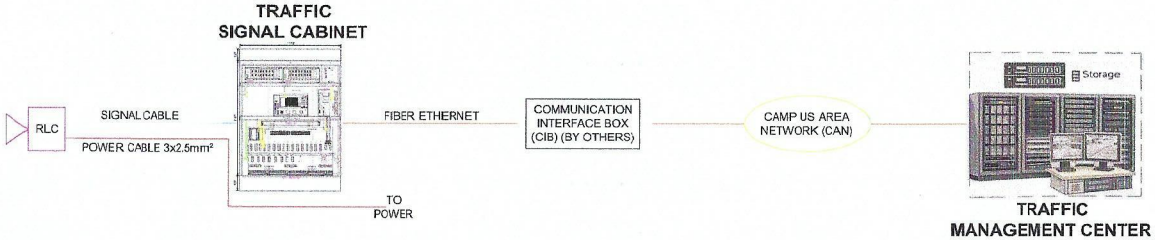

Description	Purpose / Application	Specifications	Storage Size
Server 1 (Server)	ATMS Application, Bus Lane Enforcement Application, Centrax, Red Light Enforcement Application	F6.Vess, A8120 BOX, Memory: 16GB×8, CPU: Silver 4216R×2, M.2 OS, RAID 256GB×2, Ports: 1GbE×4 + 10GbE×2, WS2022, Redundant PSU, Disks: 2×2TB 2.5" SSD	4 TB
Server 2 (Server)	Redundant / Failover Server for Server 1 Applications	F6.Vess, A8120 BOX, Memory: 16GB×8, CPU: Silver 4216R×2, M.2 OS, RAID 256GB×2, Ports: 1GbE×4 + 10GbE×2, WS2022, Redundant PSU, Disks: 2×2TB 2.5" SSD	4 TB
Server 3 (Server &Storage)	Storage Server 1 – Database Storage for 4 Applications in Server 1	F6.Vess, A8120 BOX, Memory: 16GB×8, CPU: Silver 4216R×2, M.2 OS, RAID 256GB×2, Ports: 1GbE×4 + 10GbE×2, WS2022, Redundant PSU, Disks: 4×8TB 3.5" Enterprise HDD	32 TB
Server 4 (Server &Storage)	Storage Server 2 – Backup Storage for the 4 Databases in Storage Server 1	F6.Vess, A8120 BOX, Memory: 16GB×8, CPU: Silver 4216R×2, M.2 OS, RAID 256GB×2, Ports: 1GbE×4 + 10GbE×2, WS2022, Redundant PSU, Disks: 4×8TB 3.5" Enterprise HDD	32 TB
Workstation 1	Operator / Monitoring Workstation	Small Form Factor, Intel Quad-core 3.0 GHz, 16GB DDR3, 1TB HDD, DVD/RW, USB Ports, Ethernet	01 TB
Workstation 2	Operator / Monitoring Workstation	Small Form Factor, Intel Quad-core 3.0 GHz, 16GB DDR3, 1TB HDD, DVD/RW, USB Ports, Ethernet	01 TB

SERVER, STORAGE AND WORKSTATION DETAILS

For Servers specification refer to materials submittal document QRXM114000-HFC-TEC-MAT-ITS-02-RO5-00003

Qiddiya

Consultant's information

HEAD OFFICE - Riyadh
6283 King Abdul Aziz Rd, Ar Rabi
Riyadh 13316 2771, Saudi Arabia
Tel.: +966 11 4048484
Fax : +966 11 4048400
Website : www.zfp.com
Email.: zfpr@zfp.com

Zuhair Fayez Partnership



Notes:
1. ALL DIMENSIONS ARE IN MILLIMETER UNLESS OTHERWISE STATED.
2. ALL LEVELS ARE IN METERS UNLESS NOTED OTHERWISE.
3. THIS DRAWINGS IS TO BE READ IN CONJUNCTION WITH ALL RELEVANT ARCHITECTURAL, STRUCTURAL AND SERVICES DRAWINGS.

REFERENCE I.F.C DESIGN DRAWING NO:
1. QRXP117115-DAH-VORA2R-DWG-ITS-R3-ZD00E0-2000003
2. QRXP117115-DAH-VORA2R-DWG-ITS-R3-ZD00E0-5000001
3. QRXP117115-DAH-VORA2R-DWG-ITS-R3-ZD00E0-5000002
4. QRXP117115-DAH-VORA2R-DWG-ITS-R3-ZD00E0-5000005
5. QRXP117115-DAH-VORA2R-DWG-ITS-R3-ZD00E0-5000006
6. QRXP117115-DAH-VORA2R-DWG-ITS-R3-ZD00E0-6000001
7. QRXP117115-DAH-VORA2R-DWG-ITS-R3-ZD00E0-6000002
8. QRXP117115-DAH-VORA2R-DWG-ICT-R3-ZD00E0-2000000

LEGEND:

Rev. No.	Date	Description	Appr.
00	08-11-2025	FOR REVIEW AND APPROVAL	C
01	28-12-2025	FOR REVIEW AND APPROVAL	C
02	04-02-2026	FOR REVIEW AND APPROVAL	C
03	07-05-2026	FOR REVIEW AND APPROVAL	
--	--	--	--
--	--	--	--
--	--	--	--

Consultant
Contractor
ITS Contractor
Project:

Job title: Road Access To Resort Core

Drawing title:
SHOPDRAWING OF TRAFFIC SIGNAL SYSTEM FOR JUNCTION-3
TYPICAL RISER DIAGRAM FOR LPR, RED LIGHT & CCTV CAMERAS


Sheet number:
SHEET 18 / 20

Scale: NTS

Drawn: M.Elsayed | Checked: M.Abuzaid
Designed: | Aoproved:

Drawing number: QRXM114000-HFC-DRW-SDW-ITS-02-RO5-00074
Revision: 03

LPR CAMERA

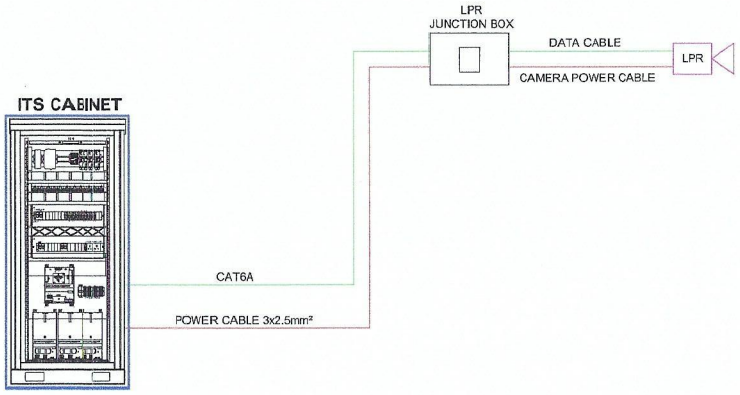


CCTV CAMERA



1.All the work/materials shall be in accordance with project specifications.
2.The storage size shall be sufficient to store data for the specified duration as mentioned in the project specifications.
3..The number of network switches in each ITS cabinet shall be based on the associated field device types.

RED LIGHT CAMERA

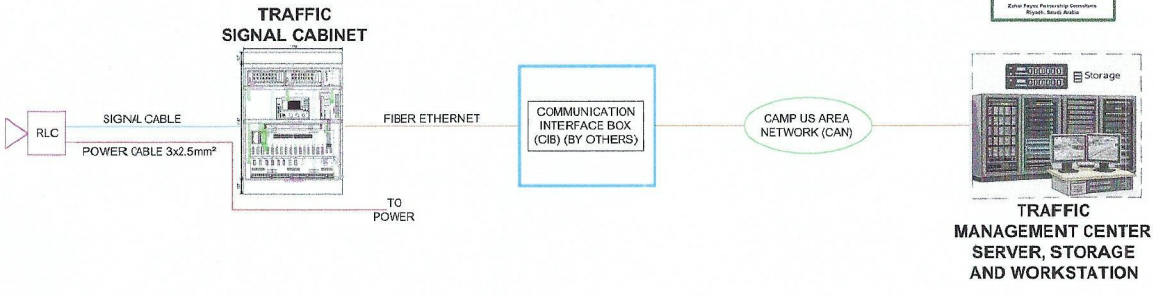

Description	Purpose / Application	Specifications	Storage Size
Server 1 (Server)	ATMS Application, Bus Lane Enforcement Application, Centrax, Red Light Enforcement Application	F6.Vess, A8120 BOX, Memory: 16GB×8, CPU: Silver 4216R×2, M.2 OS, RAID 256GB×2, Ports: 1GbE×4 + 10GbE×2, WS2022, Redundant PSU, Disks: 2×2TB 2.5" SSD	4 TB
Server 2 (Server)	Redundant / Failover Server for Server 1 Applications	F6.Vess, A8120 BOX, Memory: 16GB×8, CPU: Silver 4216R×2, M.2 OS, RAID 256GB×2, Ports: 1GbE×4 + 10GbE×2, WS2022, Redundant PSU, Disks: 2×2TB 2.5" SSD	4 TB
Server 3 (Server &Storage)	Storage Server 1 – Database Storage for 4 Applications in Server 1	F6.Vess, A8120 BOX, Memory: 16GB×8, CPU: Silver 4216R×2, M.2 OS, RAID 256GB×2, Ports: 1GbE×4 + 10GbE×2, WS2022, Redundant PSU, Disks: 4×8TB 3.5" Enterprise HDD	32 TB
Server 4 (Server &Storage)	Storage Server 2 – Backup Storage for the 4 Databases in Storage Server 1	F6.Vess, A8120 BOX, Memory: 16GB×8, CPU: Silver 4216R×2, M.2 OS, RAID 256GB×2, Ports: 1GbE×4 + 10GbE×2, WS2022, Redundant PSU, Disks: 4×8TB 3.5" Enterprise HDD	32 TB
Workstation 1	Operator / Monitoring Workstation	Small Form Factor, Intel Quad-core 3.0 GHz, 16GB DDR3, 1TB HDD, DVD/RW, USB Ports, Ethernet	01 TB
Workstation 2	Operator / Monitoring Workstation	Small Form Factor, Intel Quad-core 3.0 GHz, 16GB DDR3, 1TB HDD, DVD/RW, USB Ports, Ethernet	01 TB

SERVER, STORAGE AND WORKSTATION DETAILS


For Servers specification refer to materials submittal document QRXM114000-HFC-TEC-MAT-ITS-02-RO5-00003

Qiddiya

Consultant's information

HEAD OFFICE - Riyadh
6283 King Abdul Aziz Rd, Ar Rabi
Riyadh 13316 2771, Saudi Arabia
Tel.: +966 11 4048484
Fax : +966 11 4048400
Website : www.zfp.com
Email.: zfpr@zfp.com

Zuhair Fayez Partnership

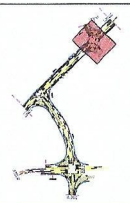

Notes:
1. ALL DIMENSIONS ARE IN MILLIMETER UNLESS OTHERWISE STATED.
2. ALL LEVELS ARE IN METERS UNLESS NOTED OTHERWISE.
3. THIS DRAWINGS IS TO BE READ IN CONJUNCTION WITH ALL RELEVANT ARCHITECTURAL STRUCTURAL AND SERVICES DRAWINGS.

REFERENCE I.F.C DESIGN DRAWING NO:
1. QRXP117115-DAH-VORA2R-DWG-ITS-I3-Z00000-2000003
2. QRXP117115-DAH-VORA2R-DWG-ITS-I3-Z00000-5000001
3. QRXP117115-DAH-VORA2R-DWG-ITS-I3-Z00000-5000002
4. QRXP117115-DAH-VORA2R-DWG-ITS-I3-Z00000-5000005
5. QRXP117115-DAH-VORA2R-DWG-ITS-I3-Z00000-5000006
6. QRXP117115-DAH-VORA2R-DWG-ITS-I3-Z00000-6000001
7. QRXP117115-DAH-VORA2R-DWG-ITS-I3-Z00000-6000002
8. QRXP117115-DAH-VORA2R-DWG-ICT-I3-Z00000-2000000

LEGEND:

Rev. No.	Date	Description	Appr.
00	08-11-2025	FOR REVIEW AND APPROVAL	C
01	28-12-2025	FOR REVIEW AND APPROVAL	C
02	04-02-2026	FOR REVIEW AND APPROVAL	C
03	07-05-2026	FOR REVIEW AND APPROVAL	
--	--	--	--
--	--	--	--
--	--	--	--

Consultant
Contractor
ITS Contractor
Project:

Qiddiya

Job title: Road Access To Resort Core

Drawing title:
SHOPDRAWING OF TRAFFIC SIGNAL SYSTEM FOR JUNCTION-3
TYPICAL RISER DIAGRAM FOR LPR, RED LIGHT & CCTV CAMERAS

Sheet number:
SHEET 18 / 20

Scale: NTS

Drawn: M.Elsayed	Checked: M.Abuzaid
Designed:	Approved:

Drawing number: QRXM114000-HFC-DRW-SDW-ITS-02-RO5-00064
Revision: 03