QIDDIYA DEVELOPMENT COMPANY					
DOCUMENT NUMBER:	QDC-ADM-TEM-QMS-00004	REVISION NUMBER:	OD	ISSUED BY:	PMO
DOCUMENT TITLE	WIR FORM	DOCUMENT TYPE:	FORM	DATE ISSUED:	MAY-08-2022

WORK INSPECTION REQUEST (WIR) FORM

Contractor:	HAIF-FREYSSINET JV
Project:	RA2RC
Contract No.:	QPMO-410-CT-00618
Work Inspection Request Number:	QRXM114000-HFC-TEC-WIR-ITS-02-RO5-00099

HAIF-FREYSSINET JV

Discipline

Architecture	☐	Mechanical	☐	Information Technology	☑	Quality	☐	Project Controls	☐
Civil / Structural	☐	Electrical	☐	Landscape	☐	Safety	☐	Construction Management	☐
Other	☐								

WORK DESCRIPTION

Inspection / Test Location:	INTERIM ROAD Sta. (JUNCTION -1, 2, 3)		
GIS/GPS GeoTag Coordinates (If applicable)			
Inspection Date:	26-Sep-2026	Inspection Start Time:	9:30 am
ITP:	QRXM114000-HFC-TEC-ITP-ITS-02-RO5-00006	Checklist:	HFC-CKL-9003
Spec's / Dwg. Ref.:	QRXM114000-HFC-DRW-SDW-ITS-02-RO5-00048 -58-68	Approved Method Statement Number:	QRXM114000-HFC-TEC-MST-ITS-02-RO5-00001
Attachments:	☑ Drawings ☐ Data Sheets ☐ TQs/RFI ☐ OTHER		

DESCRIPTION OF WORK

Inspection request for Installation of CCTV pole 15mtrs, Junction#1 , 01 pole, Junction#2 , 01 pole and Junction#3 , 01 pole, Total 03 poles, at Access to Resort core interim Road. As per attached drawing.

CONTRACTOR - QUALITY INSPECTOR - INITIAL INSPECTION FINDINGS:

Complies with Approved ITPs/Checklists?	◉ YES ○ NO ○ NA	REMARKS	
All Strucutral Embedded Items Cleared?	○ YES ○ NO ○ NA	WIR Number	
Embedded Electrical items Cleared by Electrical QC?	○ YES ○ NO ○ NA	WIR Number	
Embedded Mechanical Items Cleared by Mechanical QC?	○ YES ○ NO ○ NA	WIR Number	

Accepted:	◉
Accepted with Comments (See Remarks):	○
Rejected (See Remarks):	○

REMARKS:			
Name:	Naseem Ahmad	Signature:	Date: 26/9/26

QIDDIYA / SUPERVISION CONSULTANT QC INSPECTOR - FINAL INSPECTION FINDINGS:

Contractor Has complied with Project spec requirements?	○ YES ○ NO	Okay to Proceed with next activity?	○ YES ○ NO ○ NA

Accepted:	○
Accepted with Comments (See Remarks):	○
Rejected (See Remarks):	○

REMARKS:
- Attached MIR with all Comments on the MAR Complied to.
- Submit Pole verticality survey WIR.
- Submit Anchor bolts & foundation T.O.C survey WIR's.
- QA/QC of the Contractor to Confirm the Torque matches the manufacture's requirements

Name:	Mahmoud	Signature:	Date: 4/10/26

FOR DETAILED MATERIAL INSPECTION STATUS, PLEASE SEE ATTACHED CHECKLIST.
CHECKLISTS THAT ARE NOT ATTACHED AND SIGNED BY SUPERVISION CONSULTANT WILL VOID THIS INSPECTION REQUEST.

This document is the property of Qiddiya Development Company, 2022

Total 3 CCTV Poles

Client:	Consultant:	Contractor:
Qiddiya	Zuhair Fayez Partnership	Haif Company / Freyssinet — HAIF-FREYSSINET JV

TECHNICAL DOCUMENTS

Project Name: Package 3 - **Interim Road Access to Resort Core**	**Project Code:** QRXM114000
Location: 00	**Date:** 22-January-2026
Document Title: **Material Approval Request FOR ITS SYSTEM SUPPLYING & INSTALLING BY TRAFFIC TECH SECURITY W.L.L (**ITS and CCTV Poles**)**	**Ref No:** QRXM114000-HFC-TEC-MAT-ITS-02-RO5-00017
	Rev No: 00

Department: ☐ Architectural ☐ Structural ☐ Electrical ☐ Mechanical ☑ ITS ☐ Civil

Type: ☐ Pre-Qualification ☐ Method Statement ☒ Material Submittal ☐ Sample ☐ Other

Document Description: Material Approval Request FOR ITS SYSTEM SUPPLYING & INSTALLING BY TRAFFIC TECH SECURITY W.L.L (ITS and CCTV Poles)

Doc. Ref. No.	Title
QRXM114000-HFC-TEC-MAT-ITS-02-RO5-00017	**Material Approval Request FOR ITS SYSTEM SUPPLYING & INSTALLING BY TRAFFIC TECH SECURITY W.L.L** (ITS and CCTV Poles)

Enclosure:

Submitted By:	**Received By:**
Name: **Eng. Moataz** Signature: Date: 22-January-2026	Name: Signature: Date:

Below portion for Consultant Supervision use only

Status: ☐A- Approved ☐B- Approved as noted ☐C- Revise & Resubmit ☐R- For information only

Comments:

B: Approved with Comments
Zuhair Fayez Partnership Consultants
Riyadh , Saudi Arabia

1. The mounting heights of all ITS / RWIS / AQM devices shall be in accordance with SHC306, project specification & manufacturers' recommendations to ensure optimal system performance.
2. Structural calculation shall be reviewed by structural engineer.
3. Provide weatherproof, non- degradable heat-resistant rubber to all access doors.
4. Pole specifications shall be as per the pole manufacturer's recommendations.
5. Galvanization & Compliance certificates to be provided at the stage of MIR.
6. All materials shall be in compliance with project specifications and relevant standards

Comments:

B: Approved with Comments
Saud Nawab
Zuhair Fayez Partnership Consultants
Riyadh , Saudi Arabia

Below portion for Client use only

B: Approved with Comments
Zuhair Fayez Partnership Consultants
Riyadh , Saudi Arabia

Signed by: Signature: Date:

QIDDIYA DEVELOPMENT COMPANY					
DOCUMENT NUMBER:	QDC-ADM-TEM-QMS-00007	REVISION NUMBER:	00	ISSUED BY:	PMO
DOCUMENT TITLE:	MIR FORM	DOCUMENT TYPE:	FORM	DATE ISSUED:	MAY-09-2022

Qiddiya

MATERIAL INSPECTION REQUEST (MIR) FORM

Contractor:	HAIF COMPANY
Project:	QPMO-410-CT-00618- ROAD ACCESS TO RESORT CORE
Contract No.:	QI09043311-VO-0004
Material Inspection Request Number:	QRXM114000-HFC-TEC-MIR-ITS-02-RO5-00009

شركة حيف Haif Company — Freyssinet — HAIF-FREYSSINET JV

Discipline

Architecture	☐	Mechanical	☐	Information Technology	☐	Quality	☐	Project Controls	☐
Civil/Structural	☑	Electrical	☐	Landscape	☐	Safety	☐	Construction Management	☐
Other	☐								

MATERIAL DESCRIPTION

Inspection / Test Location:	INTERIM ROAD MAIN LINE-02		
Material Name:	ITS - POLE	Quantity:	13 Pcs.
P.O Number		Delivery Note Number:	TTSDN-HAIF-251225-012-TTS-HAIF DN-0014
Approved Material Transmittal Number: (Aconex document Approval)	QRXM114000-HFC-TEC-MAT-ITS-02-RO5-00017	Approval Date:	
Inspection Date:	02-Apr-2026	Inspection Start Time:	10:30 AM
ITP:		Checklist:	
Spec's / Dwg. Ref.:	TRAFFIC TECH SECURITY W.L.L	Approved Method Statement Number:	
Attachments:	Test Certificate: ◉ Yes ○ No IFC / Shop Drawings: ○ Yes ◉ No		

DESCRITPTION OF MATERIAL

ITS POLE 7Mtrs. (05 Pcs.) ITS POLE 7Mtrs. for RWIS & QMS (02 Pcs.) ITS POLE 6.1 Mtrs. for Red Light Camera (04 Pcs.) ITS POLE 15 Mtrs. for CCTV Camera (01 Pcs.) Traffic Signal Controller Enconolite For J1 (01 Pcs.) Interim Road Main Line-02

CONTRACTOR - QUALITY INSPECTOR - INITIAL INSPECTION FINDINGS:

Are Complete Details Mentioned in P.O and Delivery Note?	◉ YES ○ NO	REMARKS	
Complies with Approved ITPs/Checklists?	◉ YES ○ NO	REMARKS	
Signs of Physcial Damage?	○ YES ◉ NO	REMARKS	
Conforms to Approved Material Submittal?	○ YES ○ NO	REMARKS	

Accepted:	◉
Accepted with Comments:	○
Rejected (See Remarks):	○

REMARKS:					
Name:	Moataz Elkhateeb	Signature:		Date:	02-04-2026

QIDDIYA / SUPERVISION CONSULTANT QC INSPECTOR - FINAL INSPECTION FINDI

Contractor Has complied with Material requirements?	○ YES ○ NO
Accepted:	
Accepted with Comments:	✓
Rejected (See Remarks):	○

B: Approved with Comments
QI09043311-GPR TR-17&TR05
Saud Nawab
Zuhair Fayez Partnership Consultants
Riyadh , Saudi Arabia

ctly? ○ YES ○ NO ○ NA

REMARKS:	① Attach approved ITP. ② Comply with the comments mentioned on attached supporting documents.				
Name:	M. YASIR.	Signature:		Date	02/04/2026

FOR DETAILED MATERIAL INSPECTION STATUS, PLEASE SEE ATTACHED CHECKLIST.
CHECKLISTS THAT ARE NOT ATTACHED AND SIGNED BY SUPERVISION CONSULTANT WILL VOID THIS INSPECTION REQUEST.

This document is the property of Qiddiya Development Company, 2022

Client:	Consultant:	Contractor:
Qiddiya	Zuhair Fayez Partnership	Hail Company / Freyssinet / HAIF-FREYSSINET JV

TECHNICAL DOCUMENTS

Project Name: Package 3 - Interim Road Access to Resort Core	**Project Code:** QRXM114000
Location: 00	**Date:** 4 -June-2026
Document Title: **Inspection & Test Plan for Inteligent Transportation System Works for TRAFFIC SIGNAL SYSTEM**	**Ref No:** QRXM114000-HFC-TEC-ITP-ITS-00006
	Rev No: 00

Department: ☐ Architectural ☐ Structural ☒ Electrical ☐ Mechanical ☐ Authority ☐ Civil

Type: ☐ Pre-Qualification ☐ Method Statement ☐ Material Submittal ☐ Sample ☒ ITP

Document Description: This is Inspection&Test Plan for Inspection&Test Plan for Inteligent Transportation system Works for TRAFFIC SIGNAL SYSTEM

Doc. Ref. No.	Title
QRXM114000-HFC-TEC-ITP-ITS-00006	**Inspection&Test Plan for Inteligent Transportation system Works for TRAFFIC SIGNAL SYSTEM**

Enclosure:

Submitted By:	**Received By:**
Name: Eng. Moataz Signature: Date: 4 -June-2026	Name: Signature: Date:

Below portion for Consultant Supervision use only

Status: ☐A- Approved ☐B- Approved as noted ☐C- Revise & Resubmit ☐R- For information only

Comments: All the work shall be carried out inaccordance with project specification, relevant standards & codes and manufacturer recommendations.

A: Approved
Zuhair Fayez Partnership Consultants
Riyadh , Saudi Arabia

A: Approved
Zuhair Fayez Partnership Consultants
Riyadh , Saudi Arabia

A: Approved
Zuhair Fayez Partnership Consultants
Riyadh , Saudi Arabia

Below portion for Client use only

Comments:

Signed by: Signature: Date:

HAIF-FSA JV Inspection & Test Plan									
Inteligent Transportation System Works for TRAFFIC SIGNAL SYSTEM					I &TP	APPROVED DATE	**DISCIPLINE ITS**		
PROJECT TITLE:WBS Access Road To Resort Core (RA2RC)					**HFC-ITP-090**				
WIR No.					CONTRACTOR/SUBCONTRACTOR				
					CONSTRUCTION- Intelligent Transportation System Works for TRAFFIC SIGNAL SYSTEM		HAIF		
ITEM NO.	PROJECT PHASE	TASK / ACTIVITY	Quality Requirements /references/ specifications	Quality Record	INSPECTION RESPONSIBILITY ASSIGNMENTS			REMARKS	
					Contractor	Third Party	Consultant		
1.0 DOCUMENT REVIEW									
1.7		Material Approval & Shop Drawing - Vehicle Video Detection System	QRXP117115-DAH-VORA2R-SPE-INF-R1-Z00000-000001-0B Section 137714 VEHICLE DETECTION SYSTEM IFC Drawing QRXP117115-DAH-VORA2R-DWG-GEN-R3-Z00000-5000006	QRXM114000-HFC-TEC-MAT-ITS-02-R05-00010 Material Approval Request for VEHICLE VIDEO DETECTION SYSTEM Approved SHOP DRAWINGS: QRXM114000-HFC-DRW-SDW-ITS-02-R05-00019-R02 QRXM114000-HFC-DRW-SDW-ITS-02-R05-00031-R01 QRXM114000-HFC-DRW-SDW-ITS-02-R05-00044-R01	R		H		
2.0 MATERIAL RECEIVING INSPECTION									
2		Material receiving inspection, protection & storage	QD0002-ADM-TEM-QMS00007[0A] MaterialReceiving Inspection in site HFC-CKL-9001	QD0002-ADM-TEM-QMS00007[0A] MaterialReceivingInspection in site HFC-CKL-9001	H		H	MIR to be submitted	
3.0 WORK INSTALLATION									
3.1		PRE - INSTALLATION	HFC-CKL-9002	HFC-CKL-9002	H		H		
3.2		INSTALLATION	HFC-CKL-9003	HFC-CKL-9003	H		H		
3.3		TESTING	HFC-CKL-9004	HFC-CKL-9004	H		H		

GENERAL NOTES	
1	Surveillance: QA/QC organization to monitor work in progress without notice from Construction Organization
2	Witness: QA/QC organization shall be notified of the timing of Inspection or test in advance. However, the inspection or test shall be performed as scheduled if the QA/QC organization representative is not present
3	Hold: QA/QC organization shall be notified of the timing of inspection or test in advance. Inspection or test shall not be carried out without the QA/QC organization representative in attendance.
4	If the Main Contractor delegates the assigned responsibility to the Subcontractor, then the Main Contractor will have the same degree of responsibility as assigned to Consultant.

LEGEND			
H	Hold Point for QC Inspection/ Test	R	Review of Documents
W	Witness Inspection/T	RH	Review & approval of Documents
S	Surveillance		

Checklist : HFC-CKL-9003

INSTALLATION OF TRAFFIC SIGNAL SYSTEM	Checklist	APPROVED DATE	DISCIPLINE
PROJECT TITLE: Road Access To Resort Core (RA2RC)	HFC-CKL-9003		ITS
WIR No.	WBS	CONTRACTOR/SUBCONTRACTOR	
	CONSTRUCTION- Intelligent Transportation System Works for INSTALLATION AND OPERATION of TRAFFIC SIGNAL SYSTEM	HAIF	


ITEM NO.	Check Points & Acceptance Criteria	Reference	Pass	Fail	Not Applicable	Re-Inspection
1.0	**INSTALLATION OF TRAFFIC SIGNAL SYSTEM - EMERGENCY VEHICLE PRE-EMPTION SYSTEM (EVPS)**					
ITEM NO.	**Check Points & Acceptance Criteria**	**Reference**	**Pass**	**Fail**	**Not Applicable**	**Re-Inspection**
6.0	**INSTALLATION OF TRAFFIC SIGNAL SYSTEM - TRAFFIC SIGNAL POLE & GANTRIES**					
6.1	Are all Shop Drawings, Method Statement and Material Submittals were approved ?	SHC 306 SECTION 12.TRAFFIC SIGNALS, 12.2.2.SUPPORTING STRUCTURE SPECIFICATIONS	✓			
6.2	Are all TRAFFIC SIGNAL POLE AND GANTRIES installed as per approved Material Submittals?	SHC 306 SECTION 12.TRAFFIC SIGNALS, 12.2.2.SUPPORTING STRUCTURE SPECIFICATIONS	✓			
6.3	Are all TRAFFIC SIGNAL POLE AND GANTRIES material quantity as per approved Material Submittals and Shop Drawings?	SHC 306 SECTION 12.TRAFFIC SIGNALS, 12.2.2.SUPPORTING STRUCTURE SPECIFICATIONS	✓			
6.4	Is installation performed in accordance with the applicable standards, requirements, manufacturers' guidelines and any authorities having jurisdiction	SHC 306 SECTION 12.TRAFFIC SIGNALS, 12.2.2.SUPPORTING STRUCTURE SPECIFICATIONS	✓			
6.5	Setting out and installation of foundations were installed as per approved Shop Drawings?	SHC 306 SECTION 12.TRAFFIC SIGNALS, 12.2.2.SUPPORTING STRUCTURE SPECIFICATIONS	✓			
6.6	Are the Poles/Gantries were tightened, and fixed on the foundation's anchor bolts?	SHC 306 SECTION 12.TRAFFIC SIGNALS, 12.2.2.SUPPORTING STRUCTURE SPECIFICATIONS	✓			
6.7	Are the Poles/Gantries leveled and plumbed?	SHC 306 SECTION 12.TRAFFIC SIGNALS, 12.2.2.SUPPORTING STRUCTURE SPECIFICATIONS	✓			
6.8	Are the serial numbers of test report verified andmatching with material	SHC 306 SECTION 12.TRAFFIC SIGNALS, 12.2.2.SUPPORTING STRUCTURE SPECIFICATIONS	✓			

Remarks


PM/Contractor			QDC		
Contractor Construction			Third Party (if applicable)		
The work is ready for inspection			Document Reviewed	Work Inspected	Test Records Verified
Name	Signature	Date	Name	Signature	
Contractor QC Inspector		26/9/26	QDC Supervision Consultant		


Form Ref. No. QD0002-ADM-TEM-QTY-00003– Rev.0A

Naseem Ahmed Naseem Ahmed 26/6/26 Mahmoud 4/10/26

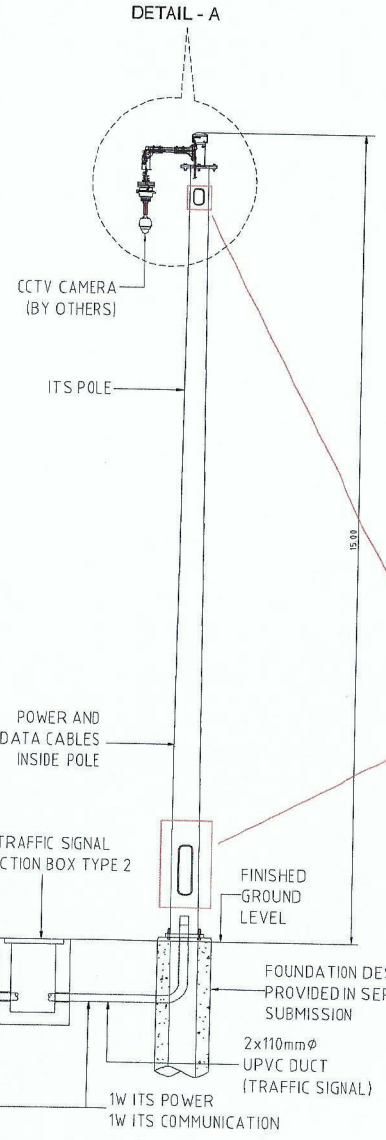

15M ITS POLE
CCTV

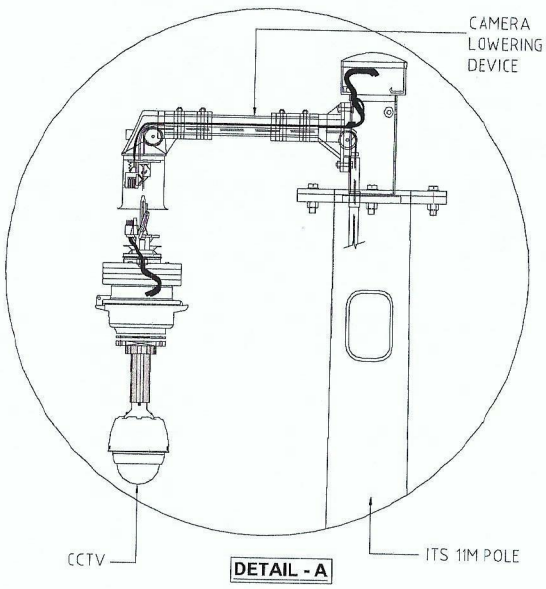


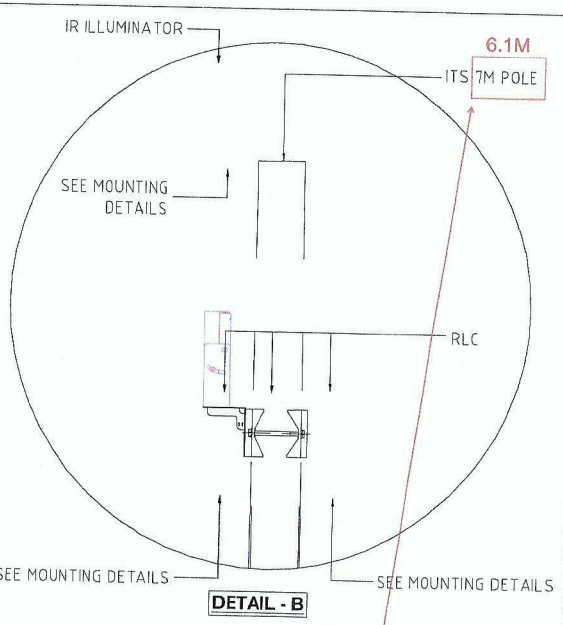

Devices mounting height shall be as per the manufacturer's recommendation and site conditions to achieve optimal performance



Provide non-degradable heat resistant rubber gasket to the access door

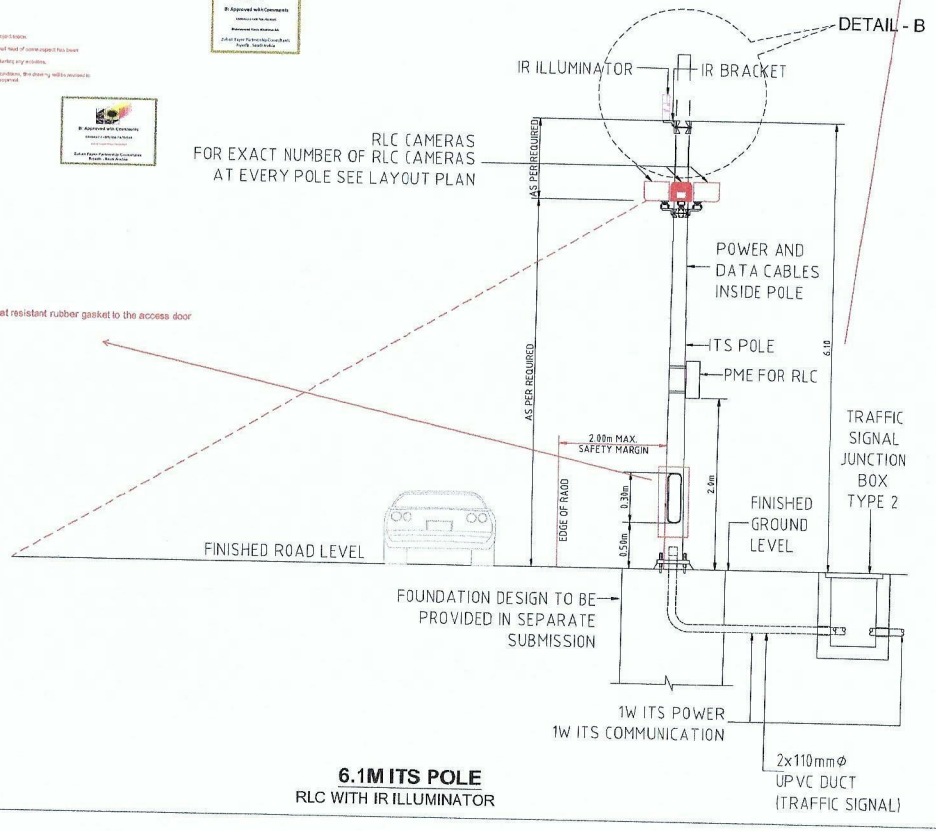


6.1M ITS POLE
RLC WITH IR ILLUMINATOR

القديـــة
Qiddiya

Consultant's information

HEAD OFFICE - Riyadh
6283 King Abdul Aziz Rd, Ar Rabi
Riyadh 13316 2771, Saudi Arabia
Tel.: +966 11 4048484
Fax : +966 11 4048400
Website : www.zfp.com
Email.: zfpr@zfp.com


Zuhair Fayez Partnership

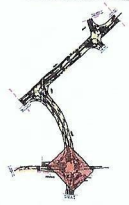

Notes:
1. ALL DIMENSIONS ARE IN MILLIMETER UNLESS OTHERWISE STATED.
2. ALL LEVELS ARE IN METERS UNLESS NOTED OTHERWISE.
3. THIS DRAWING IS TO BE READ IN CONJUNCTION WITH ALL RELEVANT ARCHITECTURAL, STRUCTURAL AND SERVICES DRAWINGS.

REFERENCE I.F.C DESIGN DRAWING NO:
1. QRJP117115-DAH-VORA2R-DWG-ITS-R3-Z00000-2000001
2. QRJP117115-DAH-VORA2R-DWG-ITS-R3-Z00000-5000001
3. QRJP117115-DAH-VORA2R-DWG-ITS-R3-Z00000-5000005
4. QRJP117115-DAH-VORA2R-DWG-ITS-R3-Z00000-5000006
5. QRJP117115-DAH-VORA2R-DWG-ITS-R3-Z00000-6000001
6. QRJP117115-DAH-VORA2R-DWG-ICT-R3-Z00000-2000000

LEGEND:

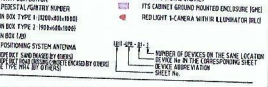

Rev. No.	Date	Description	Appr.
00	06-10-2025	FOR REVIEW AND APPROVAL	B
01	04-11-2025	FOR REVIEW AND APPROVAL	
---	---	---	---
---	---	---	---
---	---	---	---
---	---	---	---
---	---	---	---
---	---	---	---

Consultant
Contractor
Hail Company
ITS Contractor
TRAFFIC TECH
Project:
القديـــة Qiddiya

Job title: Road Access To Resort Core


Drawing title:
SHOPDRAWING OF TRAFFIC SIGNAL SYSTEM FOR JUNCTION-1

Sheet number:
SHEET 10 / 16


Scale: NTS


Drawn: M.Sayed | Checked: M.Sayed
Designed: | Approved:


Drawing number: QRXM114000-HFC-DRW-SDW-ITS-02-R05-00048
Revision 01

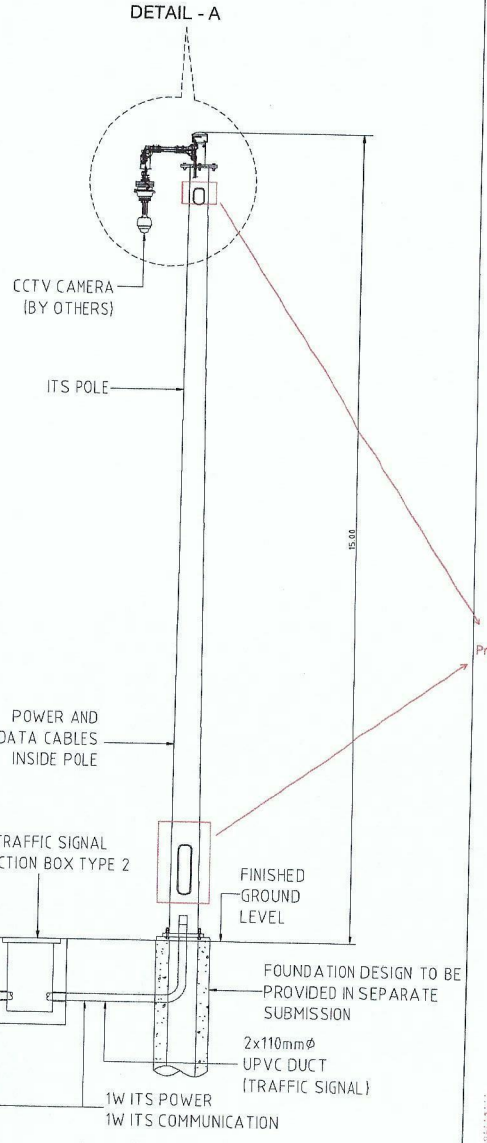

15M ITS POLE
CCTV

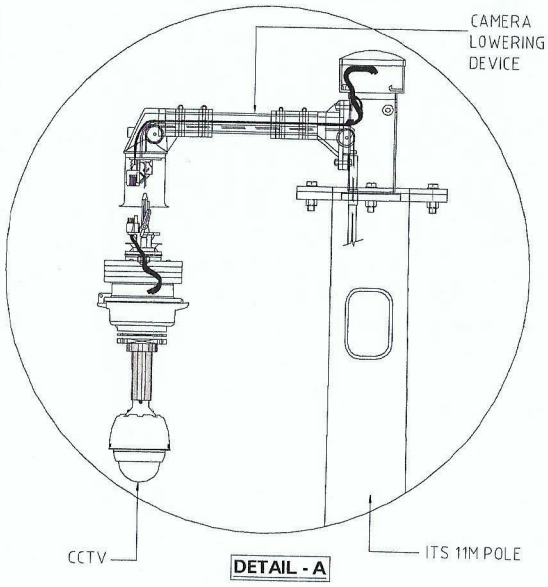

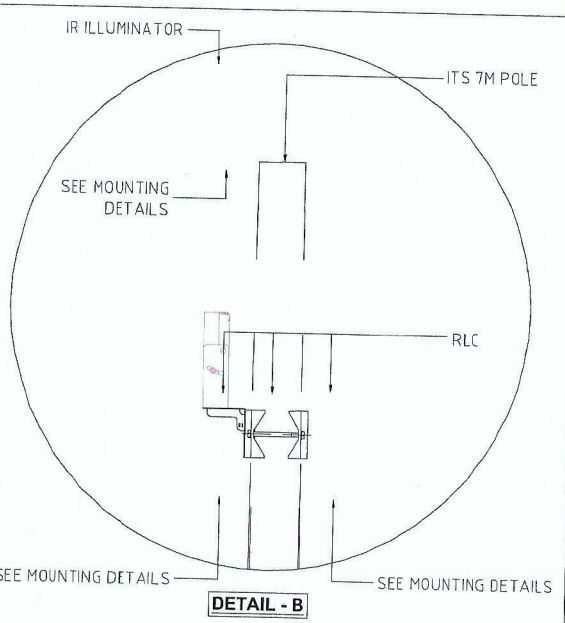

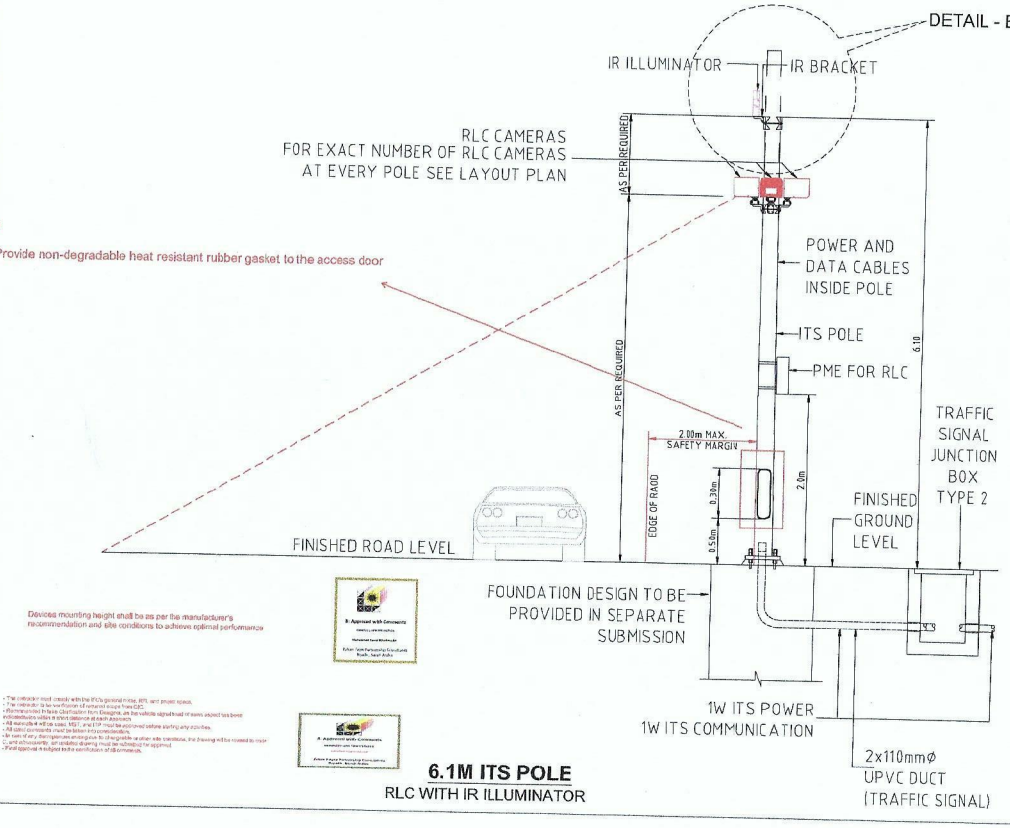

Devices mounting height shall be as per the manufacturer's recommendation and site conditions to achieve optimal performance


6.1M ITS POLE
RLC WITH IR ILLUMINATOR

القديـــة
Qiddiya

Consultant's information

HEAD OFFICE - Riyadh
6283 King Abdul Aziz Rd, Ar Rabi
Riyadh 13316 2771, Saudi Arabia
Tel.: +966 11 4048484
Fax : +966 11 4048400
Website : www.zfp.com
Email.: zfpr@zfp.com

Zuhair Fayez Partnership

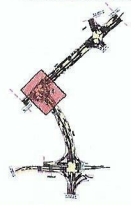

Notes:
1. ALL DIMENSIONS ARE IN MILLIMETER UNLESS OTHERWISE STATED.
2. ALL LEVELS ARE IN METERS UNLESS NOTED OTHERWISE.
3. THIS DRAWINGS IS TO BE READ IN CONJUNCTION WITH ALL RELEVANT ARCHITECTURAL, STRUCTURAL AND SERVICES DRAWINGS.

REFERENCE I.F.C DESIGN DRAWING NO:
1. QRXP117115-DAH-VORA2R-DWG-ITS-R3-Z00000-2000002
2. QRXP117115-DAH-VORA2R-DWG-ITS-R3-Z00000-5000001
3. QRXP117115-DAH-VORA2R-DWG-ITS-R3-Z00000-5000002
4. QRXP117115-DAH-VORA2R-DWG-ITS-R3-Z00000-5000005
5. QRXP117115-DAH-VORA2R-DWG-ITS-R3-Z00000-5000006
6. QRXP117115-DAH-VORA2R-DWG-ITS-R3-Z00000-5000001
7. QRXP117115-DAH-VORA2R-DWG-ITS-R3-Z00000-6000002
8. QRXP117115-DAH-VORA2R-DWG-ICT-R3-Z00000-2000000

LEGEND:

Rev. No.	Date	Description	Appr.
00	04-11-2025	FOR REVIEW AND APPROVAL	--
--	--	--	--
--	--	--	--
--	--	--	--
--	--	--	--
--	--	--	--
--	--	--	--

Consultant
Contractor
Hail Company
ITS Contractor
TRAFFIC TECH
Project:
القديـــة Qiddiya

Job title: Road Access To Resort Core


Drawing title:
SHOPDRAWING OF TRAFFIC SIGNAL SYSTEM FOR JUNCTION-2
TYPICAL STANDARD DETAIL OF ITS POLE CCTV & RLC WITH IR ILLUMINATOR

Sheet number: SHEET 11 / 19


Scale: NTS


Drawn: M.Sayed | Checked: M.Sayed
Designed: | Approved:

Drawing number: QRXM114000-HFC-DRW-SDW-ITS-02-RO5-00058
Revision: 00

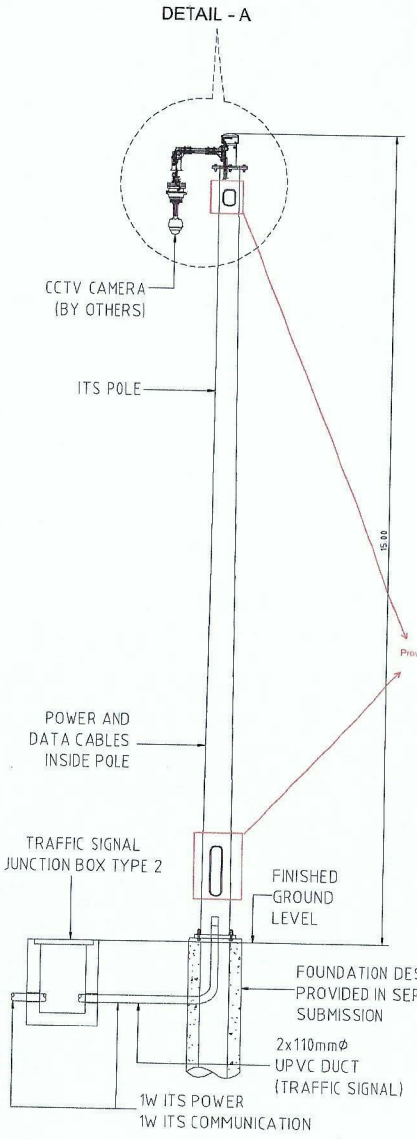


15M ITS POLE
CCTV

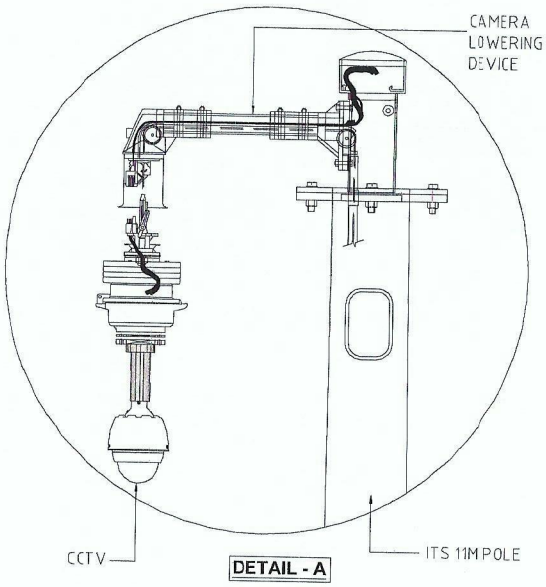

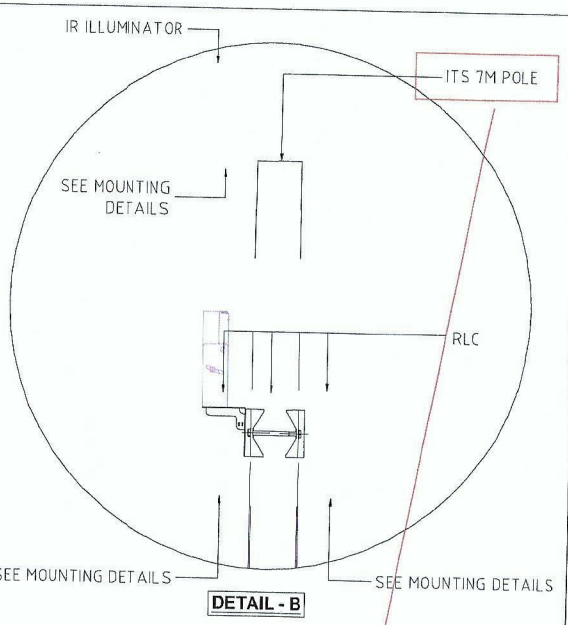

Devices mounting height shall be as per the manufacturer's recommendation and site conditions to achieve optimal performance


Provide non-degradable heat resistant rubber gasket to the access door

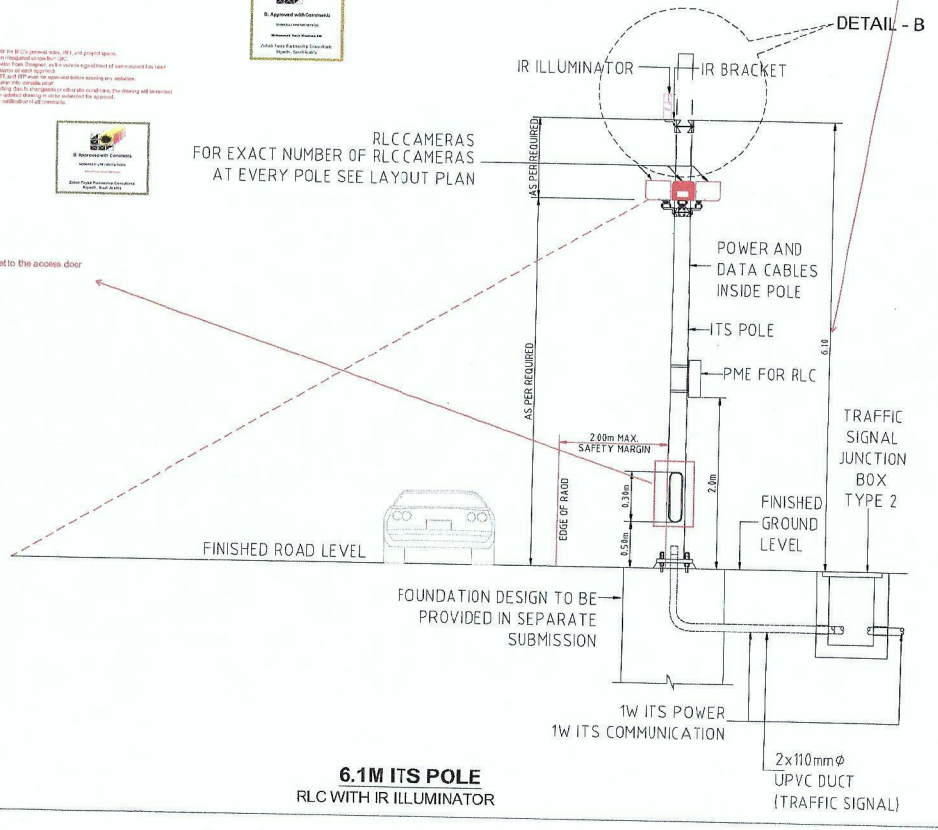

6.1M ITS POLE
RLC WITH IR ILLUMINATOR

Qiddiya

Consultant's Information
HEAD OFFICE - Riyadh
6283 King Abdul Aziz Rd, Ar Rabi
Riyadh 13316 2771, Saudi Arabia
Tel.: +966 11 4048484
Fax : +966 11 4048400
Website : www.zfp.com
Email.: zfpr@zfp.com
Zuhair Fayez Partnership

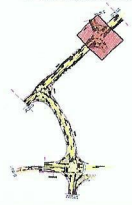

Notes:
1. ALL DIMENSIONS ARE IN MILLIMETER UNLESS OTHERWISE STATED.
2. ALL LEVELS ARE IN METERS UNLESS NOTED OTHERWISE.
3. THIS DRAWINGS IS TO BE READ IN CONJUNCTION WITH ALL RELEVANT ARCHITECTURAL, STRUCTURAL AND SERVICES DRAWINGS.

REFERENCE I.F.C DESIGN DRAWING NO:
1. QRXP117115-DAH-V0RA2R-DWG-ITS-R3-Z00000-2000003
2. QRXP117115-DAH-V0RA2R-DWG-ITS-R3-Z00000-5000001
3. QRXP117115-DAH-V0RA2R-DWG-ITS-R3-Z00000-5000002
4. QRXP117115-DAH-V0RA2R-DWG-ITS-R3-Z00000-5000005
5. QRXP117115-DAH-V0RA2R-DWG-ITS-R3-Z00000-5000006
6. QRXP117115-DAH-V0RA2R-DWG-ITS-R3-Z00000-6000001
7. QRXP117115-DAH-V0RA2R-DWG-ITS-R3-Z00000-6000002
8. QRXP117115-DAH-V0RA2R-DWG-ICT-R3-Z00000-2000000

LEGEND:

Rev. No.	Date	Description	Appr.
00	08-11-2023	FOR REVIEW AND APPROVAL	
--	--	--	--
--	--	--	--
--	--	--	--
--	--	--	--
--	--	--	--
--	--	--	--

Consultant
Contractor
Hail Company
ITS Contractor
TRAFFIC
Project:
Qiddiya

Job title: Road Access To Resort Core

Drawing title:
SHOPDRAWING OF TRAFFIC SIGNAL SYSTEM FOR JUNCTION-3
TYPICAL STANDARD DETAIL OF ITS POLE CCTV & RLC WITH IR ILLUMINATOR

Sheet number:
SHEET 12 / 20

Scale: NTS

Drawn: M.Sayed | Checked: M.Sayed
Designed: | Approved:

Drawing number: QRXM114000-HFC-DRW-SDW-ITS-02-R05-00068
Revision 00

CCTV - JN 01			
PO	North	East	Elevation
1	2719235.946	632176.886	658.363
2	2719236.939	632175.782	658.354
3	2719235.831	632174.804	658.383
4	2719234.819	632175.894	658.367

CCTV - JN 02			
PO	North	East	Elevation
1	2719500.534	632084.461	661.043
2	2719500.976	632083.367	661.041
3	2719499.606	632082.833	661.021
4	2719499.166	632083.922	661.022

CCTV - JN 03			
PO	North	East	Elevation
1	2719615.559	632201.7508	661.95
2	2719614.497	632202.8107	661.949
3	2719613.437	632201.7495	661.949
4	2719614.498	632200.6894	661.95